

Please add a sketch for lifting the bundle.

Please specify and show the support of cable tray for vibration switch. (The cable route will be specified for vendor)

TABLE: Joint Reactions

Joint	OutputCase	Fx	Fy	Fz
Text	Text	Kgf	Kgf	Kgf
A-1	DEAD S	16.65	45	861.98
A-1	DEAD	49.34	-158.83	1640.14
A-1	DEAD OP	4.08	-14.37	92.37
A-1	DEAD N	-1631.93	429.16	-2881.5
A-1	LIVE	3.34	25.54	1383.73
A-1	WX	31.57	329.34	-352.72
A-1	WY	-387.76	93.94	-669.09
A-1	SNOW	9.74	-24.99	547.61
A-1	EQX	106.43	1146.34	-1764.17
A-1	EQY	-1561.76	337	-3289.21
A-1	EQZO	210.24	2295.43	-3529.78
A-1	EQYO	-3123.79	673.24	-6571.39
A-2	DEAD S	-20.6	1.599E-13	380.54
A-2	DEAD	-33.06	-0.0000289	811.07
A-2	DEAD OP	-0.21	-3.963E-07	55.27
A-2	DEAD N	-10.59	-1.13	-378.95
A-2	LIVE	-76.47	6.353E-13	402.18
A-2	WX	1.165E-12	49.87	8.288E-13
A-2	WY	-54.91	-1.269E-13	-353.83
A-2	SNOW	-19.58	-8.653E-07	221.21
A-2	EQX	0.004107	45.8	0.09216
A-2	EQY	-48.82	-0.38	-1465.12
A-2	EQZO	0.00889	92.7	0.18
A-2	EQYO	-98.54	-0.78	-2927.34
A-3	DEAD S	16.65	45	861.98
A-3	DEAD	49.34	158.83	1640.17
A-3	DEAD OP	4.08	14.37	92.37
A-3	DEAD N	39.17	235.02	482.86
A-3	LIVE	3.34	-25.54	1383.73
A-3	WX	-31.57	329.34	352.72
A-3	WY	387.76	-93.94	669.09
A-3	SNOW	9.74	24.99	547.61
A-3	EQX	-106.49	1146.49	1764.07
A-3	EQY	-1071.77	-428.48	-2570.23
A-3	EQZO	-210.36	2295.75	3529.6
A-3	EQYO	-2144	-856.2	-5134.3
B-1	DEAD S	34.11	-1.44	482.68
B-1	DEAD	174.23	-2.24	983.92
B-1	DEAD OP	16.3	0.03128	81.45
B-1	DEAD N	-670.87	1.33	2555.04
B-1	LIVE	-43.74	-6.51	64.14
B-1	WX	255.25	0.99	-374.63
B-1	WY	-1.33	-70.96	504.74
B-1	SNOW	24.65	-1.56	193.87
B-1	EQX	-985.73	4.1	-1834.5
B-1	EQY	-51.12	-28.6	2619.38
B-1	EQZO	-1968.03	8.18	-3658.39
B-1	EQYO	-102.38	-57.85	5233.15
B-2	DEAD S	-3.76E-15	-9.82	342.79
B-2	DEAD	-1.168E-10	-61.15	847.79
B-2	DEAD OP	-1.602E-11	-8.01	77.09
B-2	DEAD N	-0.0003857	-403.24	720.08
B-2	LIVE	8.844E-15	82.81	-147.91
B-2	WX	-56.07	3.583E-12	-6.399E-12
B-2	WY	-8.004E-14	-439.42	682.53
B-2	SNOW	-3.498E-11	3.21	131.34
B-2	EQX	0.02819	0.04229	-0.07544
B-2	EQY	0.006383	-1570.51	2804.88
B-2	EQZO	-0.2	0.08416	-0.15
B-2	EQYO	0.0007535	-3138.25	5603.81
B-3	DEAD S	-34.11	-1.44	482.68
B-3	DEAD	174.23	-2.24	983.92
B-3	DEAD OP	-16.3	0.03128	81.45
B-3	DEAD N	-670.07	1.26	1104.47
B-3	LIVE	43.74	-6.51	64.14
B-3	WX	-255.25	-0.99	374.63
B-3	WY	1.33	-70.96	504.74
B-3	SNOW	-24.65	-1.56	193.87
B-3	EQX	-985.8	-4.09	1834.58
B-3	EQY	-40.75	-28.68	1900.29
B-3	EQZO	-1968.16	-8.15	3658.54
B-3	EQYO	-81.36	-57.83	3796.07

- NOTES:**
- Loading Data
WIND :ASCE7-16,VELOCITY :125km/h, EXPOSURE : C
Earthquake: Standard No. 2800,A=0.3,B=2.75,I=1.4,R=3.5,SOIL TYPE=IV
 - Fans
-100% AP(Adjustable pitch-manual)
 - Miscellaneous
- The Inlet Header Boxes Are Fixed In The Direction Of Fin Tubes, Refer To Table For The Lateral Displacement In Y Direction
- Flange Face Detail : ASME ANSI B16.5
 - All Dimensions Are In Millimeter Unless Otherwise Specified.
 - All Dimensions Tolerances Are According to API 661.(Figure 10)
 - Bolts which are used for fixing headers to side frame , on sliding side should be removed after erection.
 - PROTECTION(SEE Galvanizing Specification and Inspection Procedure: EI027-DMF-VD-QC-PRO-024
 - RADIOGRAPHIC TEST (FULL/SPOT) SHALL BE IN COMPLIANCE WITH THE REQUIREMENTS OFASME SEC. VIII DIV.1 UW-11 & UW-12.
 - 50% motors per unit to be VFD. **Repetitive comment: Please add the below also: All motors to be VFD compatible***


LOAD DATA

LOAD	DESCRIPTION	UNIT
DEAD	DEAD LOAD(PLENUMS+FAN RINGS+FAN GRATING+TUBES+HEADERS+WALKWAY+TUBE BUNDLE EMPTY)+HEADER WALK WAY	
DEAD OP	WEIGHT OF LIQUID WITHIN EACH TUBE BUNDLE& STEAM COIL(WATER)	
DEAD S	SELF WEIGHT OF STRUCTURE	
DEAD N	NOZZEL LOAD	
LIVE	WALKWAY LOAD 250 Kg/m2	
EQX	SEISMIC LOAD DIR.X	
EQY	SEISMIC LOAD DIR.Y	
WX	WIND LOAD DIR.X	
WY	WIND LOAD DIR.Y	
SNOW	66 Kg/m2	

* Further Definition Check the Steel Structure Calculation.Doc No.: EI027-DMF-VD-ST-CAL-004
1158-A01-0030-00

THE MAXIMUM ALLOWABLE MOMENTS AND FORCES PER EACH NOZZLE (IF LOADS ARE DIVIDED EQUALLY FOR NOZZLES ACCORDING TO 3xAPI 661(7.1.10.1))

SIZE	Fx(N)	Fy(N)	Fz(N)	Mx(N.m)	My(N.m)	Mz(N.m)
4"	10020	8010	10020	2430	3660	2430
2"	3060	3990	3060	450	720	450

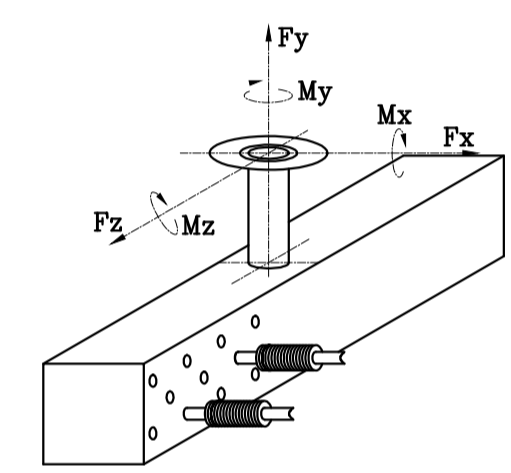

please remove schedule for LWN nozzle

CONNECTIONS

NO.	REP.	QTY. PER BAY/UNIT	DIA	DESIGNATION
N1	INLET NOZZLE/FLANGE	1/2	4"	FLANGE ANSI B16.5,300LWN,SA-350 LF2 CL1 N,THK=14.3
N2	OUTLET NOZZLE/FLANGE	1/2	2"	FLANGE ANSI B16.5,300LWN,SA-350 LF2 CL1 N,THK=14.3
V1&V2	VENT	2/4	1"	FLANGE ANSI B16.5,300LWN,SA-350 LF2 CL1 N,THK=14.3
D1&D2	DRAIN	2/4	1"	FLANGE ANSI B16.5,300LWN,SA-350 LF2 CL1 N,THK=14.3
1A	VIBRATION SWITCH	2/4	-	SEE FAN DRIVE ASSEMBLY DRAWING
2A	MOTOR(7.5Kw)	2/4	-	SEE FAN DRIVE ASSEMBLY DRAWING
3A	FAN	2/4	7ft	SEE FAN DRIVE ASSEMBLY DRAWING

LATERAL DISPLACEMENT OF HEADERS (DIRECTION X) INSIDE BUNDLE FRAME IN RELATION WITH EXPANSION FORCES ON NOZZLES (mm) (ACCORDING TO API661 7-1-1-2)

MAXIMUM DISPLACEMENT INLET/OUTLET : ±9

* FOR MORE DETAILS FOR EACH COMPONENT OF AIR COOLER REFER TO BELOW DRAWING & DOCUMENTS.

REFERENCED DWG&DOC.

TITLE	VENDOR DOCUMENT NO.	CLIENT DOCUMENT NO.
Tube Bundle Drawing	1158-A01-2000-00	EI027-DMF-VD-ME-DWG-025
Bundle Frame Drawing	1158-A01-2400-00	EI027-DMF-VD-ME-DWG-007
Fan Drive Assembly Drawing	1158-A01-6000-00	EI027-DMF-VD-ME-DWG-008
Fan Ring Drawing	1158-A01-5067-00	EI027-DMF-VD-ME-DWG-009
Support Mechanism Drawing	1158-A01-5167-00	EI027-DMF-VD-ME-DWG-010
Plenum Drawing	1158-A01-5110-00	EI027-DMF-VD-ME-DWG-011
Steel Structure Drawing	1158-A01-1100-00	EI027-DMF-VD-ST-DWG-013
Header Walkway Drawing	1158-A01-1200-00	EI027-DMF-VD-ST-DWG-014
Ladder Drawing	1158-A01-1320-00	EI027-DMF-VD-ST-DWG-015
Surface Preparation and Painting Procedure for Air Cooler	1158-A01-Q501-00	EI027-DMF-VD-QC-PRO-024

REV	DATE	DESCRIPTION	DRAWN BY	CHECKED BY	APPROVED BY	FINAL APPROVED BY
R3	08/21/2024	ISSUED FOR APPROVAL	F.SZ	J.M.	J.B.L.	A.GHZ
R2	08/10/2024	ISSUED FOR APPROVAL	F.SZ	J.M.	J.B.L.	A.GHZ
R1	07/22/2024	ISSUED FOR APPROVAL	F.SZ	J.M.	J.B.L.	A.GHZ
RO	06/30/2024	ISSUED FOR APPROVAL	F.SZ	J.M.	J.B.L.	A.GHZ

CLIENT:

PROJECT: AIR COOLER FOR

CLIENT: **ENBR TEKNOLOJI**

CLIENT: **ati Gohar Ofogh Petrochemical Co.**

CLIENT: **al Arrangement Drawing**

CLIENT: **158-A01-1000-00**

DWG. NO.: EI027-DMF-VD-ME-DWG-003

SCALE: N.T.S. **SIZE:** A1 **REV.:** R3

CLIENT: **ati Gohar Ofogh Petrochemical Co.**

CLIENT: **al Arrangement Drawing**

CLIENT: **158-A01-1000-00**

CLIENT: **ENBR TEKNOLOJI**

CLIENT: **ati Gohar Ofogh Petrochemical Co.**

CLIENT: **al Arrangement Drawing**

CLIENT: **158-A01-1000-00**

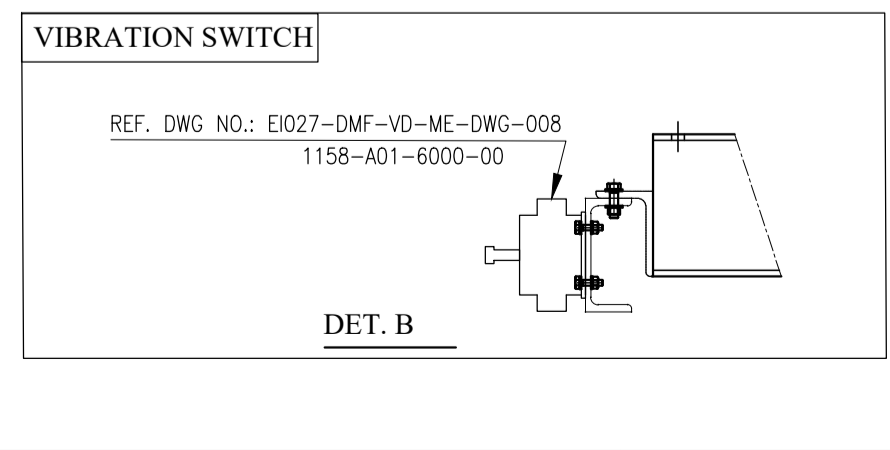
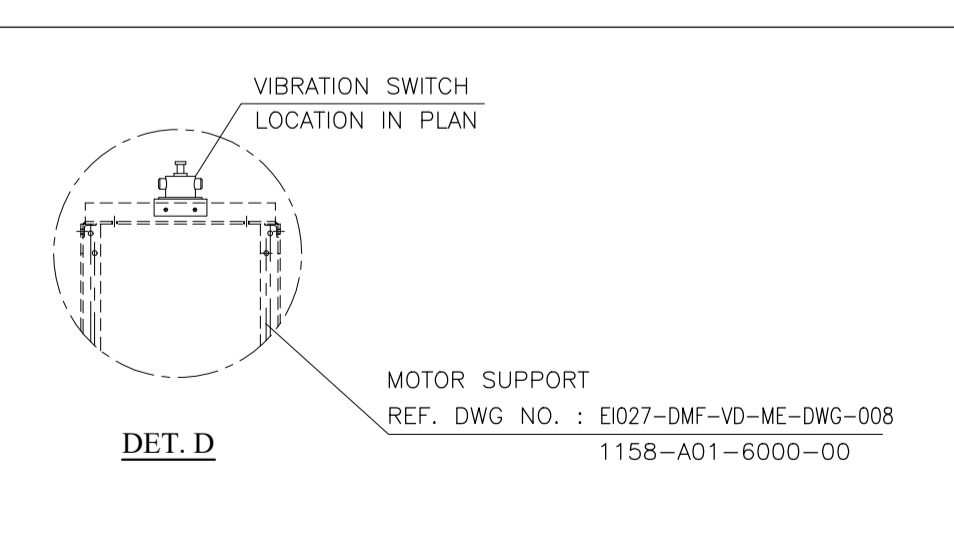
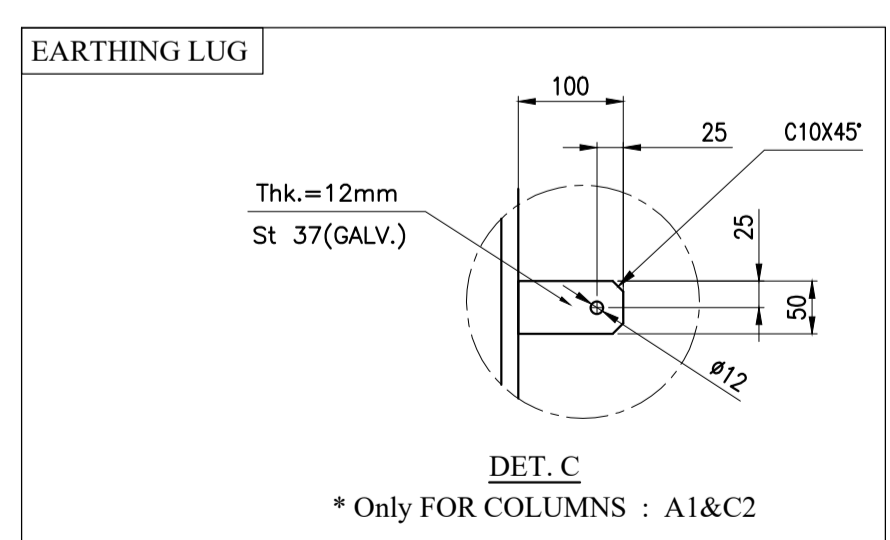
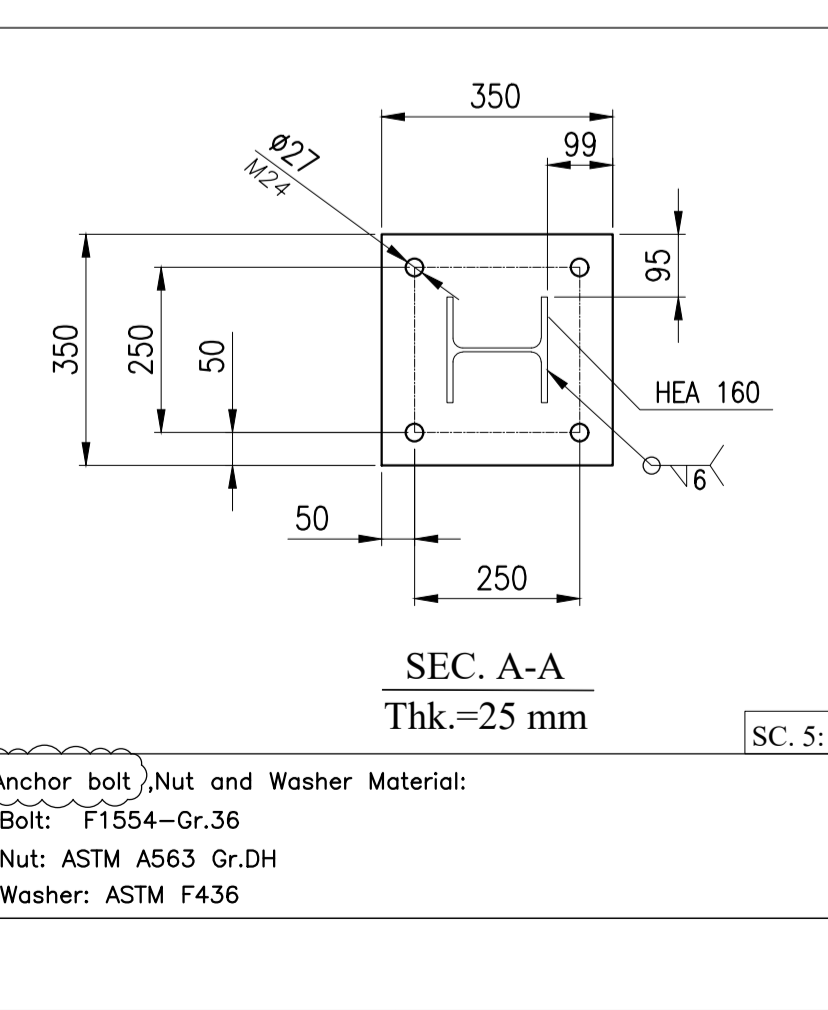


Table 1. Weight of equipments For 1 Units (Total Units = 2)

Equipment	Total No in one Unit	Total Weight in one Unit (tonf)	Total No. for One Bay	Weight for One Bay (kgf)
Bundle Frame	1	0.865	1	865
Tube Bundle & Headers	1	2.635	1	2635
Water in Tubes & Headers	1	0.48	1	480
Plenum	2	0.245	2	490
Fan Ring	2	0.13	2	260
Motor	2	0.07	2	140
Fan	2	0.0275	2	55
Speed Reducer	2	0.25	2	500
Machinery Mount	2	0.32	2	640
Fan Guard	2	0.0325	2	65
sum				2150
Fabrication Weight For 1 Units				5650
Operation Weight For 1 Units				6130
Hydrotest Weight For 1 Units				6130
Total Weight of Main structure, Ladder for 1 Units				6800

GENERAL DATA

DESIGN CODE BUNDLE/STRUCTURE: ASME SEC.VIII DIV.1(2019), API661(2013-7th EDITION)/Standard No. 2800

INLET PRESSURE/PRESSURE HRO. (ALLOWABLE/CALC): 19.8 Bar / (0.1/0.016) Bar

DESIGN PRESSURE: 22+F.V. (barg)

HYDROSTATIC TEST PRESSURE: 28.6 (bar)

TEMPERATURE IN/OUT(TUBE SIDE): 73.5°C/56.32°C

DESIGN TEMPERATURE: 120 °C

MINIMUM DESIGN METAL TEMPERATURE: -45°C

AIR INLET/OUTLET TEMPERATURE (AIR SIDE): 48 / 52.28 °C

MINIMUM DESIGN AMBIENT TEMPERATURE: 5 °C

CORROSION ALLOWANCE: 3 mm

ULTRASONIC TEST: YES(Full)[See note 8]

RADIOGRAPHY: YES(Full)[See note 8]

STRESS RELIEVING: YES

BARE/FINNED SURFACE PER UNIT: 68.101/1579.2 m2

NUMBER OF BUNDLE PER BAY: 1

NUMBER OF UNIT: 2

NUMBER OF BAY PER UNIT: 1

NOZZLE SIZE(INLET/OUTLET/RATING/TYP): 1x4"/1x2"/SCH.160/#300

PROCESS FLUID NAME: PROPANE

SERVICE: PROPANE

PASSES PER BUNDLE: 4

FINNED-TUBES/BUNDLE: NO.140 TUBES,OD=25.4,SEAMLESS MIN.W.BWG16,THK=1.651-6099 mm

Tube to tube sheet joint: STRENGTH WELD + EXPANDED

Fin (Type,material, OD,FPF): EXTRUDE,AL 1060,57,15.11

STEAM COIL: No

LOUVER/TYP: NO/-

PLENUM / FAN RING: FORCED TYPE/CONICAL L/D=0.05

VIBRATION SWITCH: YES(FOR EACHFAN) MANUAL & ELECTRIC RESET

FAN SPECIFICATION -RPM/DIAMETER: 382/7 Ft

Pitch angle (for fan): 8.5°

BLADE NO. / MATERIAL: 4/ALUMINIUM

AIR QUANTITY FOR FAN: 26.879 m3/S

STATIC PRESSURE: 102.95 Pa

AIR TEMPERATURE IN/OUT: 48°C/52.28°C

REDUCTION RATIO: 3.76

MOTOR TYPE: ELECTRIC-Exe.IIB-T3-IP55

VOLTAGE/Freq./PHASES: 400/50/3

RPM/KW: 1500/7.5 Kw

Motor VFD per unit: 50%

S.P.L. 1m all side of fan: <85 dB(A)1m all sides

Hint: Electrical specifications should be match with Final electrical motor data sheet

