

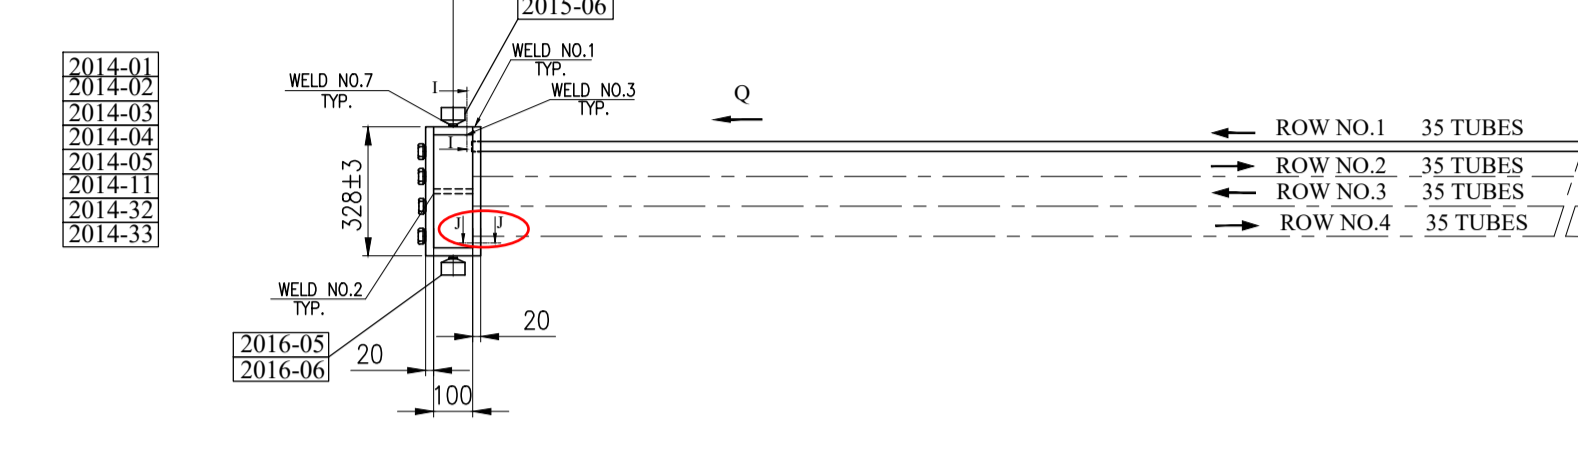
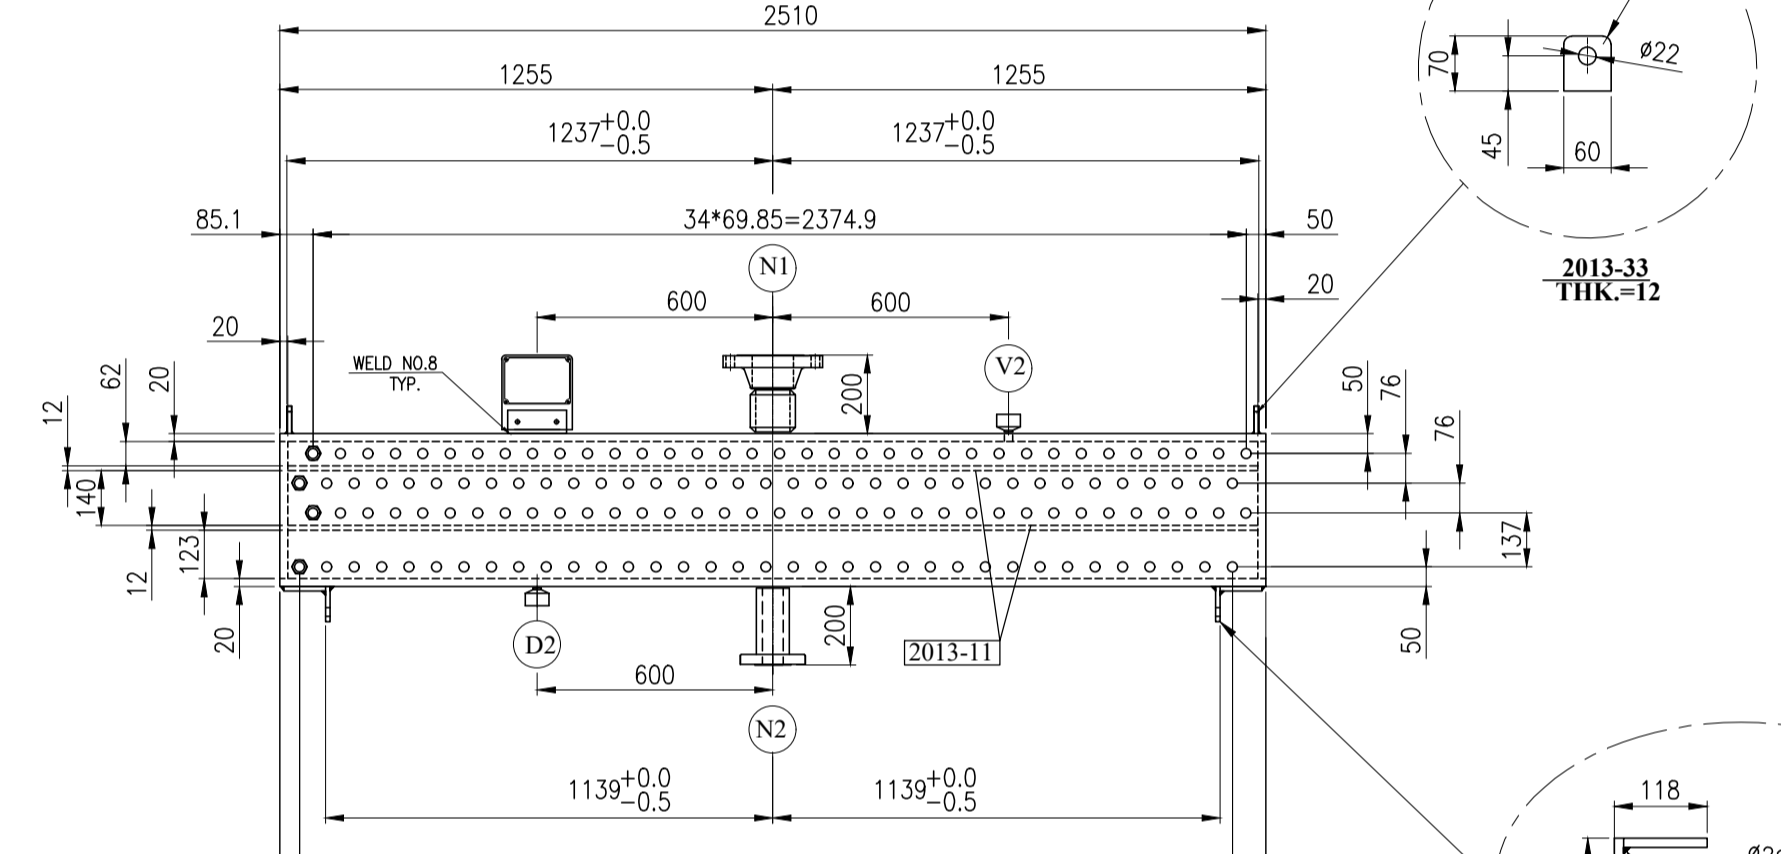


Please consider the following:
HEADER CLAMPS (in different color bolts) TO BE REMOVED AFTER ERECTION AT SITE.

REAR HEADER (SLIDING HEADER)

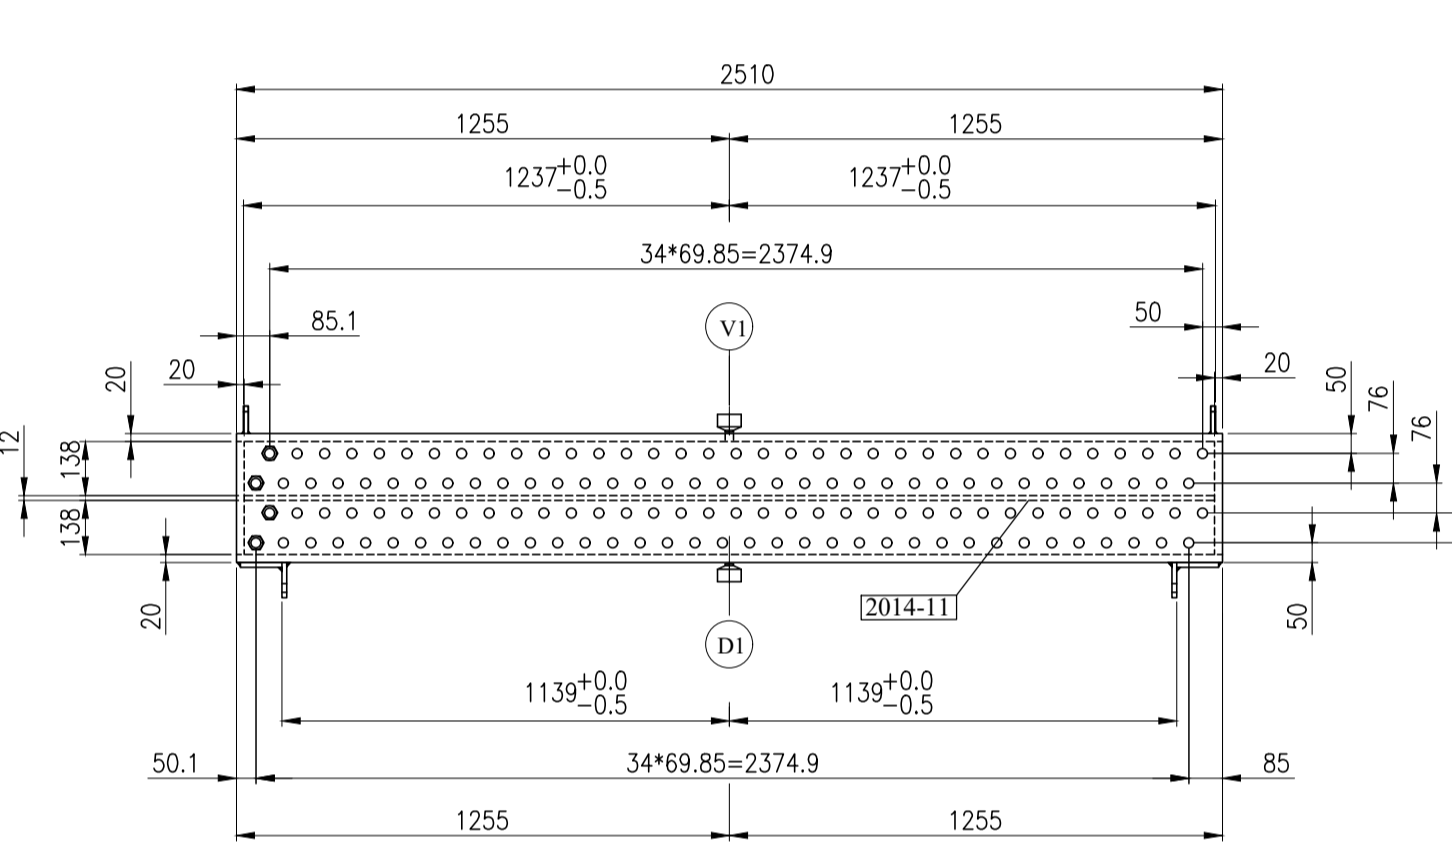


FRONT HEADER (FIXED HEADER)

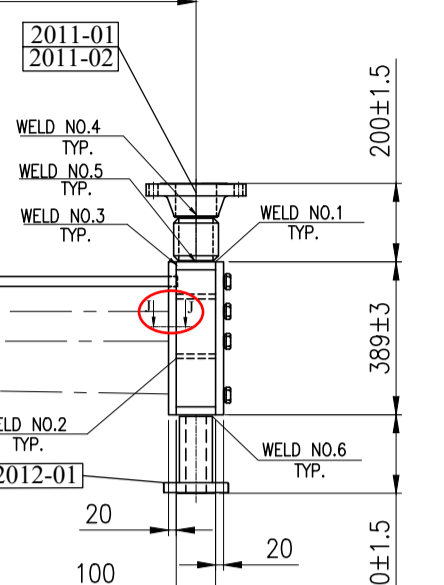

VIEW FROM "Q" REAR HEADER

VIEW FROM "P" FRONT HEADER

THE MAXIMUM ALLOWABLE MOMENTS AND FORCES PER EACH NOZZLE (IF LOADS ARE DIVIDED EQUALLY FOR NOZZLES ACCORDING TO 3xAPI 661(7.1.10.1))	SIZE	Fx(N)	Fy(N)	Fz(N)	Mx(N.m)	My(N.m)	Mz(N.m)
4"	10020	8010	10020	2430	3660	2430	
2"	3060	3990	3060	450	720	450	


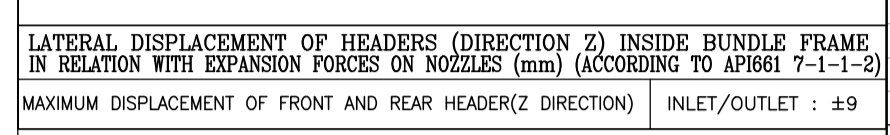


LATERAL DISPLACEMENT OF HEADERS (DIRECTION 2) INSIDE BUNDLE FRAME IN RELATION WITH EXPANSION FORCES ON NOZZLES (mm) (ACCORDING TO API661 7-1-1-2)


MAXIMUM DISPLACEMENT OF FRONT AND REAR HEADER(Z DIRECTION) INLET/OUTLET : ±9

NOZZLE ALIGNMENT TOLERANCES	NOZZLE	FLANGE	NOZZLE	FLANGE
±3	±0.1	±0.1	±0.1	±0.1


NOZZLE ALIGNMENT TOLERANCES

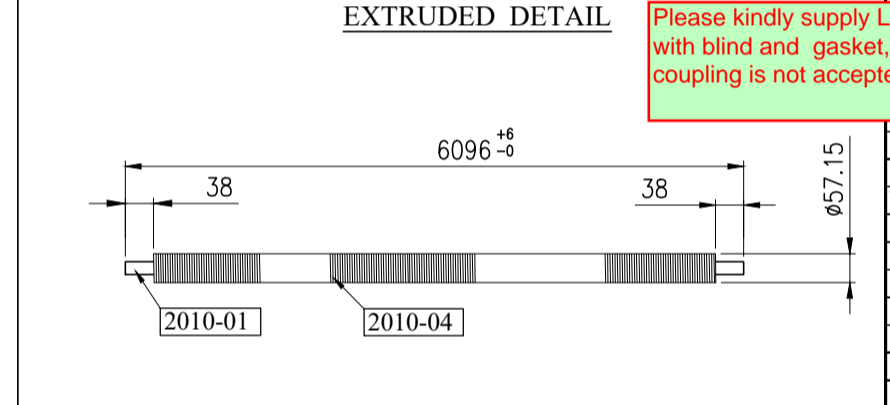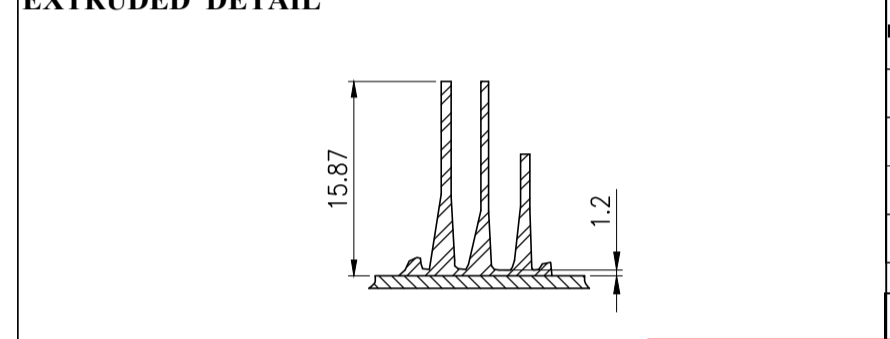


EXTRUDED FIN TUBE 1" SEAMLESS FPI=11 Fin dia.=Ø57.15

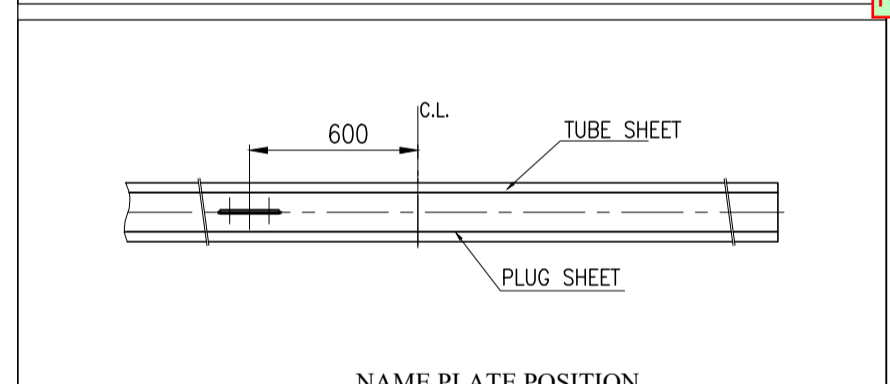

NAME PLATE POSITION

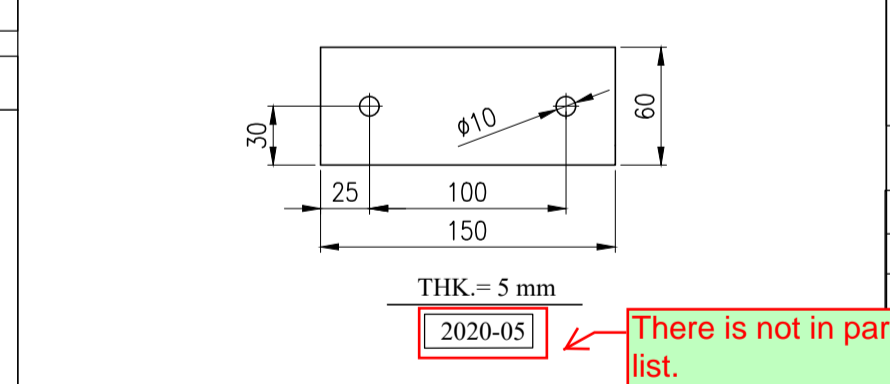

NOZZLE DETAIL

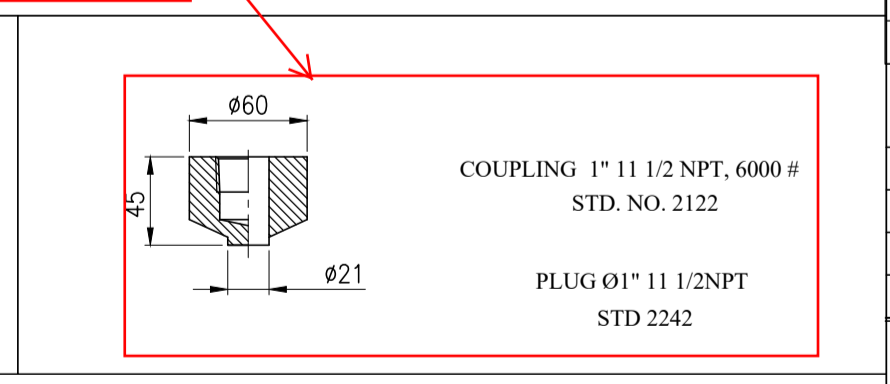

COUPLING 1" 1/2 NPT, 6000 # STD. NO. 2122

PART NO.	DESCRIPTION	DIAM (mm)	LENGTH (mm)	WIDTH (mm)	THK (mm)	MATERIAL	QTY	UNIT WEIGHT (Kg)	TOTAL WEIGHT (Kg)	STD DWG	REV.
2000-00	A TUBE BUNDLE INCLUDING :	-	-	-	-	-	2	2919.9	5840	-	-
2010-00	EXTRUDED FINNED TUBE INCLUDING :	-	-	-	-	-	-	2010.7	-	-	-
2010-01	BASE TUBE 1" (SEAMLESS-MIN. WALL-BWG16)	25.4	6096	-	1.65	SA-334 Gr.6	140	6.5	913.2	-	-
2010-04	ALUMINUM TUBE	38.75	5212.08	-	4.9	AL-1060	140	7.8	1097.5	-	-
2011-00	INLET NOZZLE INCLUDING :	-	-	-	-	-	-	11.0	-	-	-
2011-01	PIPE NOZZLE 4" SCH 160 (SEAMLESS)	107	-	-	13.49	SA-333 Gr.6	1	3.9	3.9	-	-
2011-02	FLANGE 4" (ANSI B16.5.300RWNRF)	254	86	-	-	SA-350 LF2 CL.1	1	7.1	7.1	-	-
2012-00	OUTLET NOZZLE INCLUDING :	-	-	-	-	-	-	2.5	-	-	-
2012-01	NOZZLE 2" (ANSI B16.5.300RWNRF)	165	196	-	15.85	SA-350 LF2 CL.1	1	3.5	3.5	-	-
2013-00	FRONT HEADER INCLUDING :	-	-	-	-	-	-	448.8	-	-	-
2013-01	TUBE SHEET	-	2510	389	20	-	1	153.3	153.3	-	-
2013-02	PLUG SHEET	-	2510	389	20	-	1	153.3	153.3	-	-
2013-03	TOP PLATE	-	2510	100	20	-	1	39.4	39.4	-	-
2013-04	BOTTOM PLATE	-	2510	100	20	-	1	39.4	39.4	-	-
2013-05	END PLATE	-	349	100	20	SA-516 Gr.70N	2	5.5	11.0	-	-
2013-11	PARTITION	-	2470	100	12	-	2	23.3	46.5	-	-
2013-32	SLIDING PAD	-	160	80	12	-	2	1.6	3.1	-	-
2013-33	FIXING	-	70	60	12	-	2	0.4	0.8	-	-
2014-00	REAR HEADER INCLUDING :	-	-	-	-	-	-	372.6	-	-	-
2014-01	TUBE SHEET	-	2510	328	20	-	1	129.3	129.3	-	-
2014-02	PLUG SHEET	-	2510	328	20	-	1	129.3	129.3	-	-
2014-03	TOP PLATE	-	2510	100	20	-	1	39.4	39.4	-	-
2014-04	BOTTOM PLATE	-	2510	100	20	-	1	39.4	39.4	-	-
2014-05	END PLATE	-	288	100	20	-	2	4.5	9.0	-	-
2014-11	PARTITION	-	2470	100	12	-	1	23.3	23.3	-	-
2014-32	SLIDING PAD	-	160	80	12	-	2	1.6	3.1	-	-
2014-33	FIXING	-	70	60	12	-	2	0.4	0.8	-	-
2015-00	VENT INCLUDING :	-	-	-	-	-	-	6.0	-	-	-
2015-05	COUPLING INCLUDING :	-	-	-	-	SA-350 LF2 CL.1	1	1.7	3.4	2122	-
2015-06	PLUG INCLUDING :	-	-	-	-	SA-350 LF2 CL.1	1	1.3	2.6	2242	-
2016-00	DRAWN INCLUDING :	-	-	-	-	-	-	6.0	-	-	-
2016-05	COUPLING INCLUDING :	-	-	-	-	SA-350 LF2 CL.1	1	1.7	3.4	2122	-
2016-06	PLUG INCLUDING :	-	-	-	-	SA-350 LF2 CL.1	1	1.3	2.6	2242	-
2020-00	MISCELLANEOUS PARTS INCLUDING :	-	-	-	-	-	-	62.3	-	-	-
2020-01	PLUG (1 1/8" 12 UNF CL.2A)	-	-	-	-	SA-350 LF2 CL.1	1	0.22	0.22	2201	-
2020-02	LUG GASKET	293.5	-	-	1.5	SOFT IRON	200	-	2290	-	-
2020-02	STAND FOR BRACKET	-	150	60	5	C.S.	1	0.35	0.7	-	-

NOZZLE TABLE

MARK NO.	SERVICE	SIZE	NOZZLE MATERIAL	FLANGE MATERIAL	RATING	TYPE	FACING	SCH. THK.	FLANGE FACE FINISH
N1	INLET NOZZLE	4"	SA-333 Gr.6	SA-350 LF2 CL.1	N 20W	WN	RF	160	125-250 µin
N2	OUTLET NOZZLE	2"	SA-350 LF2 CL.1	N 300W	LWN	RF	160	125-250 µin	1 2
V1,V2	VENT	1"	SA-350 LF2 CL.1	N 6000	COUPLING	-	-	-	-
D1,D2	DRAIN	1"	SA-350 LF2 CL.1	N 6900	COUPLING	-	-	-	-

APPLICABLE CODES AND STANDARDS
 ASME VIII-DIV.1 2019, API 661

ITEM	PROPRANE
DESIGN TEMPERATURE (°C)	120
DESIGN AMBIENT TEMPERATURE (°C)	5
TEST PRESSURE (barg)	22±F.V.
TEST PRESSURE (barg)	5
CORROSION ALLOWANCE	3
WELD JOINT EFFICIENCY	0.6 FOR PARTITION / 0.85 FOR OTHER PARTS
HYDROTEST	YES
POST WELD HEAT TREATMENT	YES
N.D.T. EXAMINATION OF WELDED JOINTS	SEE NDT CHECK LIST
TUBE TO TUBE SHEET JOINT	STRENGTH WELD-EXPANDED
BUNDLE CAPACITY (m ³)	0.480
BUNDLE WEIGHT WITH FRAME (EMPTY) (Kg)	2920
BUNDLE WEIGHT WITH FRAME (FULL OF WATER) (Kg)	3400

NOTES:

- ALL DIMENSIONS ARE IN MILLIMETERS.
- ALL NOZZLE FACINGS SHALL BE PROTECTED BY COVER AND 4 BOLTS.
- FLANGE CONTACT FACES SHALL BE COATED WITH GREASE.
- ALL FLANGE BOLTS SHALL STRADDLE MAIN AXES.
- ALL ENGINEERING AND MANUFACTURING CHARACTERISTICS NOT MENTIONED ON THIS DRAWING ARE INDICATED ON THE FOLLOWING APPLICABLE DOCUMENTS:

A-CALCULATION BOOK
 B-WELDING PROCEDURE SPECIFICATION (W.P.S.)
 C-NON DESTRUCTIVE TEST CHECK LIST (N.D.T.)
 D-PAINTING & GALVANIZING SPECIFICATION SHEETS

6- HEADER PLUG THREADS SHALL BE COVERED BY ANTISEIZE GREASE PROPER FOR 200°C TEMPERATURE.

REFERENCE DOCUMENTS

TITLE	VENDOR DOCUMENT NO.	CLIENT DOCUMENT NO.
GENERAL ARRANGEMENT	1158-A01-1000-00	EI027-DMF-VD-ME-DWG-003
NDLE FRAME	1158-A01-2400-00	EI027-DMF-VD-ME-DWG-007
R COOLER DATA SHEET	1158-A01-0010-00	EI027-DMF-VD-ME-DSH-002
MECHANICAL CALCULATION	1158-A01-0020-00	EI027-DMF-VD-ME-CAL-006
WELDING PROCEDURE SPECIFICATION (W.P.S.)	1158-A01-0060-00	EI027-DMF-VD-QC-WPS-021
NON DESTRUCTIVE TEST CHECK LIST (N.D.T.)	1158-A01-0070-00	EI027-DMF-VD-QC-PRO-022

REV.	DATE	DESCRIPTION	ISSUED FOR APPROVAL	F.SZ	S.S	J.B.L	A.GHZ
0	06/02/2024	ISSUED FOR APPROVAL	F.SZ	S.S	J.B.L	A.GHZ	

CLIENT: ENBR TEKNOLOJI

PROJECT: AIR COOLER FOR Toase-eh Park Sanati Gohar Ofogh Petrochemical Co.

TUBE BUNDLE DRAWING
 1158-A01-2000-00
 DWG. NO. EI027-DMF-VD-ME-DWG-005
 SCALE: N.T.S. SIZE: A1 REV: 0
 THIS DOCUMENT OF A CONFIDENTIAL NATURE IS THE PROPERTY OF DAMAFIN AND SHALL NOT BE REPRODUCED IN ANY MANNER, NOR USED FOR ANY PURPOSE WHATSOEVER, EXCEPT BY WRITTEN PERMISSION OF DAMAFIN.





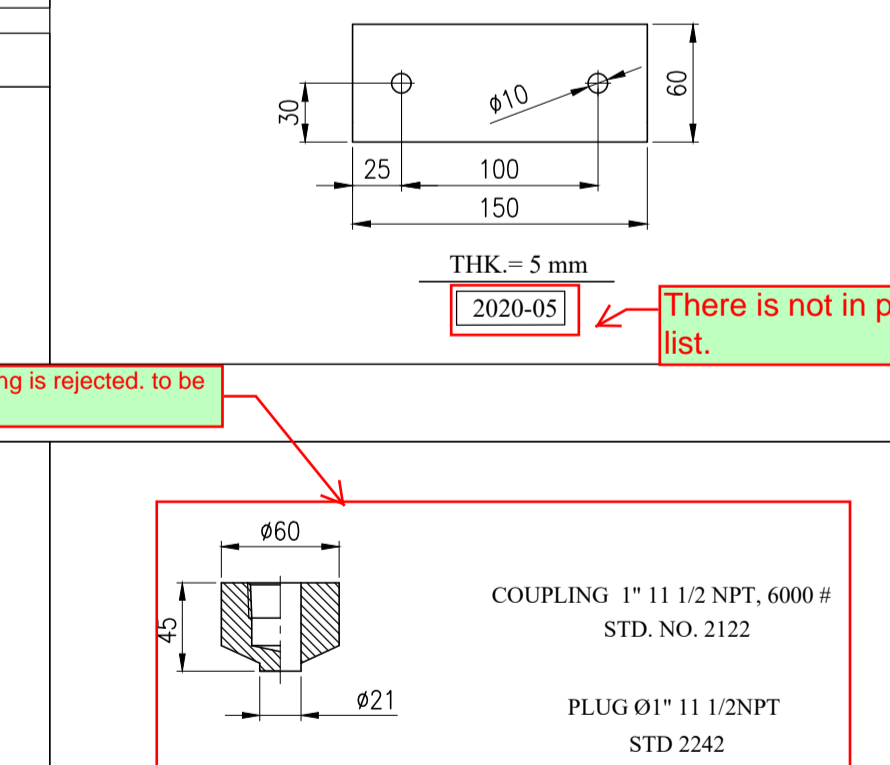


TABLE OF WELDS
 WPS NO. 1158-000-0060-00

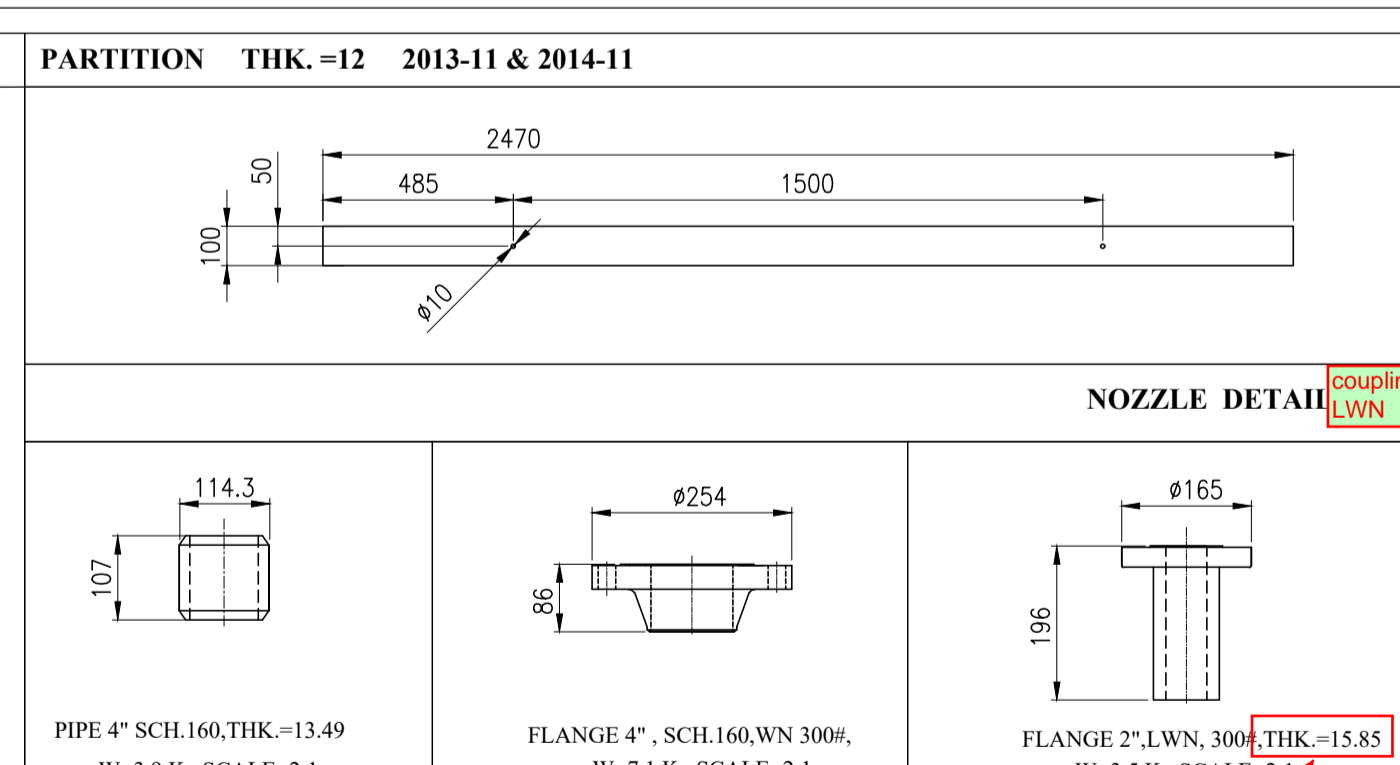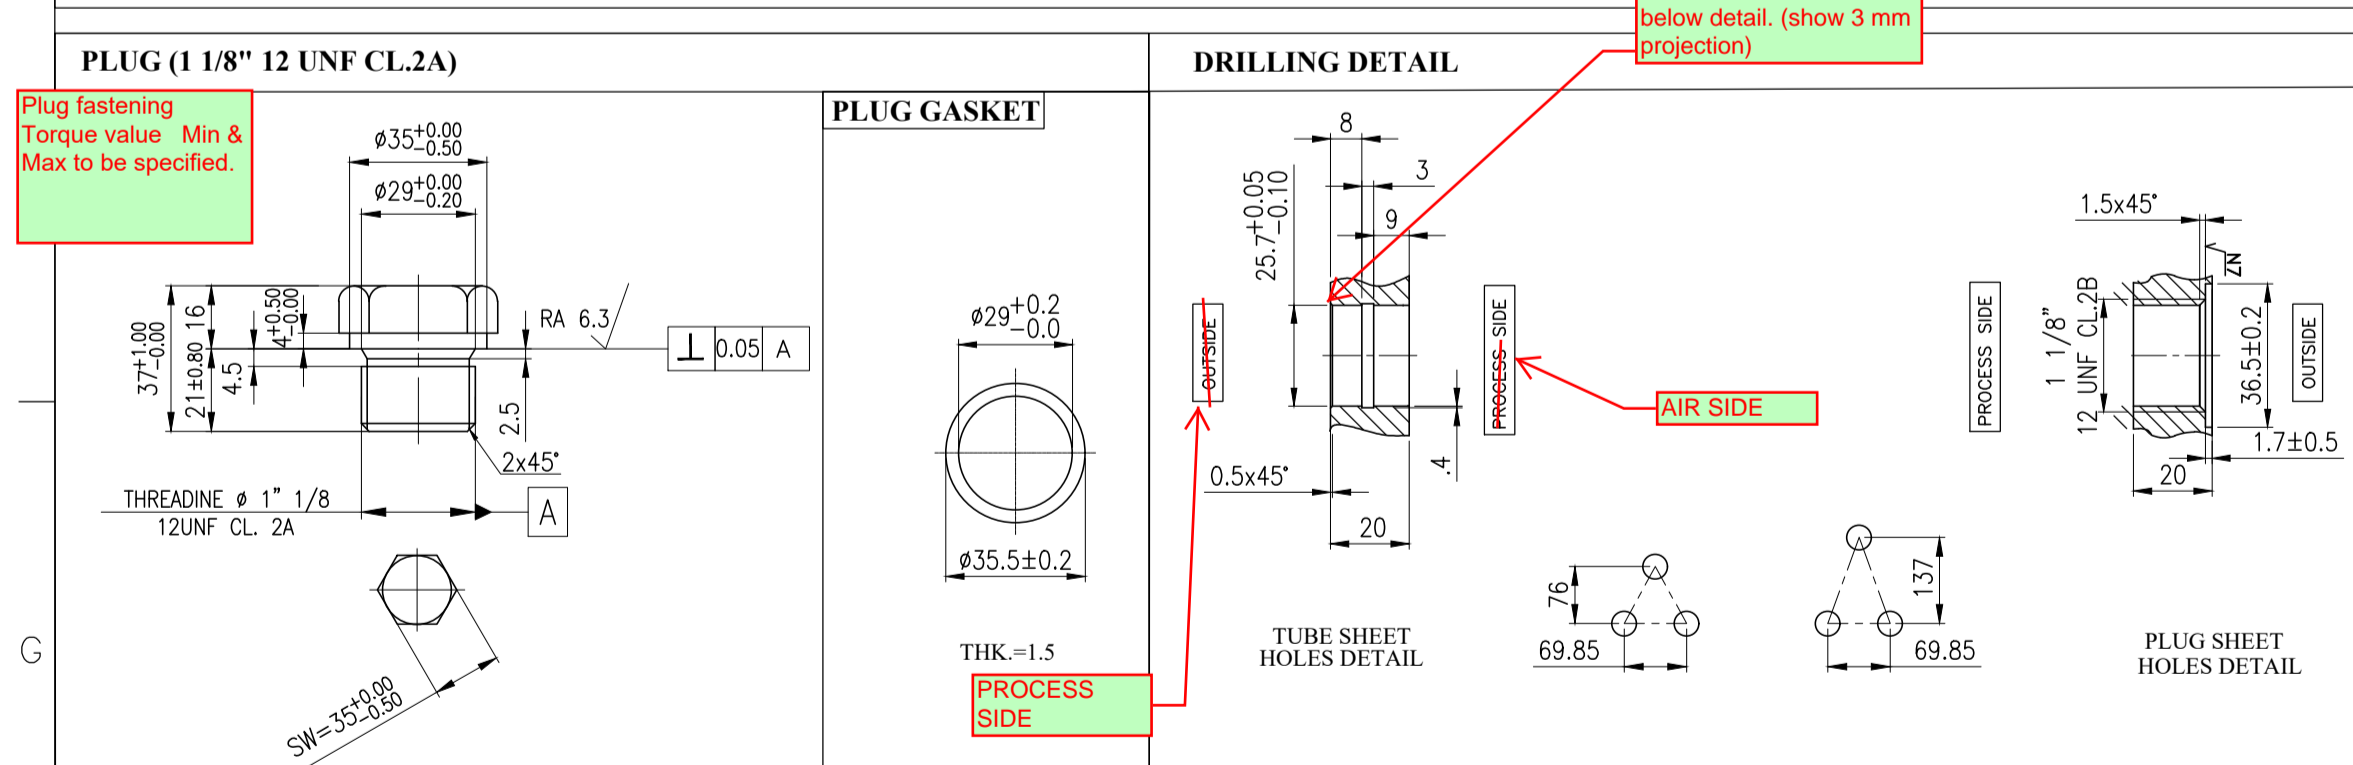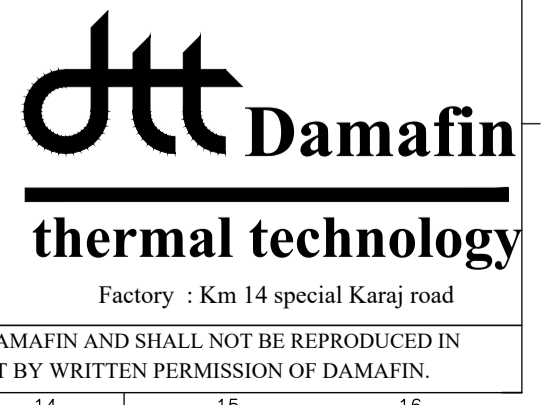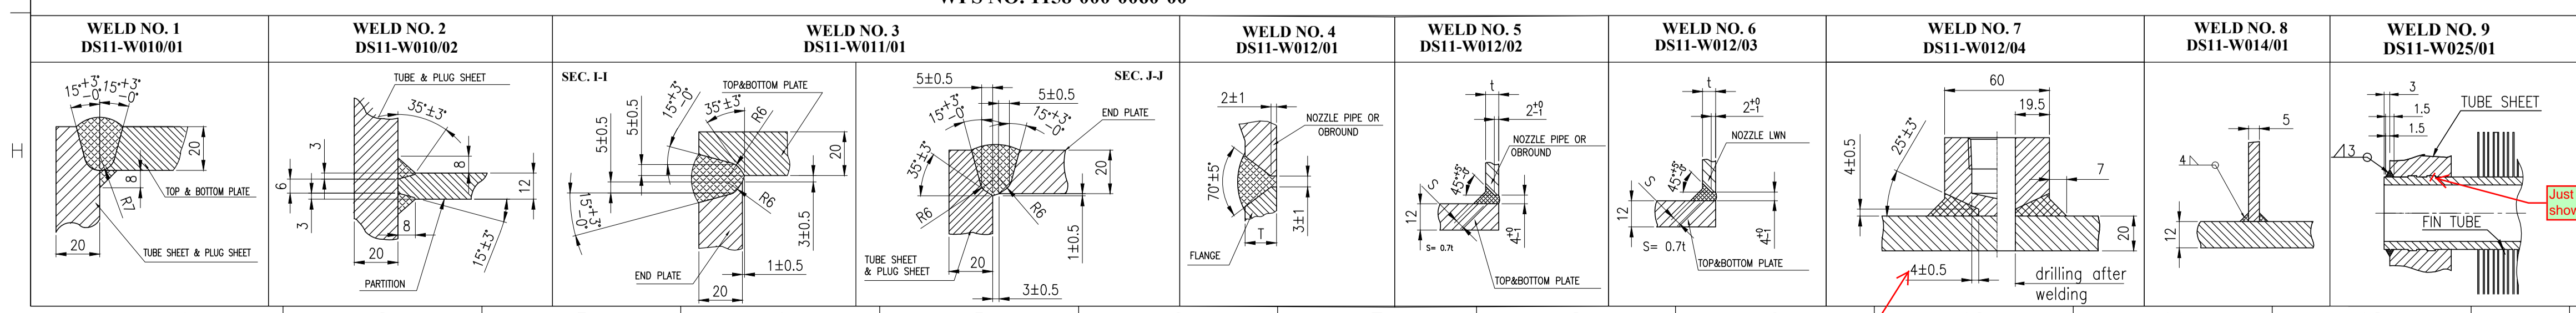

Just one groove to be shown

Coupling is rejected, to be LWN

Hint: It has discrepancy with HTRI. In HTRI file SCH is 80. Please make sure there is no problem in thermal design.

As per TC, Thickness for flange LWN 2" #300, is 16.6

Please add the below note: Nozzle to header shall be ultrasonic

Please add a note about PTFE.

Please kindly supply LWN with blind and gasket, coupling is not accepted.

The No. is repeated.

Add PTFE as shim plate

To be checked for rear header. It should be slot hole and need another detail

To be confirmed with below detail. (show 3 mm projection)

There is not in part list.

THK=16.6

THK=15.85

THK=16.6

THK=16.6

