

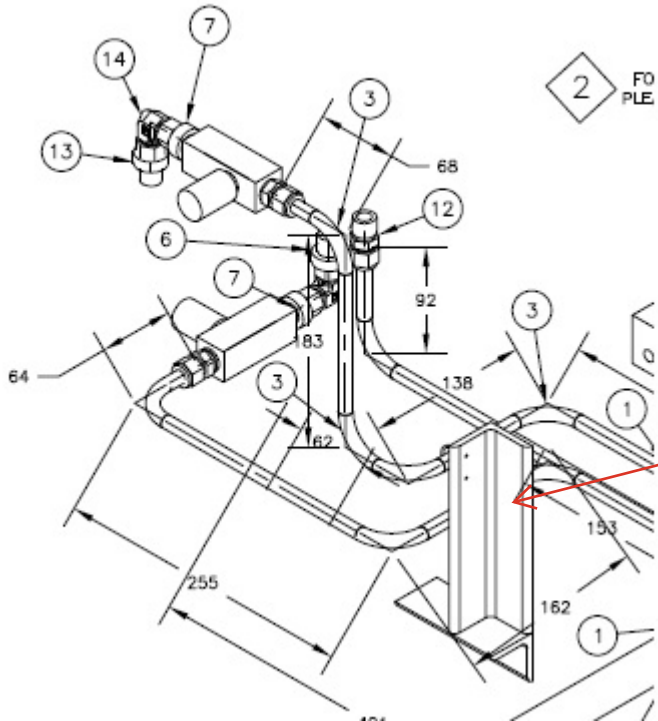
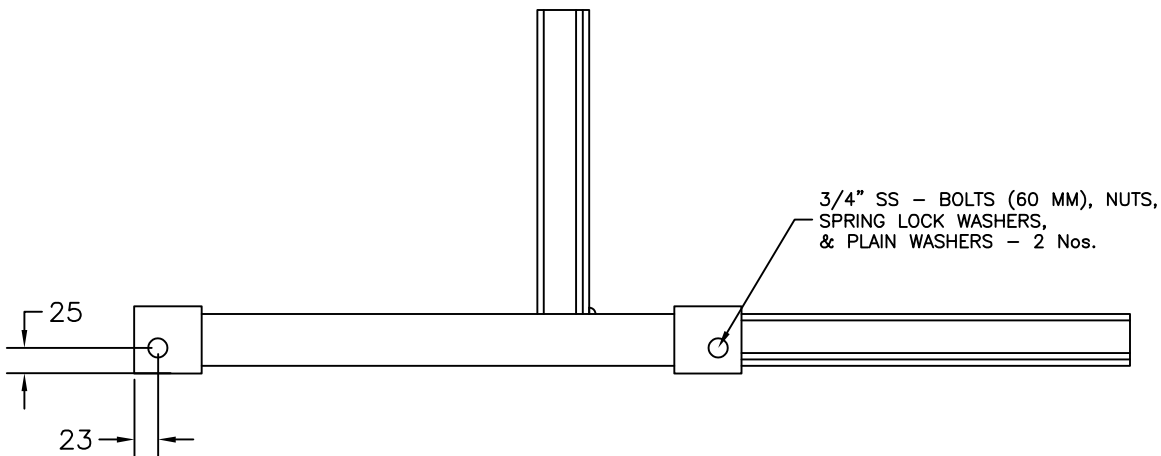
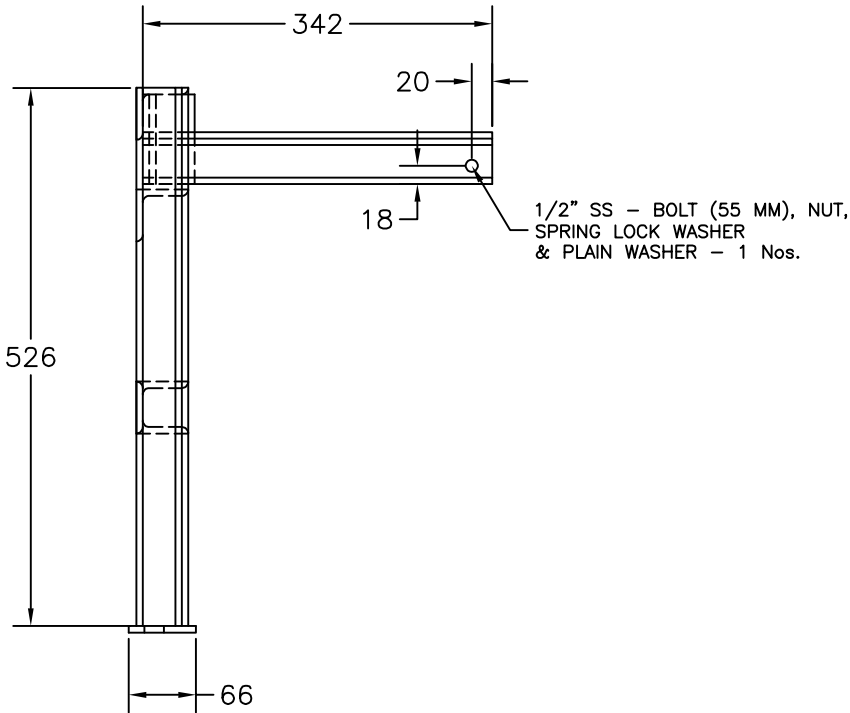


Bill of Materials				
Item	Description	Size	Length (mm)	Material
1	Angle Support	L2x2x1/4	438.279	A242
2	Angle Support	L2x2x1/4	87.7037	A242
3	Angle Support	L2x2x1/4	341.594	A242
4	Angle Support	L2x2x1/4	477.067	A242
5	Angle Support	L2x2x1/4	526.405	A242
6	CS Flat Plate	1/4"	66 X 66	516 Gr.70
7	Bolt Set - SS	1/2"	55	A193-B8
8	Bolt Set - SS	3/4"	60	A193-B8

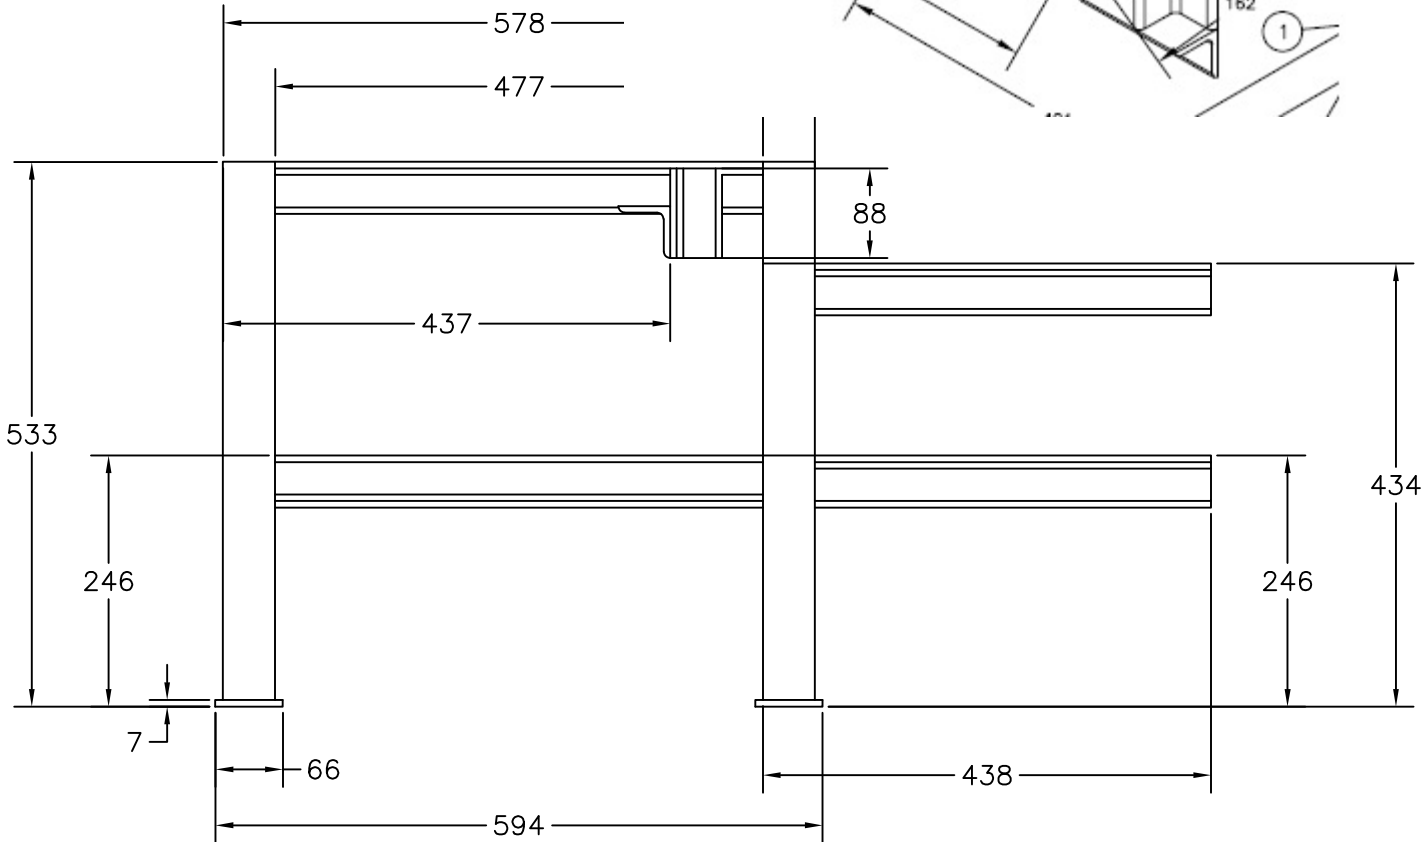

Please provide detail of another support of slide valve assembly

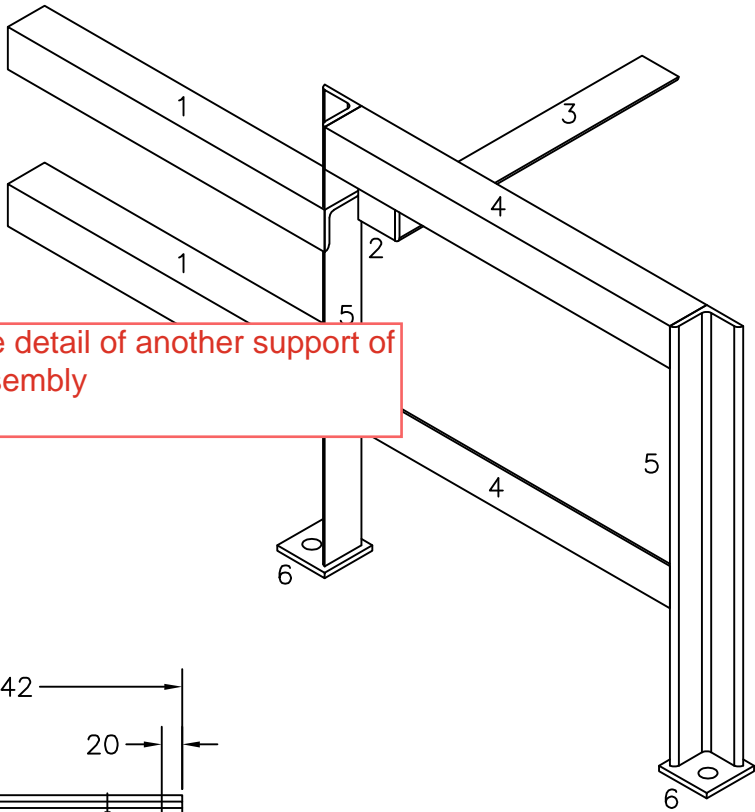

0	F	29.07.24	FOR APPROVAL	AJD	AJD	IES	SES
REV.	STATUS	DATE	PURPOSE OF ISSUE	PREP.	CHKD.	APPD.	AUTH.
CLIENT: ENER TECHNOLOGI		PROPRANE REFRIGERATION PACKAGE					
SERVICE: IRAQ							
LOCATION: RU-001 AIB							
UNIT TAG NO.:							
VENDOR LOGO							
Contract No.		P.O. No.	ENER-MME-2024-100-001		SCALE		
DRAWING TITLE:							
SUPPORT FOR SLIDE VALVE ASSEMBLY							
DRAWING NO.				REV.	SHEET No.	SIZE	
MPE007- T0175-SPRT				0	1 OF 1	D	