




 Gachsaran Polymer Industries Company	Gachsaran Polymer Industries Company HDPE Plant		
	General Arrangement Drawing (2D) (*Tie-In Points , Skid Dimensions & Orientation, Including Instrument, Junction Box and Local Panel Location Layout & Instrument Cable routing.) for Refrigerator Package	 	
PO No.: GPIC-PT-MA-PO-000-3029	Document Number: VD-GPIC-MA-3029-3029-0062	Rev. 03	Page 1 of 11

General Arrangement Drawing (2D) (*Tie-In Points , Skid Dimensions & Orientation, Including Instrument, Junction Box and Local Panel Location Layout & Instrument Cable routing.) for Refrigerator Package


Code1	<input type="checkbox"/> No Comment/ Approved (Applicable Only for "FOR REVIEW" and "For Approval" Documents) No comment and the document are released for Manufacturing.
Code2	<input type="checkbox"/> No Comment/ Approved with Note(s) Vendor/Sub-Contractor shall correct, revise and resubmit the document. The document is released for Manufacturing if changes incorporated.
Code3	<input checked="" type="checkbox"/> Commented Vendor/Sub-Contractor shall correct, revise and resubmit the document by the date specified. The document shall be revised under the Status of "R: Revised Issue". All corrected documents shall be resubmitted before starting the Manufacturing Process.
Code 4	<input type="checkbox"/> Not Accepted (Rejected) Vendor/Sub-Contractor shall re-work / re-design / re-specify the contents of the document according to the comments / reasons for rejection. All corrected documents shall be resubmitted before starting the manufacturing. Vendor/Sub-Contractor shall not proceed with subsequent works of Material Supply or Manufacturing until receiving Code1/Code2 or No Code from PURCHASER. Vendor/Sub-Contractor shall resubmit the document with the same revision within 6 working days after receiving comments.
No code	<input type="checkbox"/> No Code (Applicable Only for "For Information" Documents and "As Built DWGs") Document has been submitted for PURCHASER's Information (FI). Consistency, completeness and correctness of document content is in Vendor/Sub-Contractor's responsibility.
Above checking results by EIED shall in no way relieve Vendor of any liability, obligation and responsibility out of the purchase order and the mutual agreement in writing.	
 EIED Energy Industries Engineering & Design co.	Date: Nov. 19, 2025 Dept.: MA Signature: F.Hamooni

- 1- repeated comment: Vendor shall specify the "Allowable nozzle loads" table for tie-in points at this document.
- 2- repeated comment: Fixed(semi-anchor) **pipe supports** shall be considered close to the tie-in connections with EIED.
- 3- repeated comment: Stress Analysis Report including Caesar II native files for critical pipes inside package shall be provided by vendor.

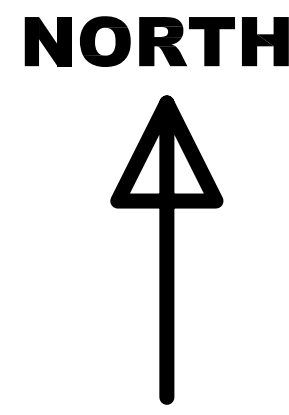


PI COMMENT:
 -The customer (EIED) shall provide with the STP and navies file of model.
 -Since EIED has TI in/out with vendor in this points (S-42,43,44,T-4A) so their locations and distances from reference point shall be specified in views.
 -Since the direct connection of some lines (Except T-51,T-52,T-4CWS,T-4CWS,T-1A,T-2AI that are in boundary skids) may cause clashes with the lines inside the package, the TI in/out shall be specified in boundary skids.

please specify the dimensions only in metric unit

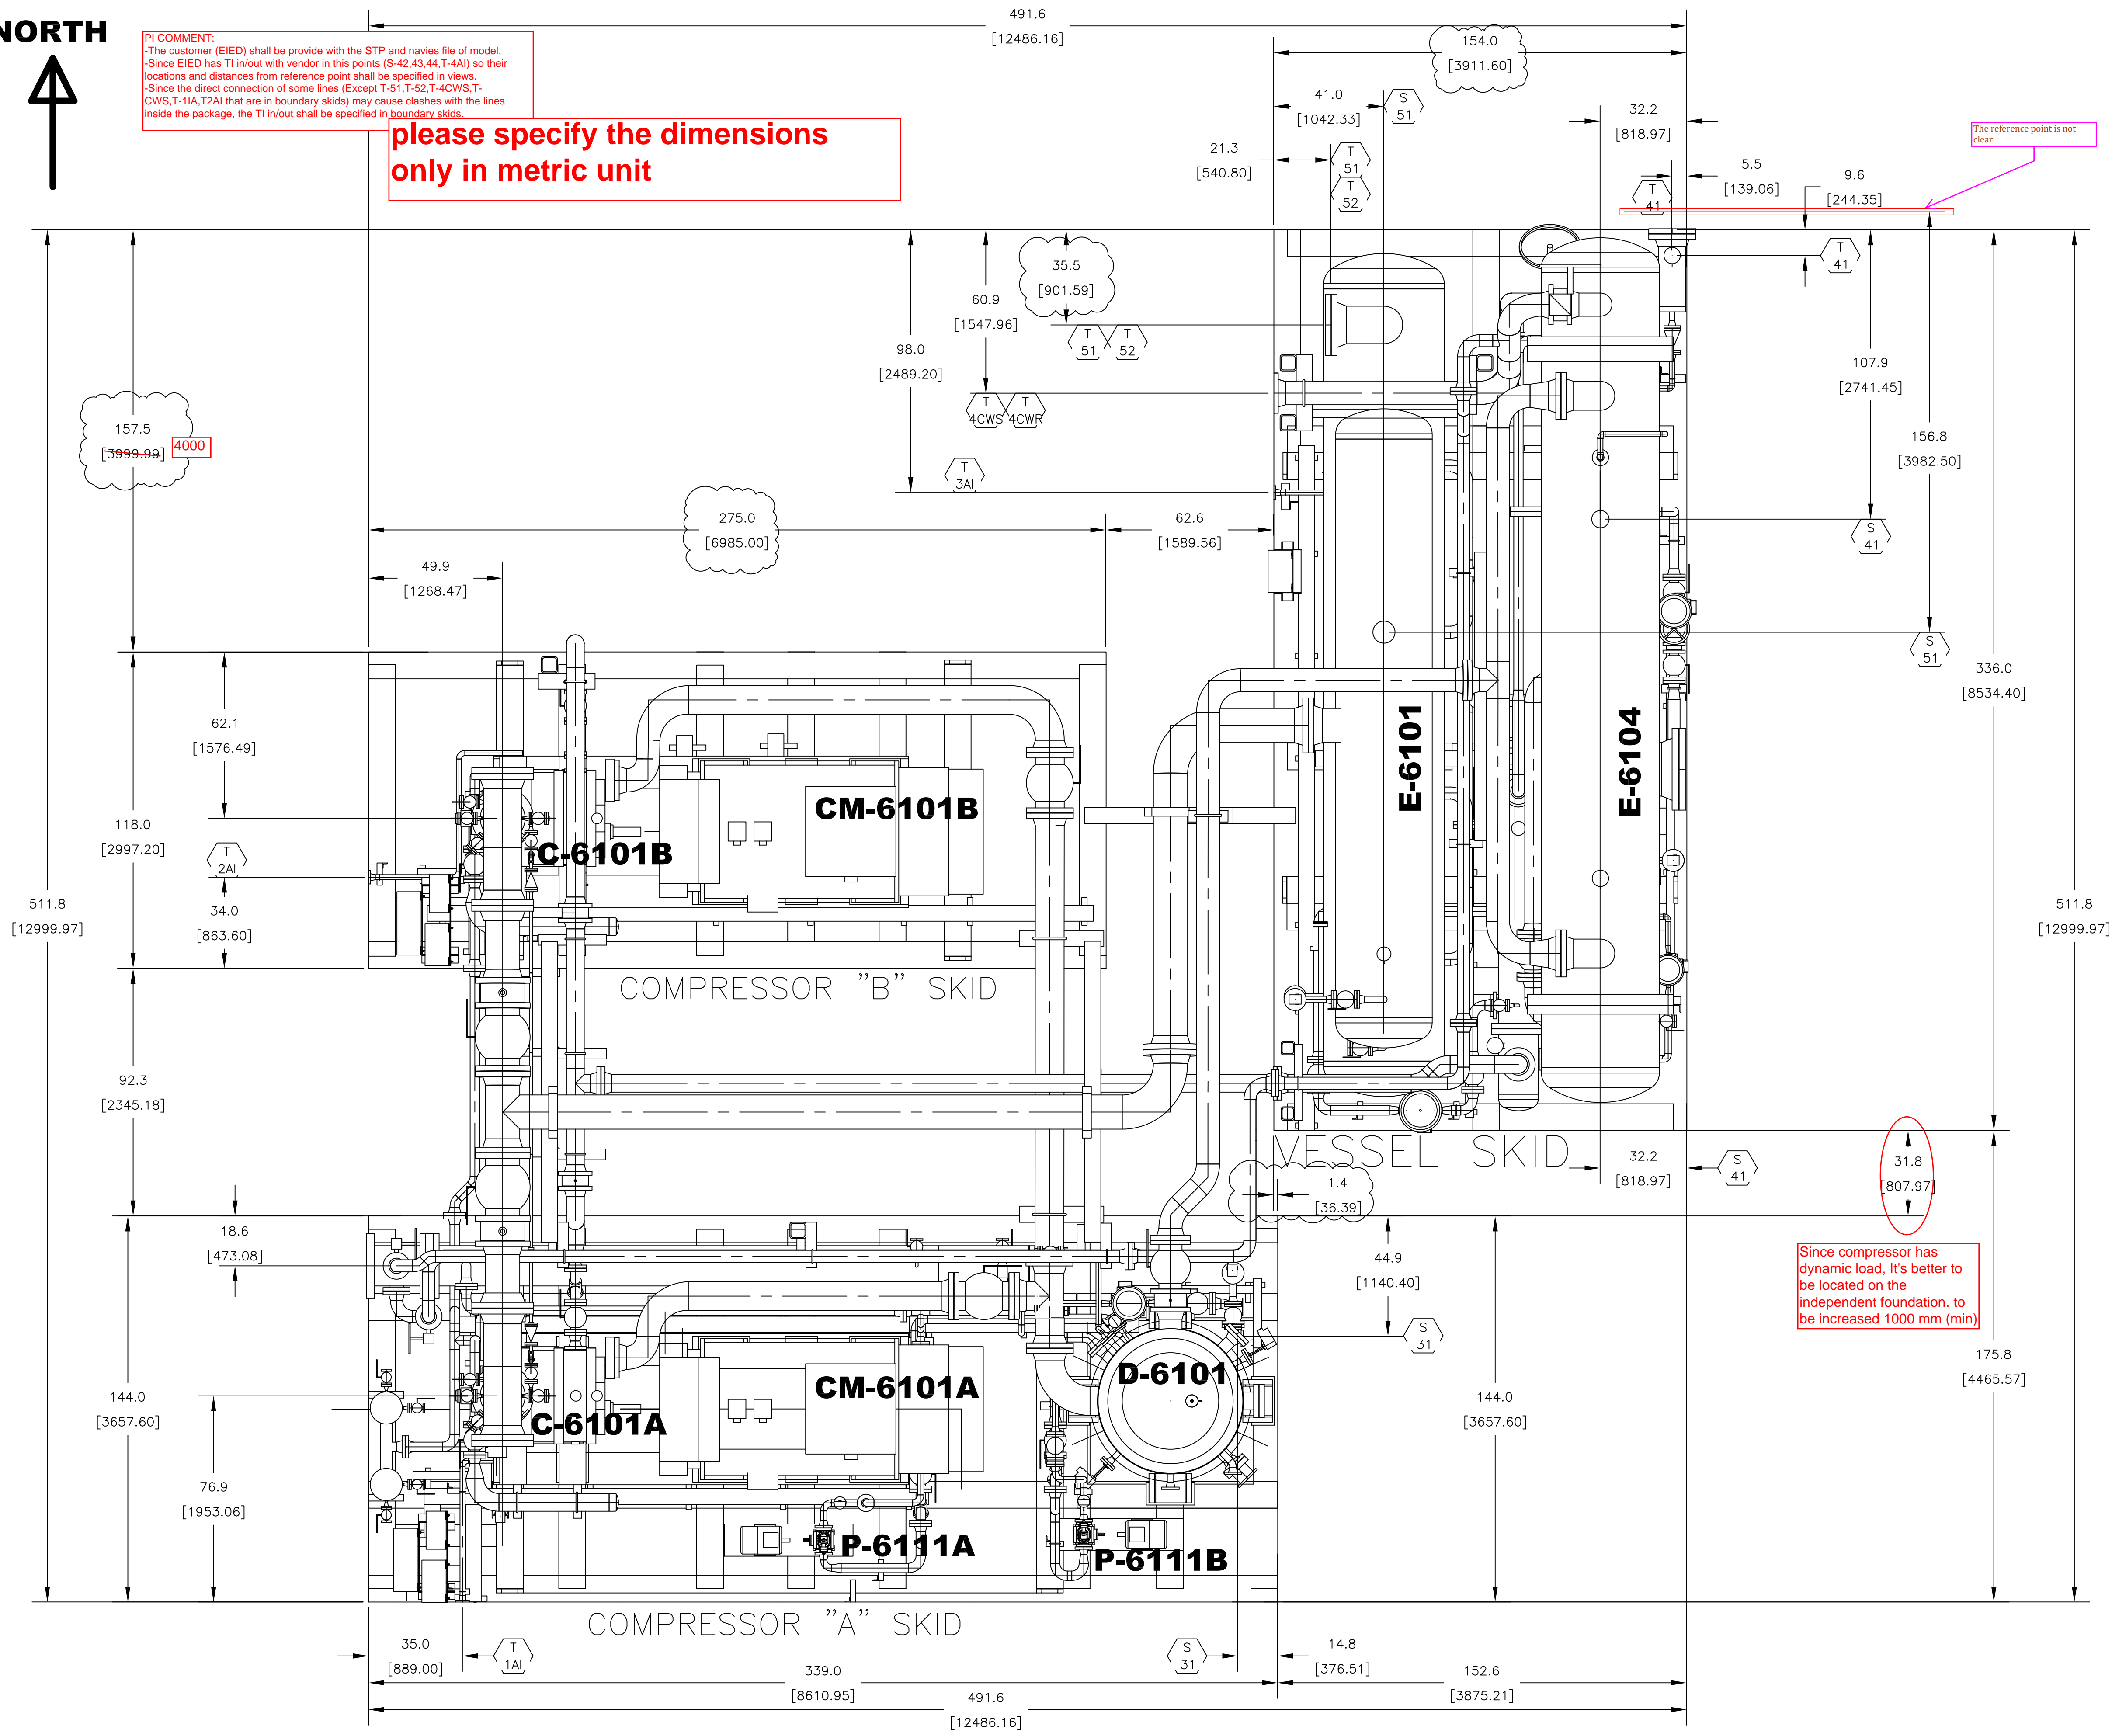





NOTES:

- FOR OPERATING AND DRY WEIGHTS, REFER TO VD-GPIC-MA-3029-3029-0071
- FOR CENTER OF GRAVITY, REFER TO VD-GPIC-MA-3029-3029-0071
- FOR DYNAMIC AND STATIC LOADS, REFER TO VD-GPIC-MA-3029-3029-0071
- FOR FOUNDATION DETAIL DRAWING, REFER TO VD-GPIC-MA-3029-3029-0071
- FOR LIFTING DETAILS, REFER TO VD-GPIC-MA-3029-3029-0062
- FOR SKID INSTALLATION, REFER TO INSTRUCTION AND OPERATIONAL MANUAL VD-GPIC-MA-3029-3029-0008
- DIMENSIONS ARE IN INCHES AND MM IN PARENTHESIS.
- ANCHOR HOLES TOLERANCES ± 0.13 in (± 3.2 mm).
- BEAM LOCATION TOLERANCES: ± 0.13 in (± 3.2 mm).
- NON-SKID GRATING UNDER MAINTENANCE AREA IS NOT INCLUDED.
- SKID FLATNESS SHALL BE 0.0625" (1.6 mm).
- SURFACE PREPARATION SHALL BE PER PROJECT PAINTING SPECIFICATION.
- ANCHOR BOLT HOLES SHALL BE WITHIN THE SAME XY AND XZ PLANES WITHIN ± 0.13 in (± 3.2 mm).
- COMPRESSOR SKIDS SHALL BE GROUTED. GROUT SPECIFICATION AND SELECTION BY OTHER AND SHALL BE SUITABLE TO PAINTING APPLICATION.
- FOR PIPE NOZZLE LOADS REFER TO DOCUMENT NUMBER VD-GPIC-MA-3029-3029-0062-G

Code1	<input type="checkbox"/> No Comment/ Approved (Applicable Only for "FOR REVIEW" and "For Approval" Documents) No comment and the document are released for Manufacturing				
Code2	<input type="checkbox"/> No Comment / Approved with Note(s) Vendor/Sub-Contractor shall correct, revise and resubmit the document. The document is released for Manufacturing if changes incorporated.				
Code3	<input type="checkbox"/> Commented Vendor/Sub-Contractor shall correct, revise and resubmit the document by the date specified. The document shall be reissued under the Status of "Revised Issue". All corrected documents shall be resubmitted before starting the Manufacturing Process				
Code4	<input type="checkbox"/> Not Accepted (Rejected) Vendor/Sub-Contractor shall re-work/re-design/re-specify the contents of the document according to the comments/reasons for rejection. All corrected documents shall be resubmitted before starting the manufacturing. Vendor Sub-Contractor shall not proceed with subsequent work of Material Supply or Manufacturing until receiving Code1/Code2 or No Code from PURCHASER. Vendor/Sub-Contractor shall resubmit the document with the same revision within 6 working days after receiving comments				
No Code	<input type="checkbox"/> No Code (Only for "For Information" Documents and "As Built DWGs") Document has been submitted for PURCHASER'S information (I). Consistency, completeness and correctness of document content is in Vendor/Sub-Contractor's responsibility. The above checking result by EIED shall in no way relieve Vendor of any liability, obligation and responsibility out of the purchase order and the mutual agreement in writing				
DATE: _____ DEPT: _____ Signature: _____ 					
CV	PI	EL	IN	ME	MA
ST	BU	PR	SA	HV	TL

Since compressor has dynamic load, It's better to be located on the independent foundation, to be increased 1000 mm (min)


03	05.11.2025	IFR	FA	IM	OG
02	09.10.2025	IFR	FA	IM	OG
01	16.09.2025	IFR	FA	IM	OG
00	28.06.2025	IFR	FA	IM	OG
REV.	DATE (DD.MM.YY)	Purpose of Issue	Prepared	Checked	Approved



Gacharan Polymer Industries Company
HDPE Plant



PO No.: GPIC-PT-MA-PO-000-3029 SCALE: 3/8":1'

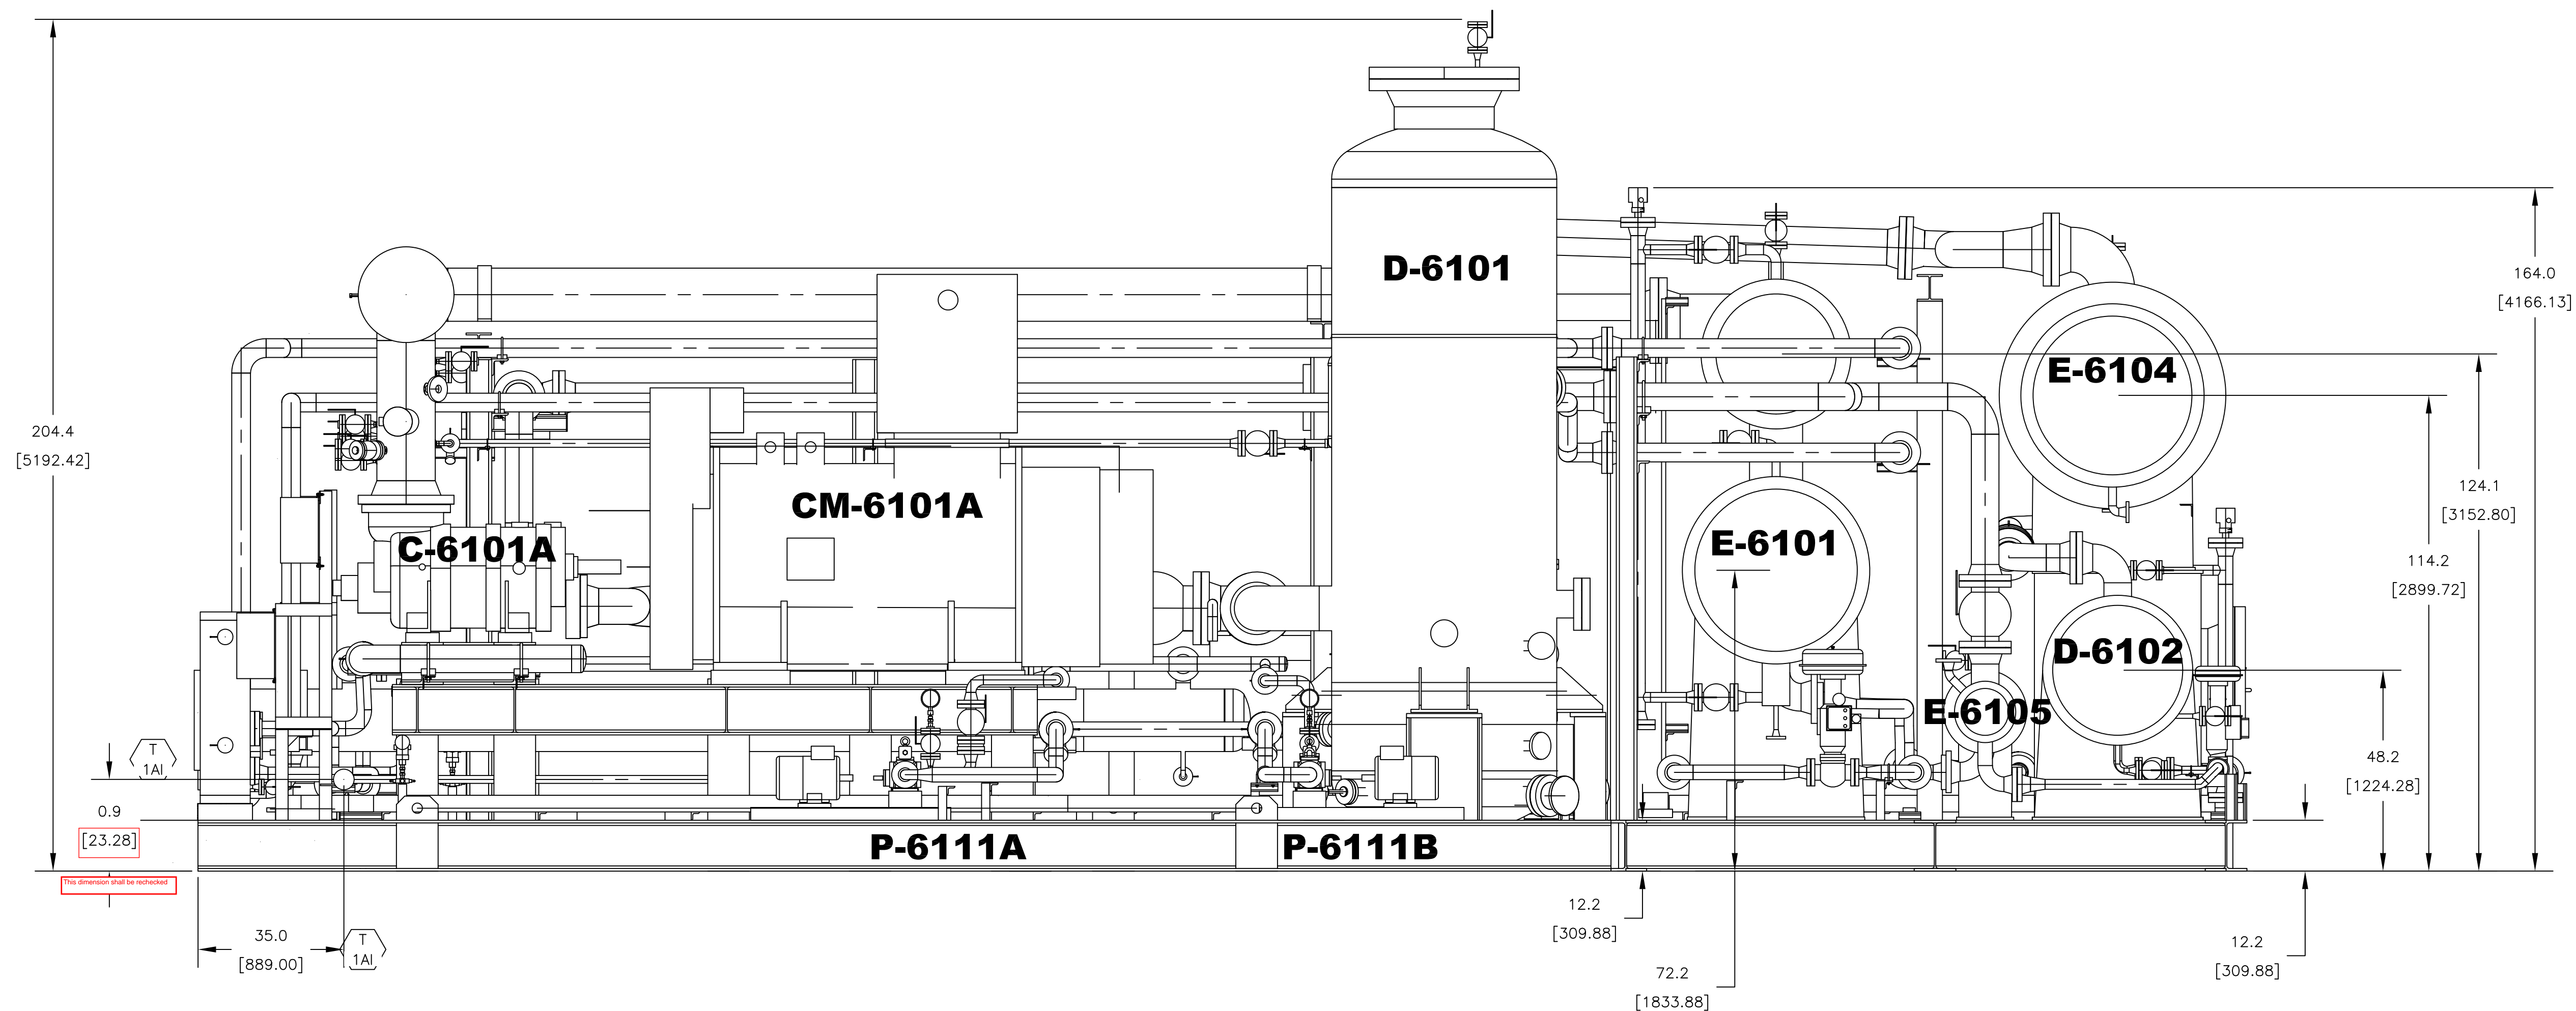DRAWING TITLE:
 General Arrangement Drawing (2D) (*Tie-In Points, Skid Dimensions & Orientation, Including Instrument, Junction Box and Local Panel Location Layout & Instrument Cable routing.)
 for Refrinator Package





DRAWING NO.	VD-GPIC-MA-3029-3029-0062	REV.	SHEET NO.	SIZE
		03	3 of 11	A1



FRONT VIEW

Code1	<input type="checkbox"/> No Comment/ Approved (Applicable Only for "FOR REVIEW" and "For Approval" Documents) No comment and the document are released for Manufacturing				
Code2	<input type="checkbox"/> No Comment / Approved with Note(s) Vendor/Sub-Contractor shall correct, revise and resubmit the document. The document is released for Manufacturing if changes incorporated.				
Code3	<input type="checkbox"/> Commented Vendor/Sub-Contractor shall correct, revise and resubmit the document by the date specified. The document shall be revised under the Status of "R: Revised Issue". All corrected documents shall be resubmitted before starting the Manufacturing Process				
Code4	<input type="checkbox"/> Not Accepted (Rejected) Vendor/Sub-Contractor shall re-work/re-design/re-specify the contents of the document according to the comments/reasons for rejection. All corrected documents shall be resubmitted before starting the manufacturing. Vendor/Sub-Contractor shall not proceed with subsequent work of Material Supply or Manufacturing until receiving Code1/Code2 or No Code from PURCHASER. Vendor/Sub-Contractor shall resubmit the document with the same revision within 6 working days after receiving comments				
No Code	<input type="checkbox"/> No Code (Only for "For Information" Documents and "As Built DWG's") Document has been submitted for PURCHASER'S information (I). Consistency, completeness and correctness of document content is in Vendor/Sub-Contractor's responsibility. The above checking result by EIED shall in no way relieve Vendor of any liability, obligation and responsibility out of the purchase order and the mutual agreement in writing				
DATE : DEPT : Signature :					
CV	PI	EL	IN	ME	MA
ST	BU	PR	SA	HV	TL

03	05.11.2025	IFR	FA	IM	OG
02	09.10.2025	IFR	FA	IM	OG
01	16.09.2025	IFR	FA	IM	OG
00	28.06.2025	IFR	FA	IM	OG
REV.	DATE (DD.MM.YY)	Purpose of Issue	Prepared	Checked	Approved



Gachasan Polymer Industries Company
HDPE Plant




PO No.: GPIC-PT-MA-PO-000-3029 SCALE: 1/2":1'

DRAWING TITLE:
General Arrangement Drawing (2D) (*Tie-In Points, Skid Dimensions & Orientation, Including Instrument, Junction Box and Local Panel Location Layout & Instrument Cable routing.) for Refrigerator Package

DRAWING NO.	VD-GPIC-MA-3029-3029-0062	REV.	SHEET NO.	SIZE
		03	4 of 11	A1

CONNECTION LIST			
NO.	LOCATION	DESCRIPTION	SIZE
T-1AI	COMPRESSOR SKID-A	INSTRUMENT AIR SUPPLY	1"-300 ANSI RF
T-2AI	COMPRESSOR SKID-B	INSTRUMENT AIR SUPPLY	1"-300 ANSI RF
T-4AI	VESSEL SKID	INSTRUMENT AIR SUPPLY	1"-300 ANSI RF
T-4CWS	VESSEL SKID	OIL COOLER COOLING WATER SUPPLY	8"-300 ANSI RF
T-4CWR	VESSEL SKID	OIL COOLER COOLING WATER RETURN	8"-300 ANSI RF
T-41	VESSEL SKID	FILTER/DRYER INLET	1-1/2"-300 ANSI RF
T-51	VESSEL SKID	CHILLER PROCESS INLET	14"-300 ANSI RF
T-52	VESSEL SKID	CHILLER PROCESS OUTLET	14"-300 ANSI RF
S-31	COMPRESSOR SKID-A	OIL SEPARATOR PRESSURE SAFETY	4"-300 ANSI RF
S-41	VESSEL SKID	CONDENSER PRESSURE SAFETY	3"-300 ANSI RF
S-42	VESSEL SKID	RECEIVER PRESSURE SAFETY	4"-300 ANSI RF
S-43	VESSEL SKID	ECONOMIZER PRESSURE SAFETY-SHELL	1-1/2"-300 ANSI RF
S-44	VESSEL SKID	ECONOMIZER PRESSURE SAFETY-TUBE	1-1/2"-300 ANSI RF
S-51	VESSEL SKID	CHILLER PRESSURE SAFETY	3"-300 ANSI RF

EQUIPMENT TAG NUMBER	
TAG NO.	DESCRIPTION
C-6101A	COMPRESSOR
C-6101B	COMPRESSOR
CM-6101A	COMPRESSOR MOTOR
CM-6101B	COMPRESSOR MOTOR
E-6101	CHILLER
E-6102	OIL COOLER
E-6104	CONDENSER
E-6105	ECONOMIZER
D-6101	OIL SEPARATOR
D-6102	RECEIVER
P-6111A/A	OIL PUMPS
PM-6111A/A	OIL PUMP MOTORS
F-6102	FILTER/DRYER
F-6101A/B	OIL FILTER

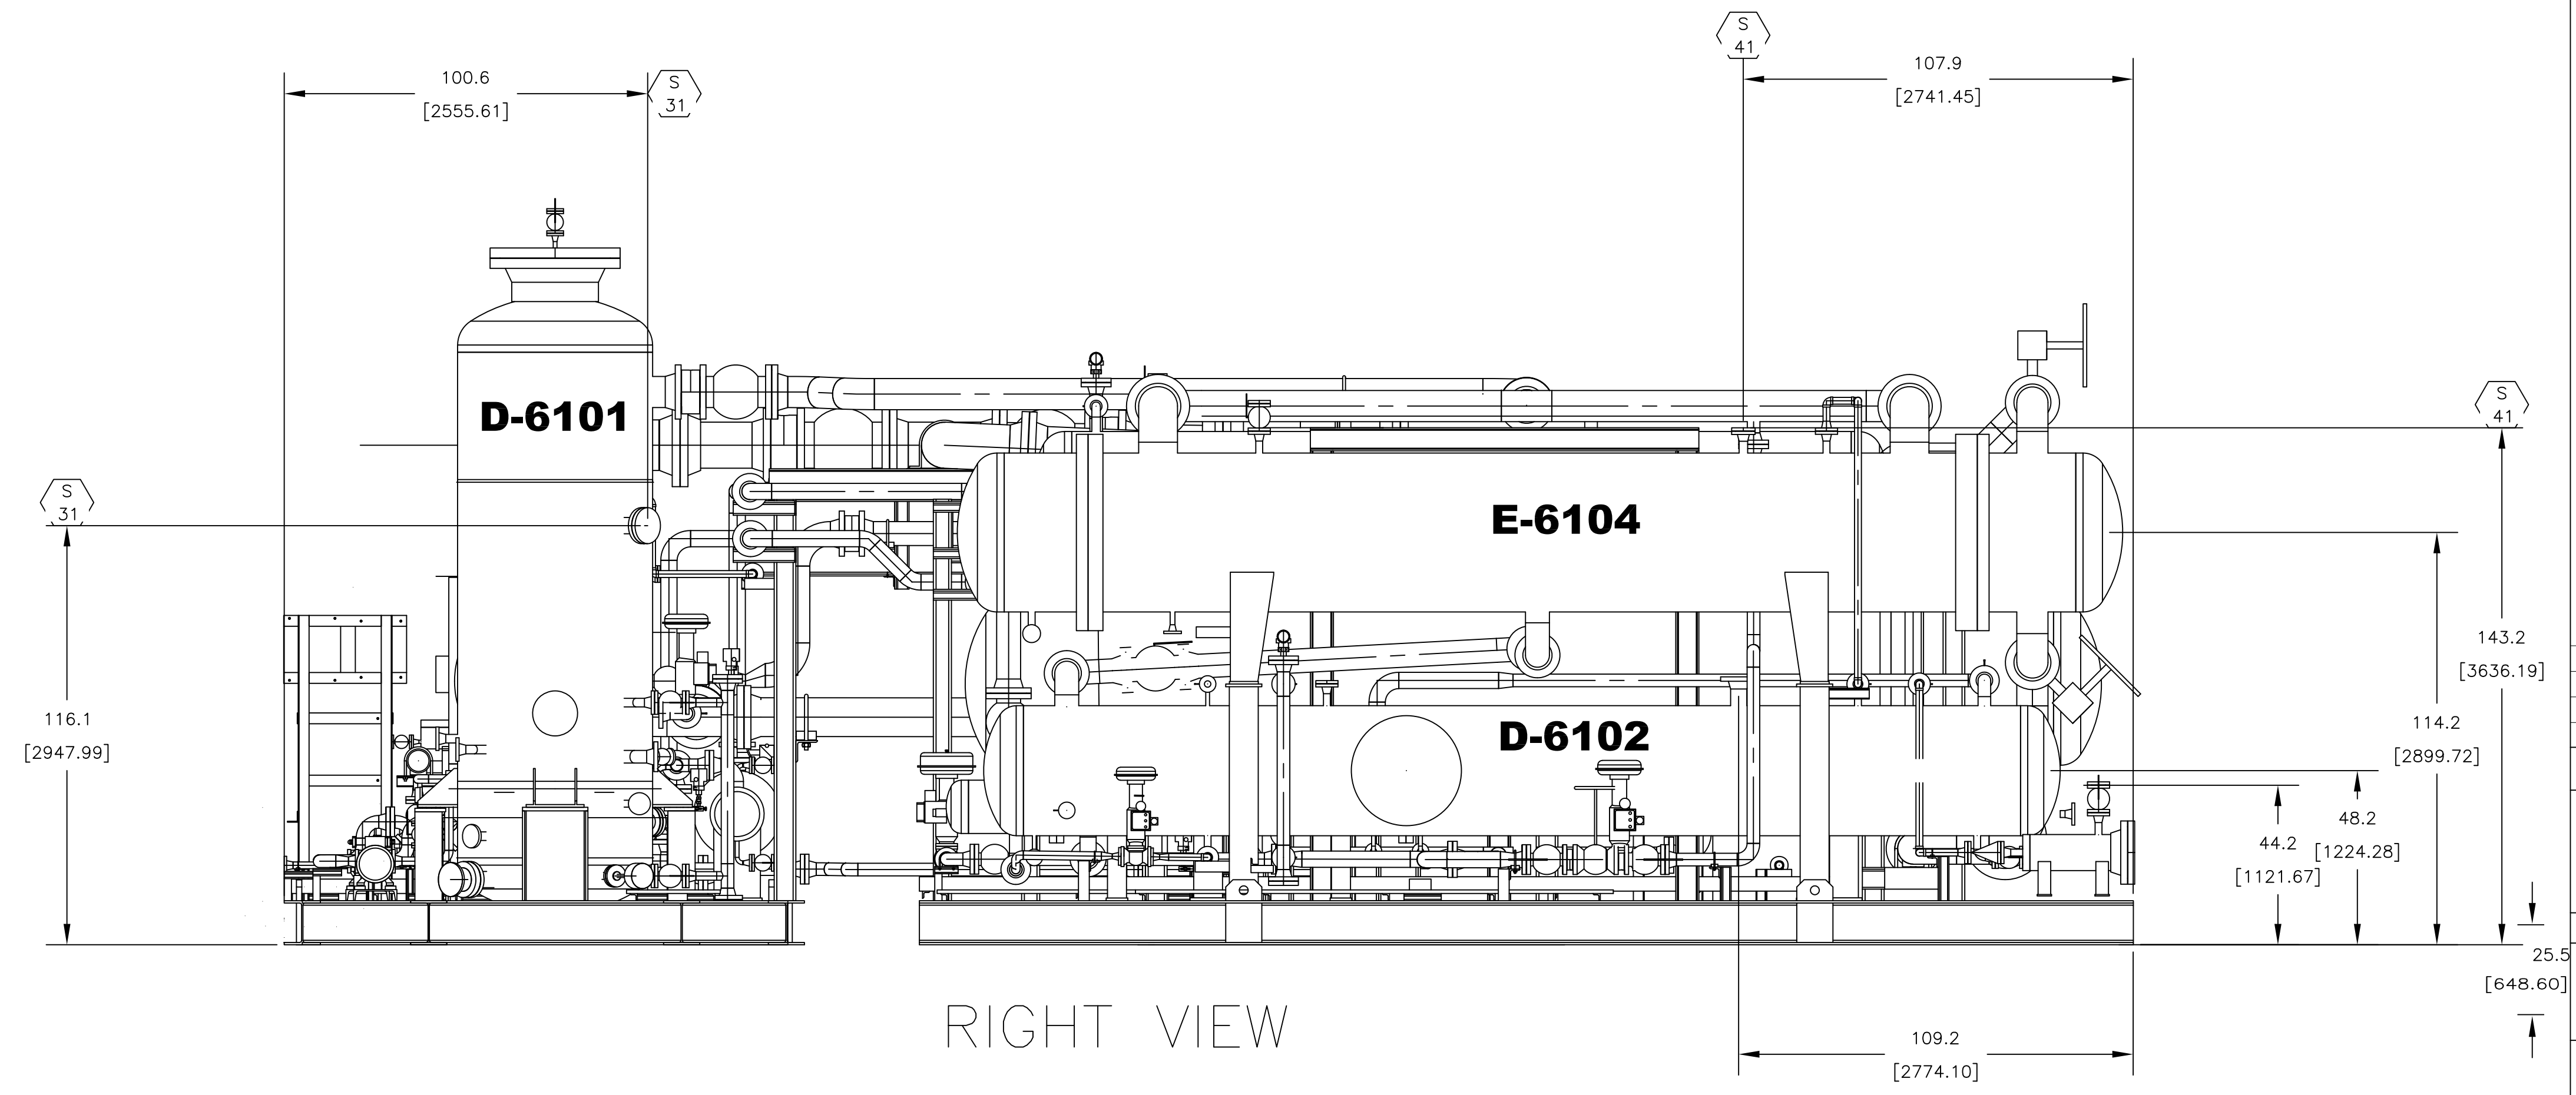

Code1	<input type="checkbox"/> No Comment/ Approved (Applicable Only for "FOR REVIEW" and "For Approval" Documents) No comment and the document are released for Manufacturing
Code2	<input type="checkbox"/> No Comment / Approved with Note(s) Vendor/Sub-Contractor shall correct, revise and resubmit the document. The document is released for Manufacturing if changes incorporated.
Code3	<input type="checkbox"/> Commented Vendor/Sub-Contractor shall correct, revise and resubmit the document by the date specified. The document shall be revised under the Status of "R: Revised Issue". All corrected documents shall be resubmitted before starting the Manufacturing Process
Code4	<input type="checkbox"/> Not Accepted (Rejected) Vendor/Sub-Contractor shall re-work/re-design/re-specify the contents of the document according to the comments/reasons for rejection. All corrected documents shall be resubmitted before starting the manufacturing. Vendor Sub-Contractor shall not proceed with subsequent works of Material Supply or Manufacturing until receiving Code1/Code2 or No Code from PURCHASER. Vendor/Sub-Contractor shall resubmit the document with the same revision within 6 working days after receiving comments
No Code	<input type="checkbox"/> No Code (Only for "For Information" Documents and "As Built DWGs") Document has been submitted for PURCHASER'S information (I). Consistency, completeness and correctness of document content is in Vendor/Sub-Contractor's responsibility.

The above checking result by EIED shall in no way relieve Vendor of any liability, obligation and responsibility out of the purchase order and the mutual agreement in writing

DATE :
DEPT :
Signature :


CV	PI	EL	IN	ME	MA
ST	BU	PR	SA	HV	TL

03	05.11.2025	IFR	FA	IM	OG
02	09.10.2025	IFR	FA	IM	OG
01	16.09.2025	IFR	FA	IM	OG
00	28.06.2025	IFR	FA	IM	OG
REV.	DATE (DD.MM.YY)	Purpose of Issue	Prepared	Checked	Approved

PO No.: GPIC-PT-MA-PO-000-3029 SCALE: 1/2":1'

DRAWING TITLE: General Arrangement Drawing (2D) ("Tie-In Points , Skid Dimensions & Orientation, Including Instrument, Junction Box and Local Panel Location Layout & Instrument Cable routing.) for Refrinerator Packera

DRAWING NO.	REV.	SHEET NO.	SIZE
VD-GPIC-MA-3029-3029-0062	03	5 of 11	A1

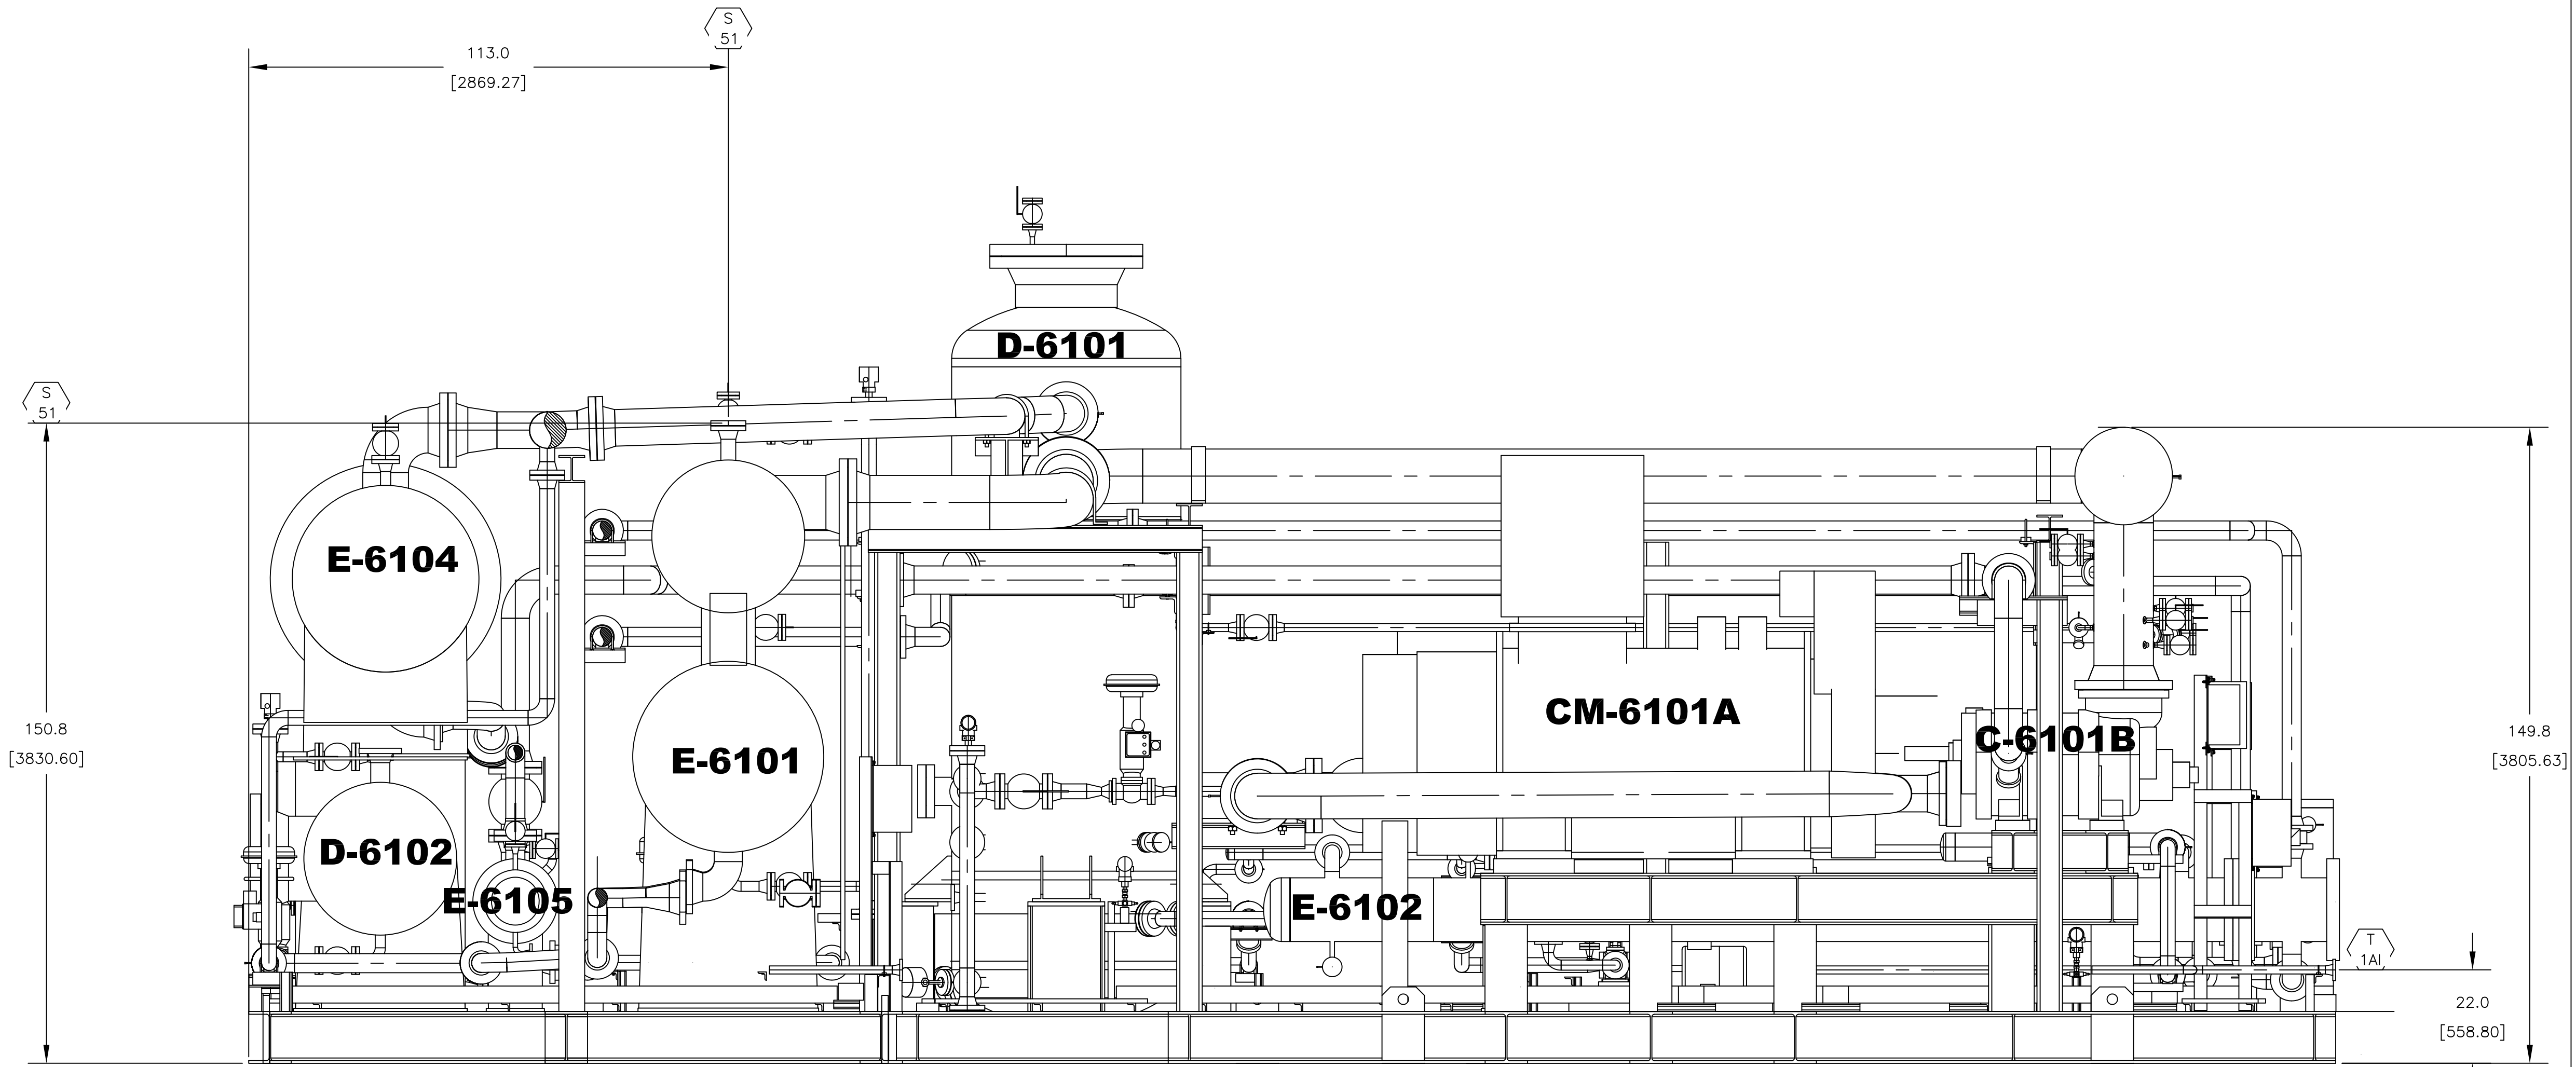

BACK VIEW





Code1	<input type="checkbox"/> No Comment / Approved (Applicable Only for "FOR REVIEW" and "For Approval" Documents) No comment and the document are released for Manufacturing
Code2	<input type="checkbox"/> No Comment / Approved with Note(s) Vendor/Sub-Contractor shall correct, revise and resubmit the document. The document is released for Manufacturing if changes incorporated.
Code3	<input type="checkbox"/> Commented Vendor/Sub-Contractor shall correct, revise and resubmit the document by the date specified. The document shall be revised under the Status of "R: Revised Issue". All corrected documents shall be resubmitted before starting the Manufacturing Process
Code4	<input type="checkbox"/> Not Accepted (Rejected) Vendor/Sub-Contractor shall re-work/re-design/re-specify the contents of the document according to the comments/reasons for rejection. All corrected documents shall be resubmitted before starting the manufacturing. Vendor Sub-Contractor shall not proceed with subsequent works of Material Supply or Manufacturing until receiving Code1/Code2 or No Code from PURCHASER. Vendor/Sub-Contractor shall resubmit the document with the same revision within 6 working days after receiving comments
No Code	<input type="checkbox"/> No Code (Only for "For Information" Documents and "As Built DWGs") Document has been submitted for PURCHASER'S information (I). Consistency, completeness and correctness of document content is in Vendor/Sub-Contractor's responsibility.

The above checking result by EIED shall in no way relieve Vendor of any liability, obligation and responsibility out of the purchase order and the mutual agreement in writing

DATE :
DEPT :
Signature :

CV	PI	EL	IN	ME	MA
ST	BU	PR	SA	HV	TL


03	05.11.2025	IFR	GA	IM	OG
02	09.10.2025	IFR	FA	IM	OG
01	16.09.2025	IFR	FA	IM	OG
00	28.06.2025	IFR	FA	IM	OG
REV.	DATE (DD.MM.YY)	Purpose of Issue	Prepared	Checked	Approved



Gachasan Polymer Industries Company
HDPE Plant



PO No.: GPIC-PT-MA-PO-000-3029 SCALE: 1/2":1'

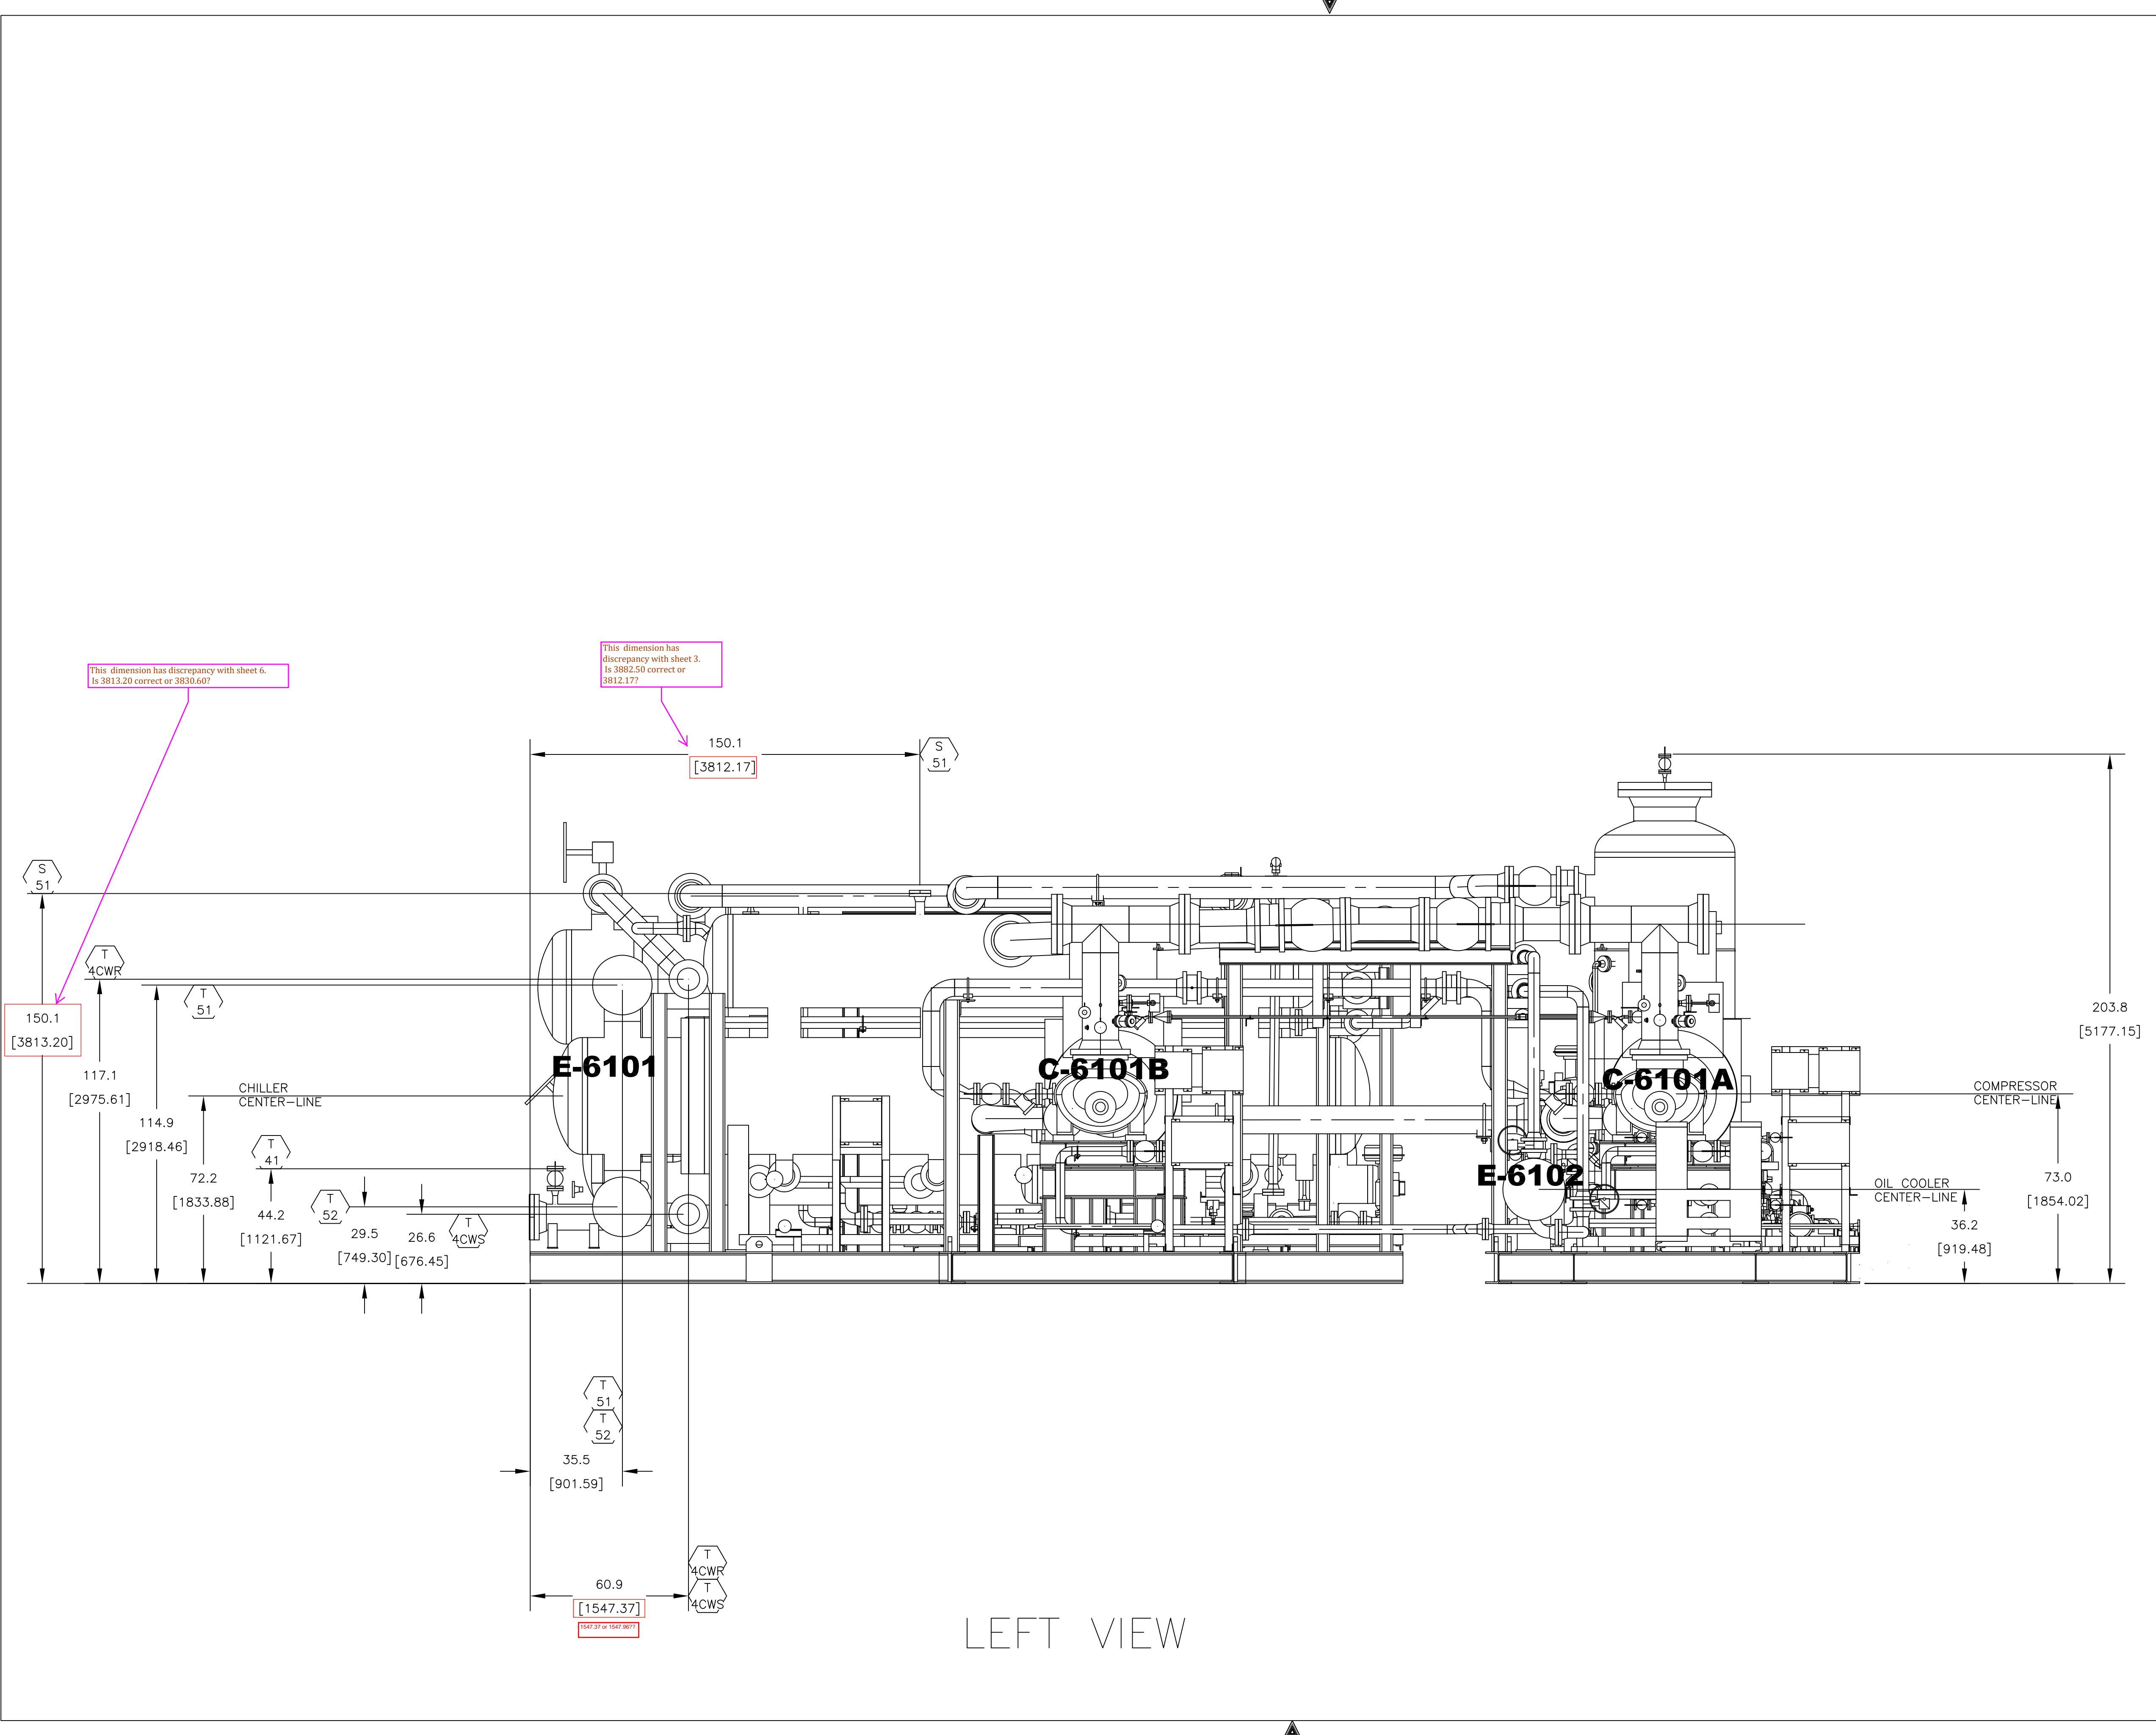DRAWING TITLE:
General Arrangement Drawing (2D) (*Tie-In Points, Skid Dimensions & Orientation, Including Instrument, Junction Box and Local Panel Location Layout & Instrument Cable routing.)
for Refinerator Packana

DRAWING NO.	VD-GPIC-MA-3029-3029-0062	REV.	SHEET NO.	SIZE
		03	6 of 11	A1



LEFT VIEW

Code1	<input type="checkbox"/> No Comment/ Approved (Applicable Only for "FOR REVIEW" and "For Approval" Documents) No comment and the document are released for Manufacturing				
Code2	<input type="checkbox"/> No Comment / Approved with Note(s) Vendor/Sub-Contractor shall correct, revise and resubmit the document. The document is released for Manufacturing if changes incorporated.				
Code3	<input type="checkbox"/> Commented Vendor/Sub-Contractor shall correct, revise and resubmit the document by the date specified. The document shall be revised under the Status of "R: Revised Issue". All corrected documents shall be resubmitted before starting the Manufacturing Process				
Code4	<input type="checkbox"/> Not Accepted (Rejected) Vendor/Sub-Contractor shall re-work/re-design/re-specify the contents of the document according to the comments/reasons for rejection. All corrected documents shall be resubmitted before starting the manufacturing. Vendor/Sub-Contractor shall not proceed with subsequent work of Material Supply or Manufacturing until receiving Code1/Code2 or No Code from PURCHASER. Vendor/Sub-Contractor shall resubmit the document with the same revision within 6 working days after receiving comments				
No Code	<input type="checkbox"/> No Code (Only for "For Information" Documents and "As Built DWGs") Document has been submitted for PURCHASER'S Information (I). Consistency, completeness and correctness of document content is in Vendor/Sub-Contractor's responsibility. The above checking result by EIED shall in no way relieve Vendor of any liability, obligation and responsibility out of the purchase order and the mutual agreement in writing				
DATE :					
DEPT:					
Signature :					
CV	PI	EL	IN	ME	MA
ST	BU	PR	SA	HV	TL


03	05.11.2025	IFR	FA	IM	OG
02	09.10.2025	IFR	FA	IM	OG
01	16.09.2025	IFR	FA	IM	OG
00	28.06.2025	IFR	FA	IM	OG
REV.	DATE (dd.MM.YY)	Purpose of Issue	Prepared	Checked	Approved

Gachasan Plyomer Industries Company
HDPE Plant

PO No.: GPIC-PT-MA-PO-000-3029 SCALE: 3/8":1'

DRAWING TITLE:
General Arrangement Drawing (2D) ("Tie-In Points , Skid Dimensions & Orientation, Including Instrument, Junction Box and Local Panel Location Layout & Instrument Cable routing.) for Refrinator Parkane

DRAWING NO.	VD-GPIC-MA-3029-3029-0062	REV.	SHEET NO.	SIZE
		03	7 of 11	A1

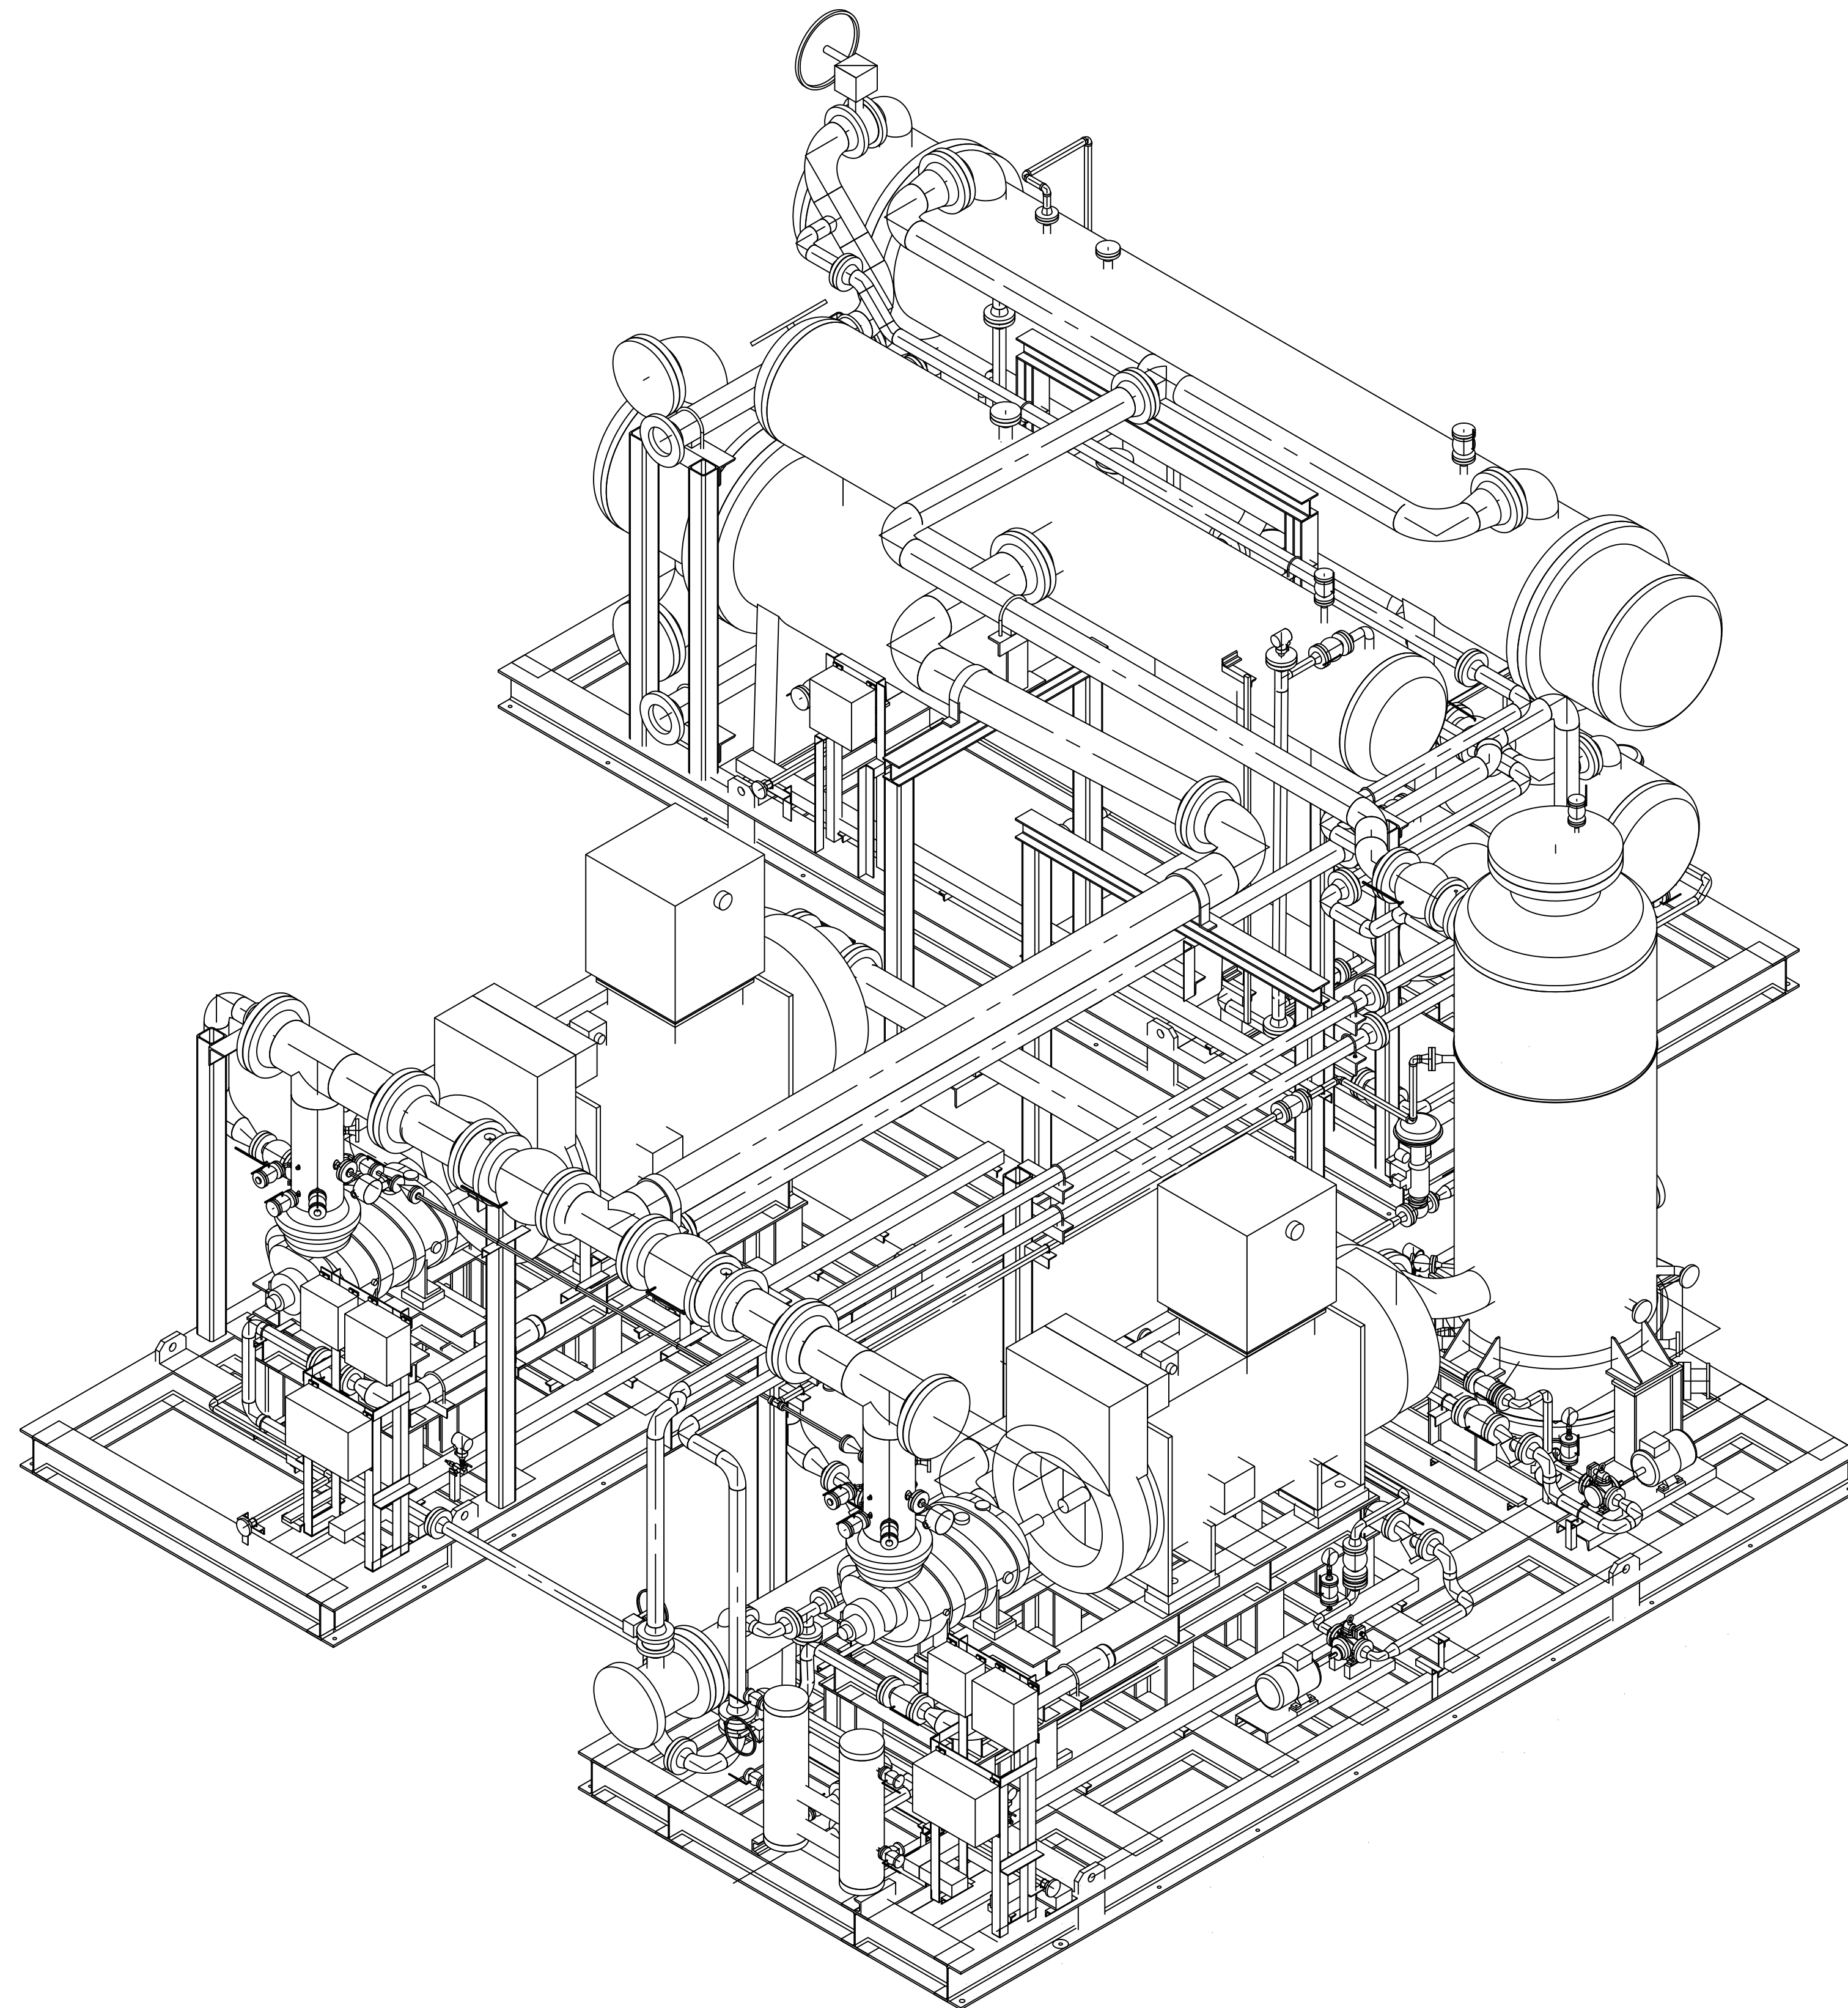

Code1 No Comment/ Approved
(Applicable Only for "FOR REVIEW" and "For Approval" Documents) No comment and the document are released for Manufacturing

Code2 No Comment / Approved with Note(s)
Vendor/Sub-Contractor shall correct, revise and resubmit the document. The document is released for Manufacturing if changes incorporated.

Code3 Commented
Vendor/Sub-Contractor shall correct, revise and resubmit the document by the date specified. The document shall be revised under the Status of "R: Revised Issue". All corrected documents shall be resubmitted before starting the Manufacturing Process

Code4 Not Accepted (Rejected)
Vendor/Sub-Contractor shall re-work/re-design/re-specify the contents of the document according to the comments/reasons for rejection. All corrected documents shall be resubmitted before starting the manufacturing Vendor Sub-Contractor shall not proceed with subsequent works of Material Supply or Manufacturing until receiving Code1/Code2 or No Code from PURCHASER. Vendor/Sub-Contractor shall resubmit the document with the same revision within 6 working days after receiving comments

No Code No Code
(Only for "For Information" Documents and "As Built DWG's") Document has been submitted for PURCHASER's Information (I). Consistency, completeness and correctness of document content is in Vendor/Sub-Contractor's responsibility.

The above checking result by EIED shall in no way relieve Vendor of any liability, obligation and responsibility out of the purchase order and the mutual agreement in writing

EIED

DATE :
DEPT :
Signature :

CV	PI	EL	IN	ME	MA
ST	BU	PR	SA	HV	TL


03	05.11.2025	IFR	FA	IM	OG
02	09.10.2025	IFR	FA	IM	OG
01	16.09.2025	IFR	FA	IM	OG
00	28.06.2025	IFR	FA	IM	OG
REV.	DATE (DD.MM.YY)	Purpose of Issue	Prepared	Checked	Approved


		Gacharan Polymer Industries Company HDPE Plant		
--	--	---	--	--

PO No.: GPIC-PT-MA-PO-000-3029 SCALE: 3/8":1'



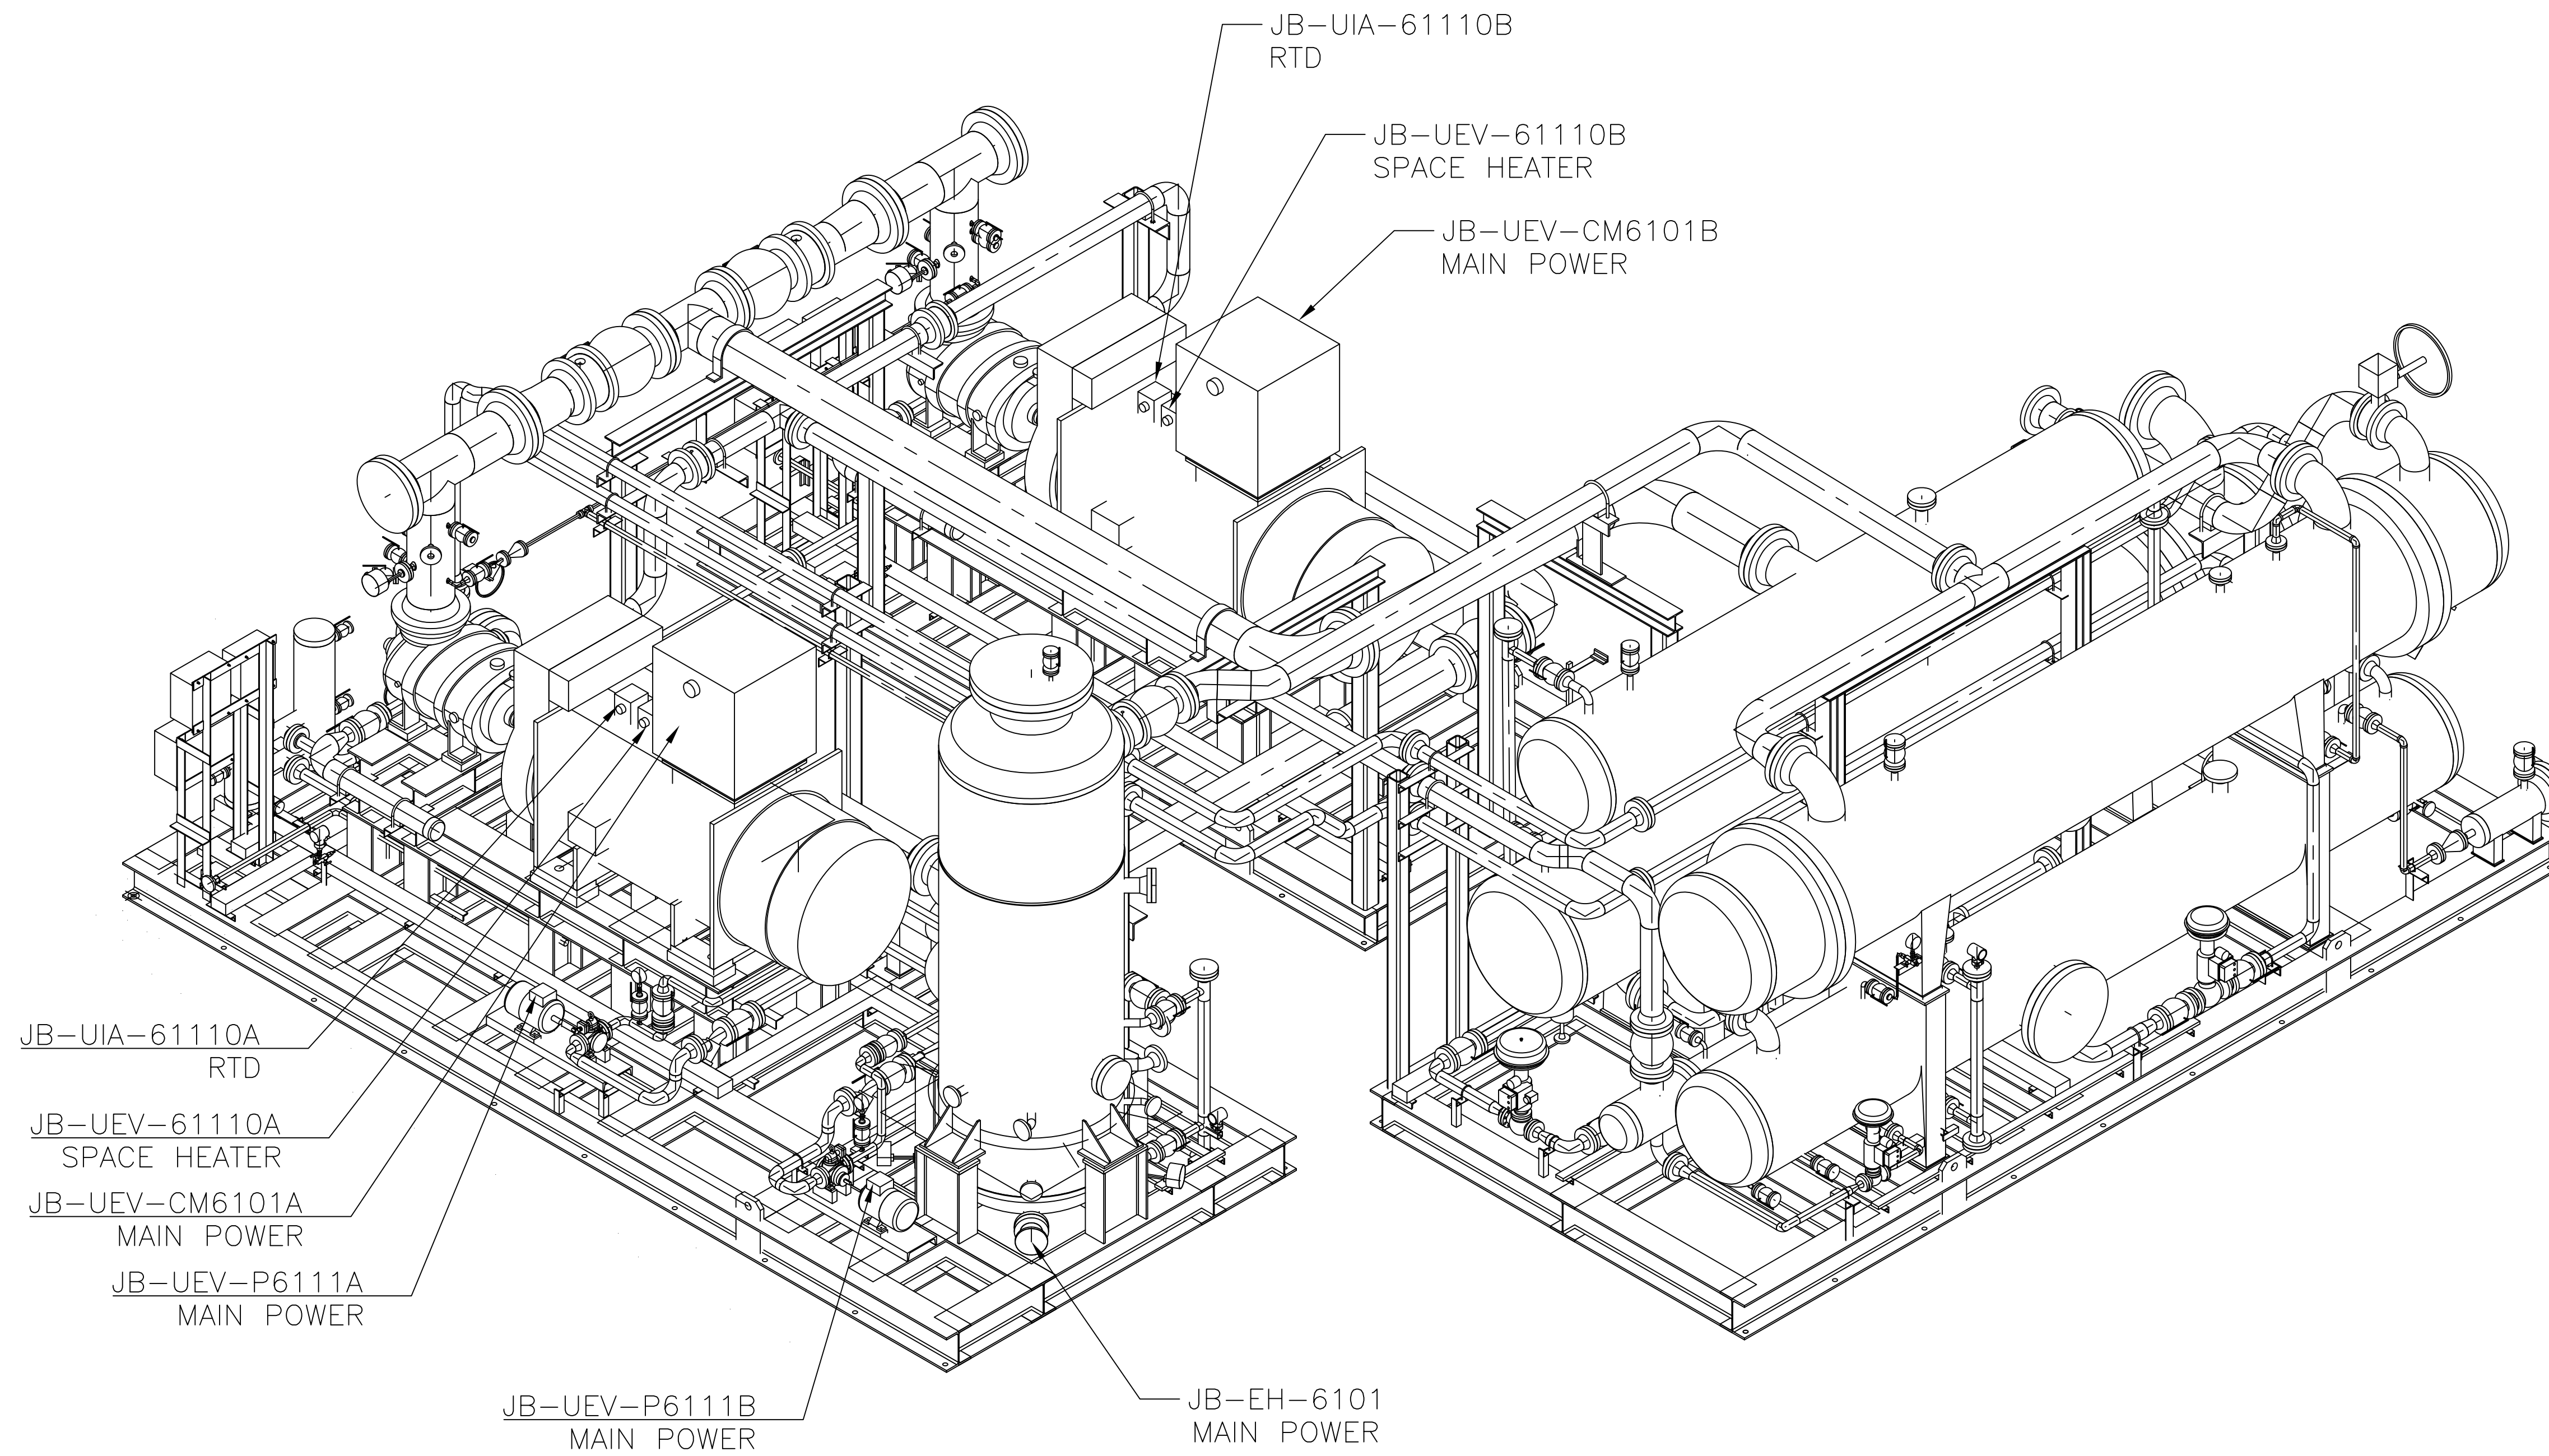

DRAWING TITLE:
General Arrangement Drawing (2D) ("Tie-In Points, Skid Dimensions & Orientation, Including Instrument, Junction Box and Local Panel Location Layout & Instrument Cable routing.")
for Refrinerator Parkane


DRAWING NO.	REV.	SHEET NO.	SIZE
VD-GPIC-MA-3029-3029-0062	03	8 OF 11	A1



Code1	<input type="checkbox"/> No Comment/ Approved (Applicable Only for "FOR REVIEW" and "For Approval" Documents) No comment and the document are released for Manufacturing				
Code2	<input type="checkbox"/> No Comment / Approved with Note(s) Vendor/Sub-Contractor shall correct, revise and resubmit the document. The document is released for Manufacturing if changes incorporated.				
Code3	<input type="checkbox"/> Commented Vendor/Sub-Contractor shall correct, revise and resubmit the document by the date specified. The document shall be revised under the Status of "R: Revised Issue". All corrected documents shall be resubmitted before starting the Manufacturing Process				
Code4	<input type="checkbox"/> Not Accepted (Rejected) Vendor/Sub-Contractor shall re-work/re-design/re-specify the contents of the document according to the comments/reasons for rejection. All corrected documents shall be resubmitted before starting the manufacturing. Vendor/Sub-Contractor shall not proceed with subsequent works of Material Supply or Manufacturing until receiving Code1/Code2 or No Code from PURCHASER. Vendor/Sub-Contractor shall resubmit the document with the same revision within 6 working days after receiving comments				
No Code	<input type="checkbox"/> No Code (Only for "For Information" Documents and "As Built DWGs") Document has been submitted for PURCHASER'S information (I). Consistency, completeness and correctness of document content is in Vendor/Sub-Contractor's responsibility.				
The above checking result by EIED shall in no way relieve Vendor of any liability, obligation and responsibility out of the purchase order and the mutual agreement in writing					
 DATE : DEPT : Signature :					
CV	PI	EL	IN	ME	MA
ST	BU	PR	SA	HV	TL

03	05.11.2025	IFR	FA	IM	OG
02	09.10.2025	IFR	FA	IM	OG
01	16.09.2025	IFR	FA	IM	OG
00	28.06.2025	IFR	FA	IM	OG
REV.	DATE (DD.MM.YY)	Purpose of Issue	Prepared	Checked	Approved


 Gachasan Polymer Industries Company	 Gachasan Polymer Industries Company HDPE Plant	 RHINE	 EIED
DRAWING TITLE: General Arrangement Drawing (2D) ("Tie-In Points , Skid Dimensions & Orientation, Including Instrument, Junction Box and Local Panel Location Layout & Instrument Cable routing.) for Refrinator Parkane			
DRAWING NO. VD-GPIC-MA-3029-3029-0062	REV. 03	SHEET NO. 9 OF 11	SIZE A1

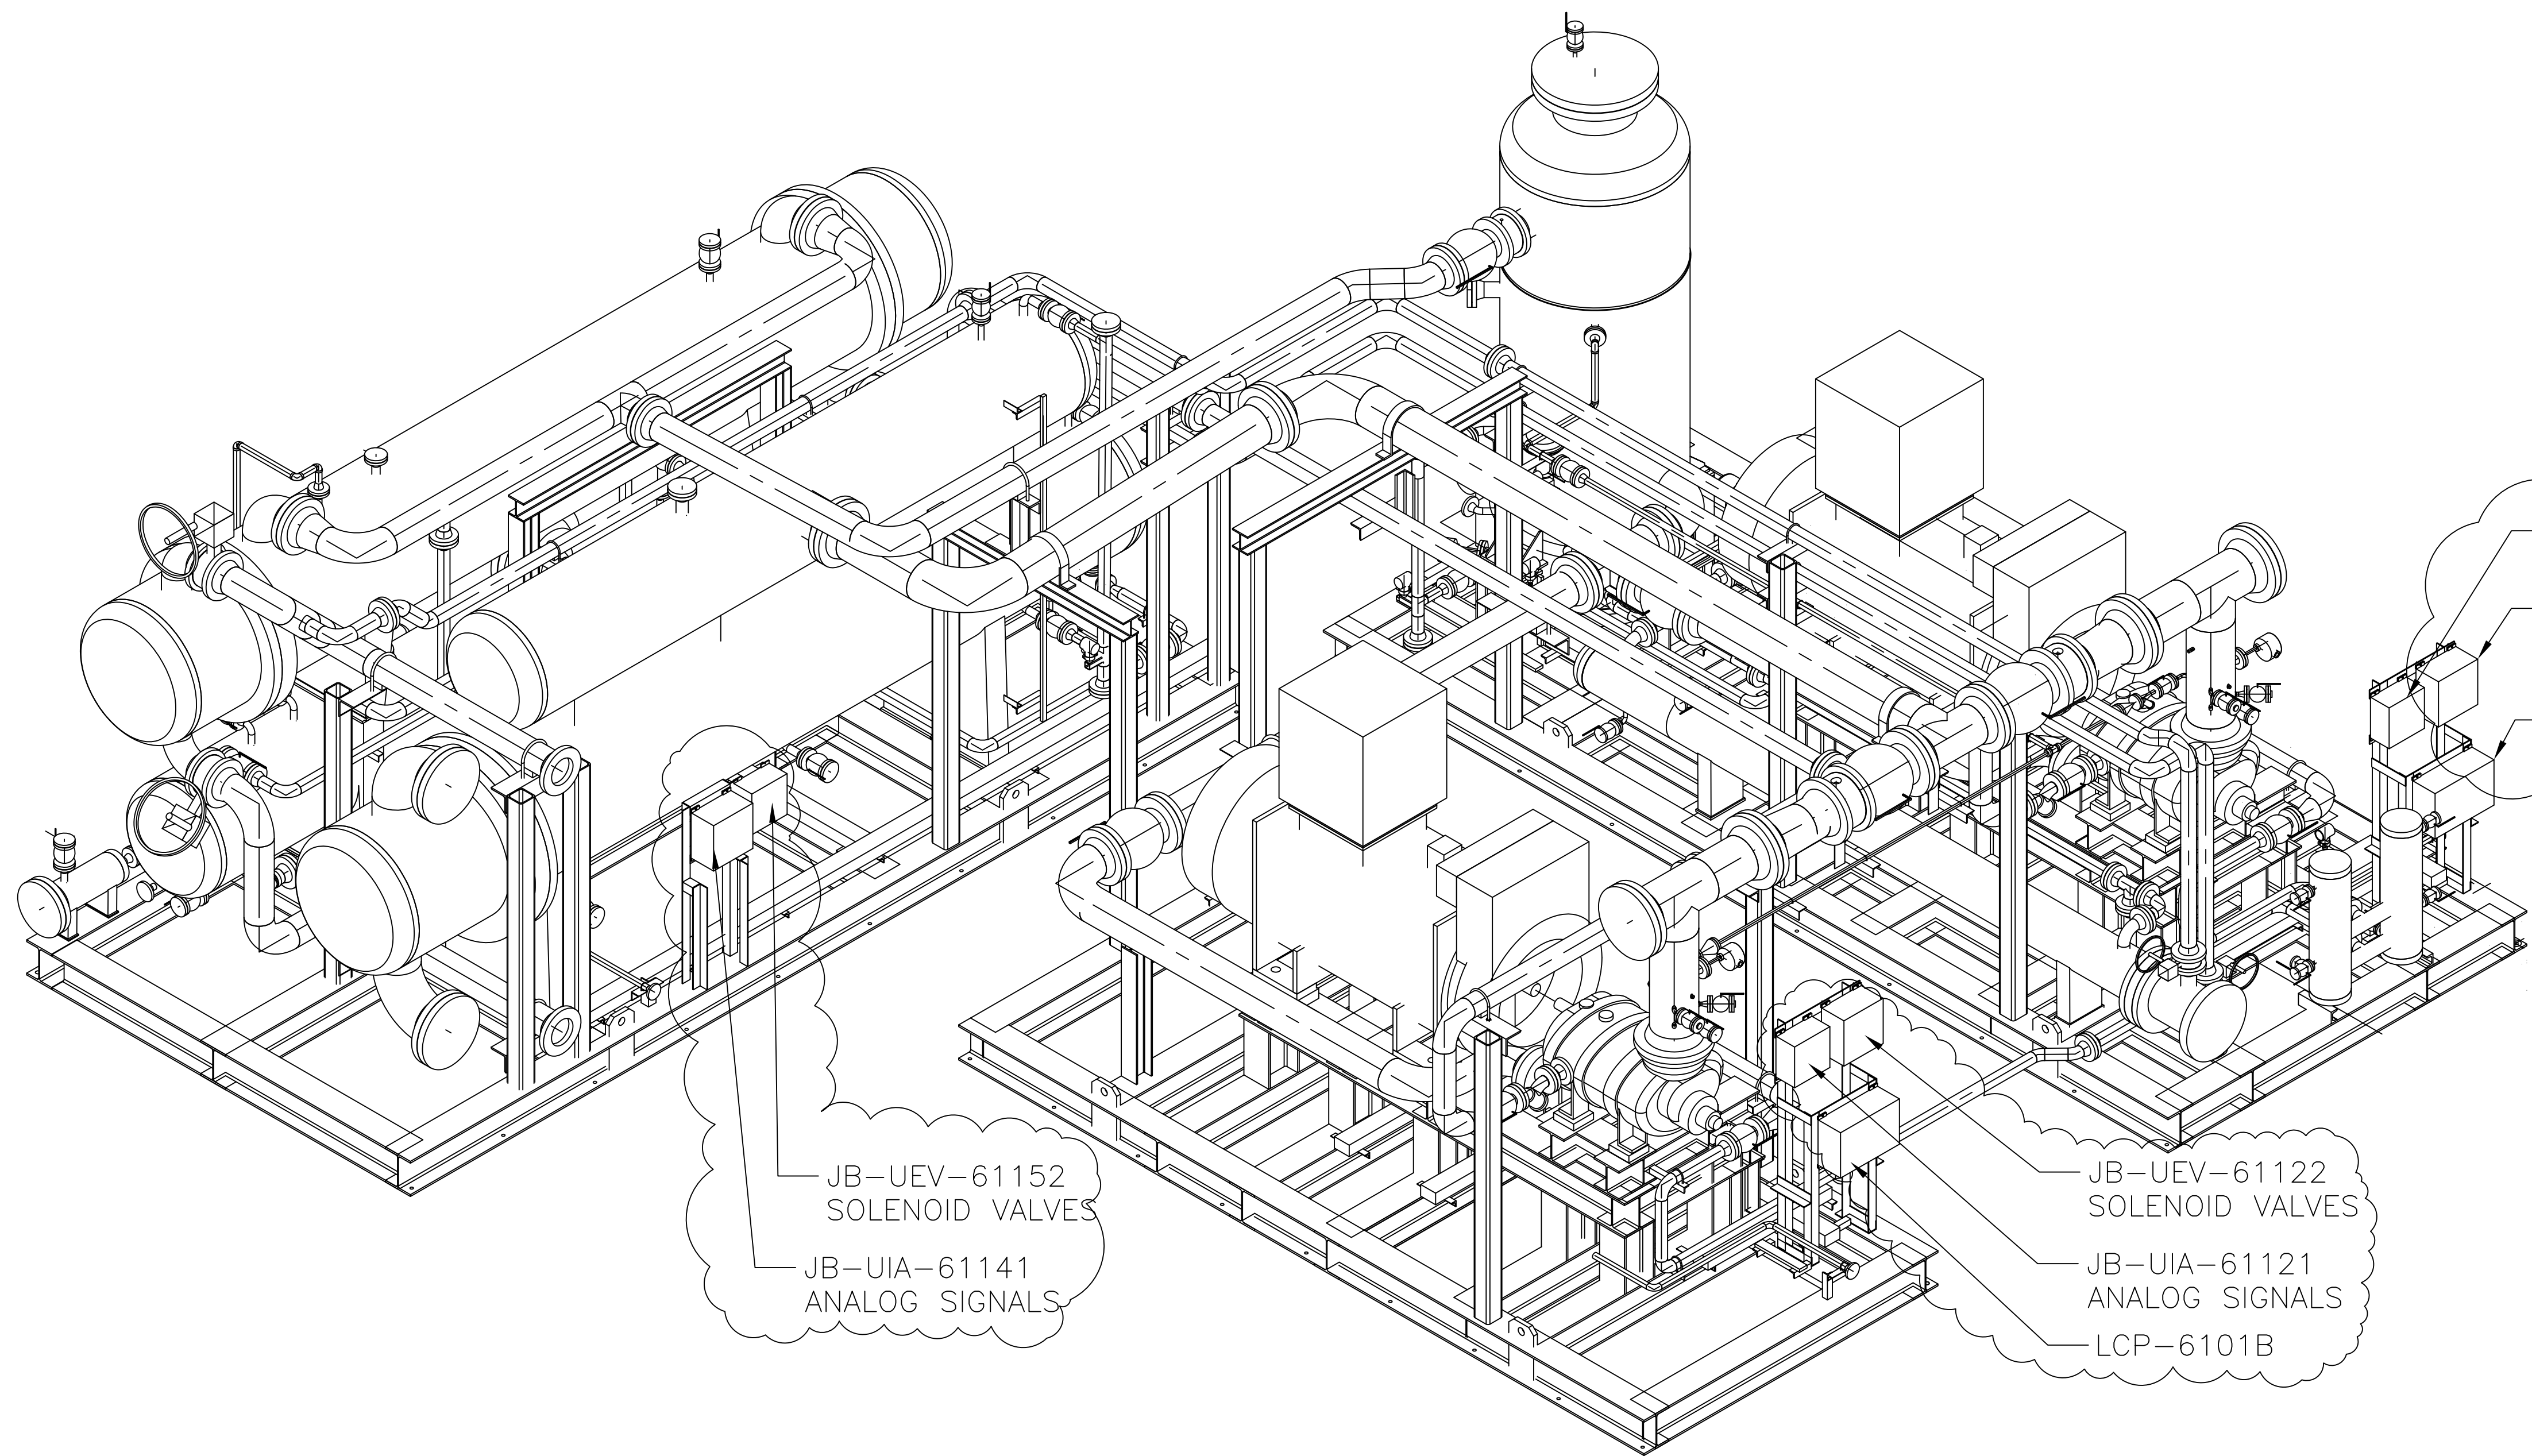





JB-UEV-61152
SOLENOID VALVES
JB-UIA-61141
ANALOG SIGNALS

JB-UEV-61112
SOLENOID VALVES
JB-UIA-61111
ANALOG SIGNALS
LCP-6101A

JB-UEV-61122
SOLENOID VALVES
JB-UIA-61121
ANALOG SIGNALS
LCP-6101B

Code1	<input type="checkbox"/> No Comment/ Approved (Applicable Only for "FOR REVIEW" and "For Approval" Documents) No comment and the document are released for Manufacturing				
Code2	<input type="checkbox"/> No Comment / Approved with Note(s) Vendor/Sub-Contractor shall correct, revise and resubmit the document. The document is released for Manufacturing if changes incorporated.				
Code3	<input type="checkbox"/> Commented Vendor/Sub-Contractor shall correct, revise and resubmit the document by the date specified. The document shall be revised under the Status of "R: Revised Issue". All corrected documents shall be resubmitted before starting the Manufacturing Process				
Code4	<input type="checkbox"/> Not Accepted (Rejected) Vendor/Sub-Contractor shall re-work/re-design/re-specify the contents of the document according to the comments/reasons for rejection. All corrected documents shall be resubmitted before starting the manufacturing. Vendor Sub-Contractor shall not proceed with subsequent works of Material Supply or Manufacturing until receiving Code1/Code2 or No Code from PURCHASER. Vendor/Sub-Contractor shall resubmit the document with the same revision within 6 working days after receiving comments				
No Code	<input type="checkbox"/> No Code (Only for "For Information" Documents and "As Built DWGs") Document has been submitted for PURCHASER'S information (I). Consistency, completeness and correctness of document content is in Vendor/Sub-Contractor's responsibility.				
The above checking result by EIED shall in no way relieve Vendor of any liability, obligation and responsibility out of the purchase order and the mutual agreement in writing					
 DATE : DEPT : Signature :					
CV	PI	EL	IN	ME	MA
ST	BU	PR	SA	HV	TL


03	05.11.2025	IFR	FA	IM	OG
02	09.10.2025	IFR	FA	IM	OG
01	16.09.2025	IFR	FA	IM	OG
00	28.06.2025	IFR	FA	IM	OG
REV.	DATE (DD.MM.YY)	Purpose of Issue	Prepared	Checked	Approved




Gacharan Polymer Industries Company
HDPE Plant



PO No.: GPIC-PT-MA-PO-000-3029 SCALE: 3/8":1'

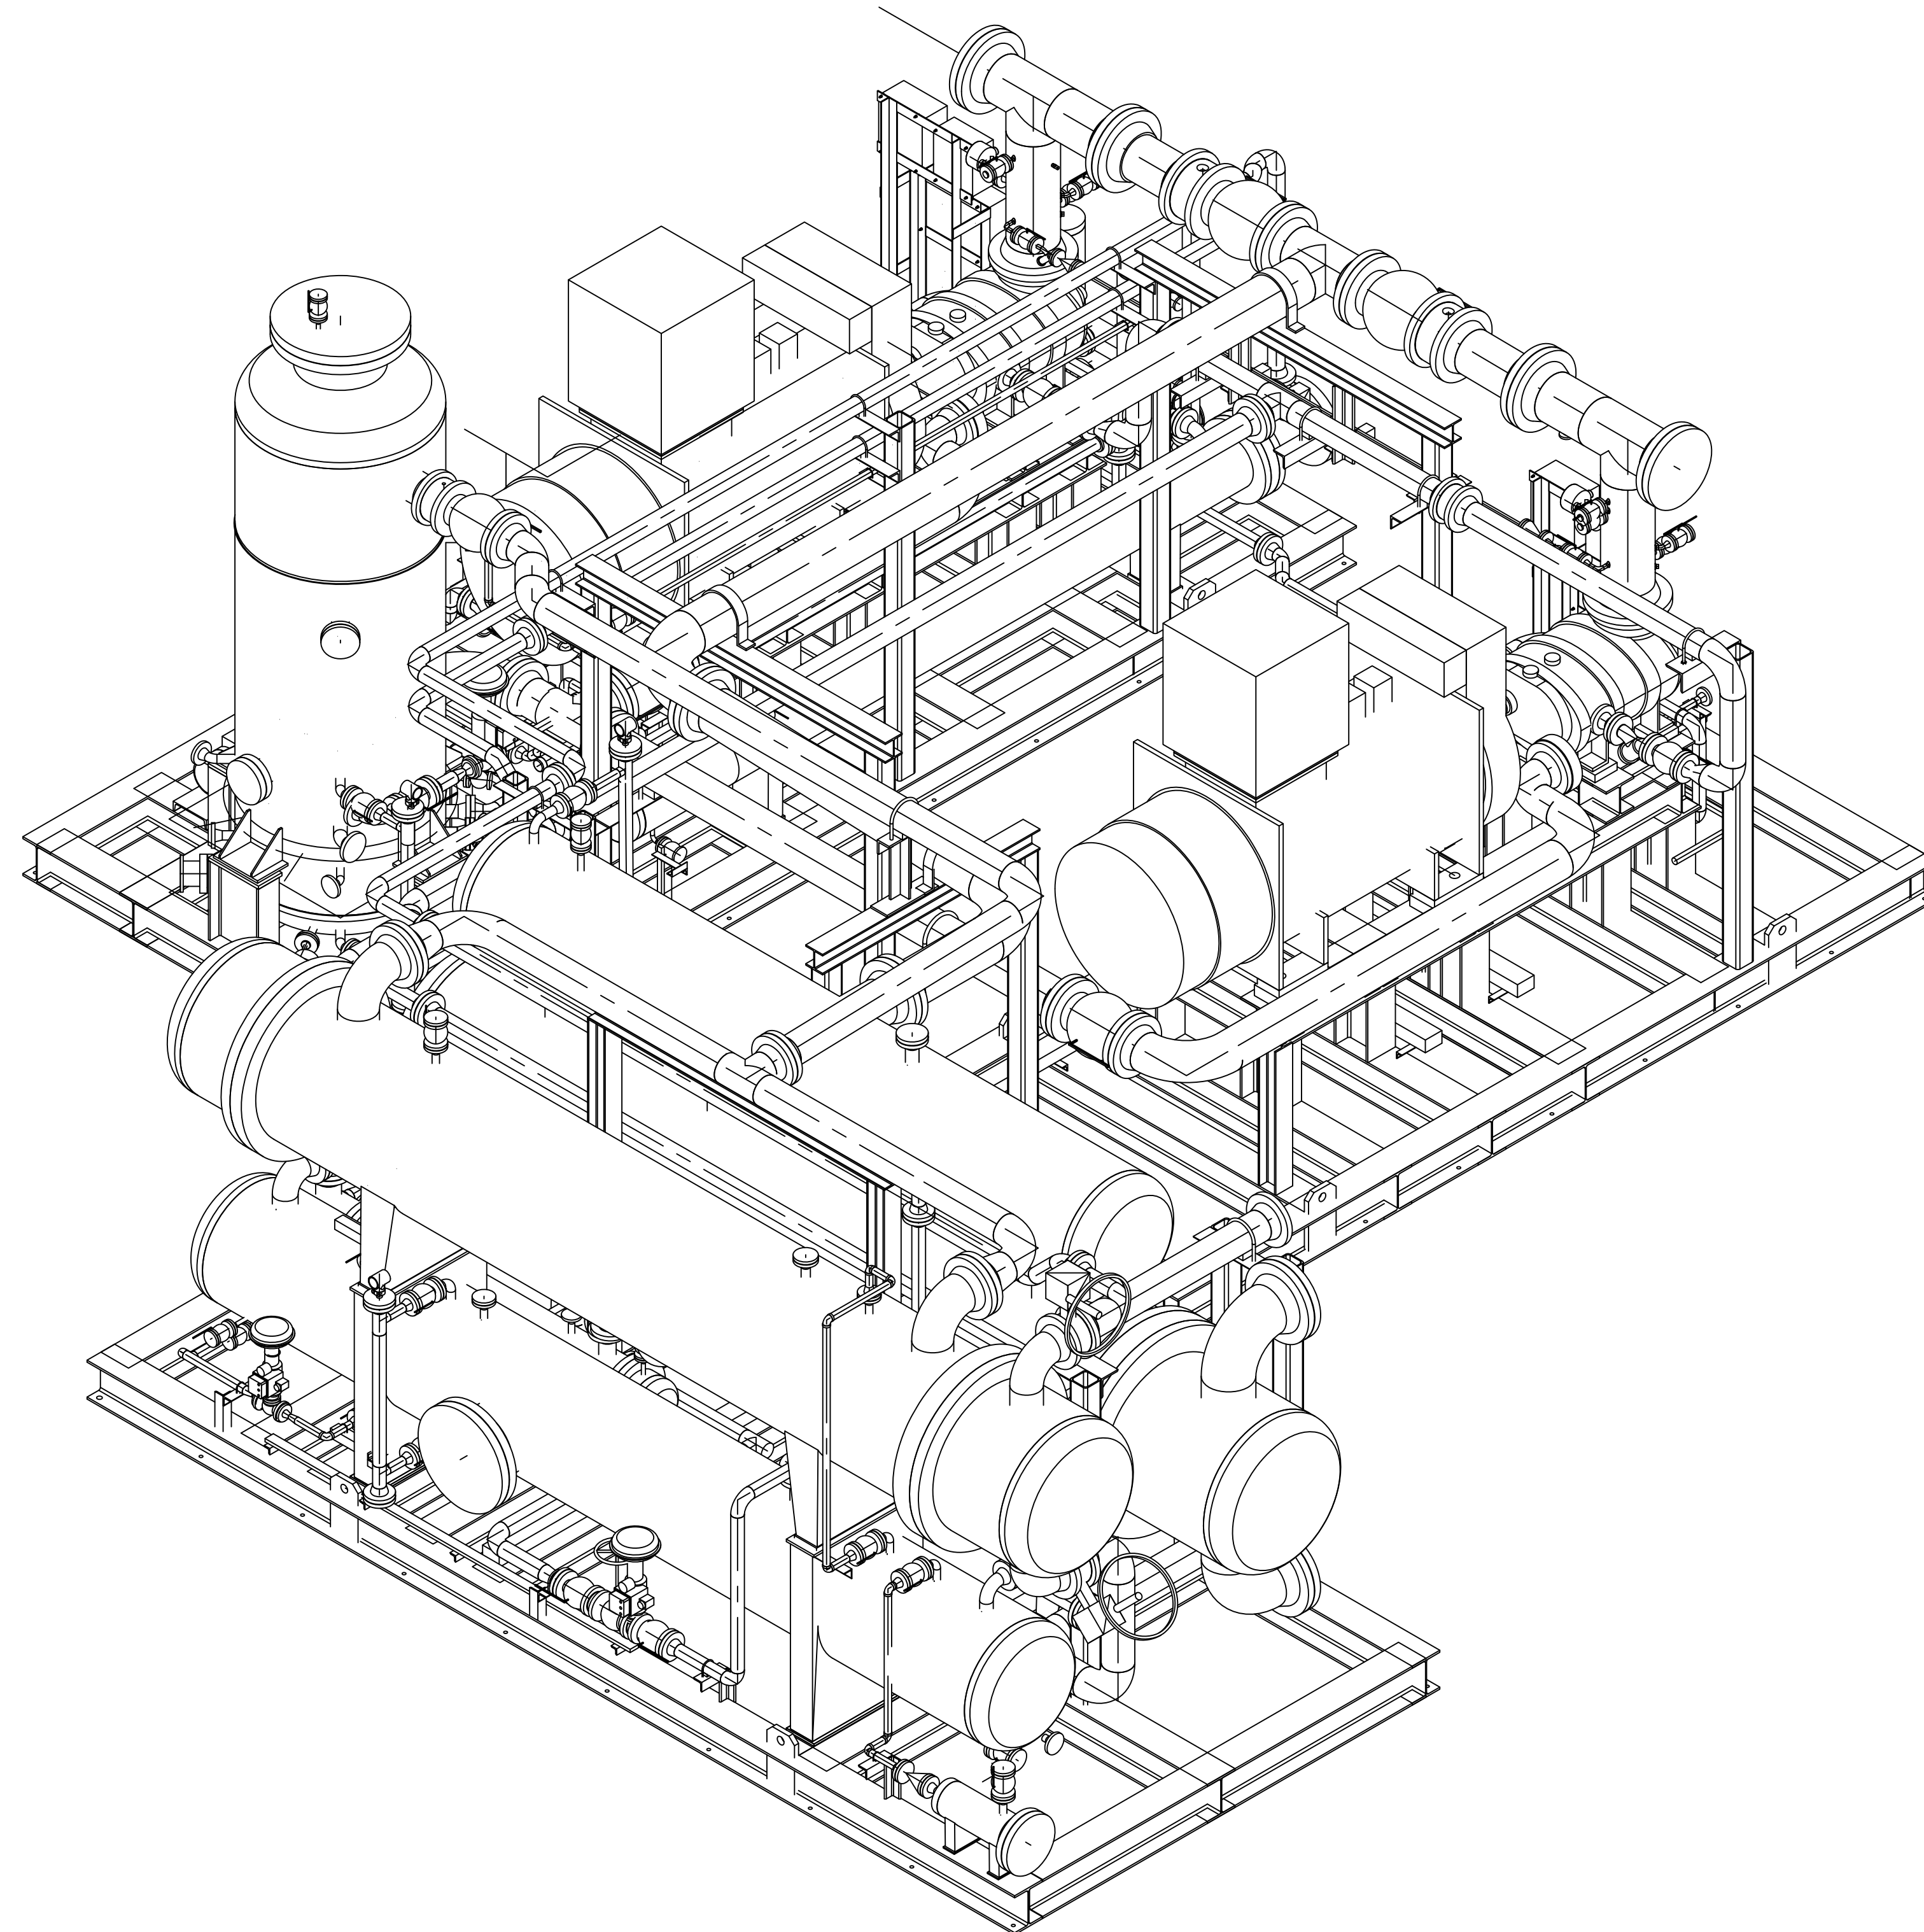

DRAWING TITLE:
General Arrangement Drawing (2D) (*Tie-In Points, Skid Dimensions & Orientation, Including Instrument Junction Box and Local Panel Location Layout & Instrument Cable routing.) for Refrinerator Package

DRAWING NO.	VD-GPIC-MA-3029-3029-0062	REV.	SHEET NO.	SIZE
		03	10 OF 11	A1



Code1	<input type="checkbox"/> No Comment/ Approved (Applicable Only for "FOR REVIEW" and "For Approval" Documents) No comment and the document are released for Manufacturing				
Code2	<input type="checkbox"/> No Comment / Approved with Note(s) Vendor/Sub-Contractor shall correct, revise and resubmit the document. The document is released for Manufacturing if changes incorporated.				
Code3	<input type="checkbox"/> Commented Vendor/Sub-Contractor shall correct, revise and resubmit the document by the date specified. The document shall be revised under the Status of "R: Revised Issue". All corrected documents shall be resubmitted before starting the Manufacturing Process				
Code4	<input type="checkbox"/> Not Accepted (Rejected) Vendor/Sub-Contractor shall re-work/re-design/re-specify the contents of the document according to the comments/reasons for rejection. All corrected documents shall be resubmitted before starting the manufacturing. Vendor Sub-Contractor shall not proceed with subsequent work of Material Supply or Manufacturing until receiving Code1/Code2 or No Code from PURCHASER. Vendor/Sub-Contractor shall resubmit the document with the same revision within 6 working days after receiving comments				
No Code	<input type="checkbox"/> No Code (Only for "For Information" Documents and "As Built DWGs") Document has been submitted for PURCHASER'S information (I). Consistency, completeness and correctness of document content is in Vendor/Sub-Contractor's responsibility. The above checking result by EIED shall in no way relieve Vendor of any liability, obligation and responsibility out of the purchase order and the mutual agreement in writing				
 DATE : _____ DEPT: _____ Signature : _____					
CV	PI	EL	IN	ME	MA
ST	BU	PR	SA	HV	TL

03	05.11.2025	IFR	FA	IM	OG
02	09.10.2025	IFR	FA	IM	OG
01	16.09.2025	IFR	FA	IM	OG
00	28.06.2025	IFR	FA	IM	OG
REV.	DATE (DD.MM.YY)	Purpose of Issue	Prepared	Checked	Approved

 Gachasan Polymer Industries Company	 EIED	Gachasan Polymer Industries Company HDPE Plant		
		PO No.: GPIC-PT-MA-PO-000-3029 SCALE: 3/8":1'		
DRAWING TITLE: General Arrangement Drawing (2D) (*Tie-In Points , Skid Dimensions & Orientation, Including Instrument, Junction Box and Local Panel Location Layout & Instrument Cable routing.) for Refrinerator Parkane				
DRAWING NO.	VD-GPIC-MA-3029-3029-0062	REV.	SHEET NO.	SIZE
		03	11 OF 11	A1