



 Gachsaran Polymer Industries Company PIDMCO	Gachsaran Polymer Industries Company HDPE Plant		
	General Arrangement Drawing (2D) (Tie-In Points , Skid Dimensions & Orientation, Including Instrument, Junction Box and Local Panel Location Layout & Instrument Cable routing.) for Refrigerator Package	 	
PO No.: GPIC-PT-MA-PO-000-3029	Document Number: VD-GPIC-MA-3029-3029-0062	Rev. 04	Page 1 of 12

General Arrangement Drawing (2D) (Tie-In Points , Skid Dimensions & Orientation, Including Instrument, Junction Box and Local Panel Location Layout & Instrument Cable routing.) for Refrigerator Package

Code1	<input type="checkbox"/> No Comment/ Approved (Applicable Only for "FOR REVIEW" and "For Approval" Documents) No comment and the document are released for Manufacturing.
Code2	<input type="checkbox"/> No Comment/ Approved with Note(s) Vendor/Sub-Contractor shall correct, revise and resubmit the document. The document is released for Manufacturing if changes incorporated.
Code3	<input checked="" type="checkbox"/> Commented Vendor/Sub-Contractor shall correct, revise and resubmit the document by the date specified. The document shall be revised under the Status of "R: Revised Issue". All corrected documents shall be resubmitted before starting the Manufacturing Process.
Code 4	<input type="checkbox"/> Not Accepted (Rejected) Vendor/Sub-Contractor shall re-work / re-design / re-specify the contents of the document according to the comments / reasons for rejection. All corrected documents shall be resubmitted before starting the manufacturing. Vendor/Sub-Contractor shall not proceed with subsequent works of Material Supply or Manufacturing until receiving Code1/Code2 or No Code from PURCHASER. Vendor/Sub-Contractor shall resubmit the document with the same revision within 6 working days after receiving comments.
No code	<input type="checkbox"/> No Code (Applicable Only for "For Information" Documents and "As Built DWGs") Document has been submitted for PURCHASER's Information (FI). Consistency, completeness and correctness of document content is in Vendor/Sub-Contractor's responsibility.
Above checking results by EIED shall in no way relieve Vendor of any liability, obligation and responsibility out of the purchase order and the mutual agreement in writing.	
 EIED Energy Industries Engineering & Design co.	Date: Jan. 05, 2026 Dept.: MA Signature: F.Hamooni

04	20-Dec-25	IFR	A.M	A.M	F.T
03	5-Nov-25	IFR	A.M	A.M	F.T
02	9-Oct-25	IFR	N.B	A.M	F.T
01	16-Sep-25	IFR	A.M	A.M	F.T
00	28-Jun-25	IFR	A.M	A.M	F.T
Rev.	DATE	PURPOSE OF ISSUE	PREPARED	CHECKED	APPROVED

This document is the sole property of GPIC and all information contained herein may neither be reproduced, used, disclosed, transmitted nor in any way made public without permission of the OWNER.


NORTH

PI-02 (REPEATED COMMENT):
The customer (EIED) shall be provided with the STP file of model.
Since location some of TI-INs (S-41, S-42, S-43, S-44, S-31) are inside package and the direct connection of some lines may cause clashes with the lines and equipments inside the package so the TI in/out shall be skids or STP file shall be sent.

EL01: (Major and Repeated)
As indicated, the electrical trench is located on the western side of the skid. Considering that the compressors are positioned at a distance from the skid edge, a cable tray shall be provided to route the cables from the ground level up to the terminals of each compressor. In addition, suitable cable trays shall be considered for power supply to the oil heater and for the LCP communication cables, and these shall also be reflected in Document number 'VD-GPIC-MA-3029-3029-0047'.

EL02: (Major)
Considering that this package is exposed to direct sunlight, a sun canopy shall be provided for each of the compressors.

EL03: (Major and Repeated)
Two separate earth bars shall be considered, one for Compressor Skid and one for Vessel Skid, and the earth lugs of all equipment shall be connected to them. This requirement shall also be reflected in Document Number 'VD-GPIC-MA-3029-3029-0047'.

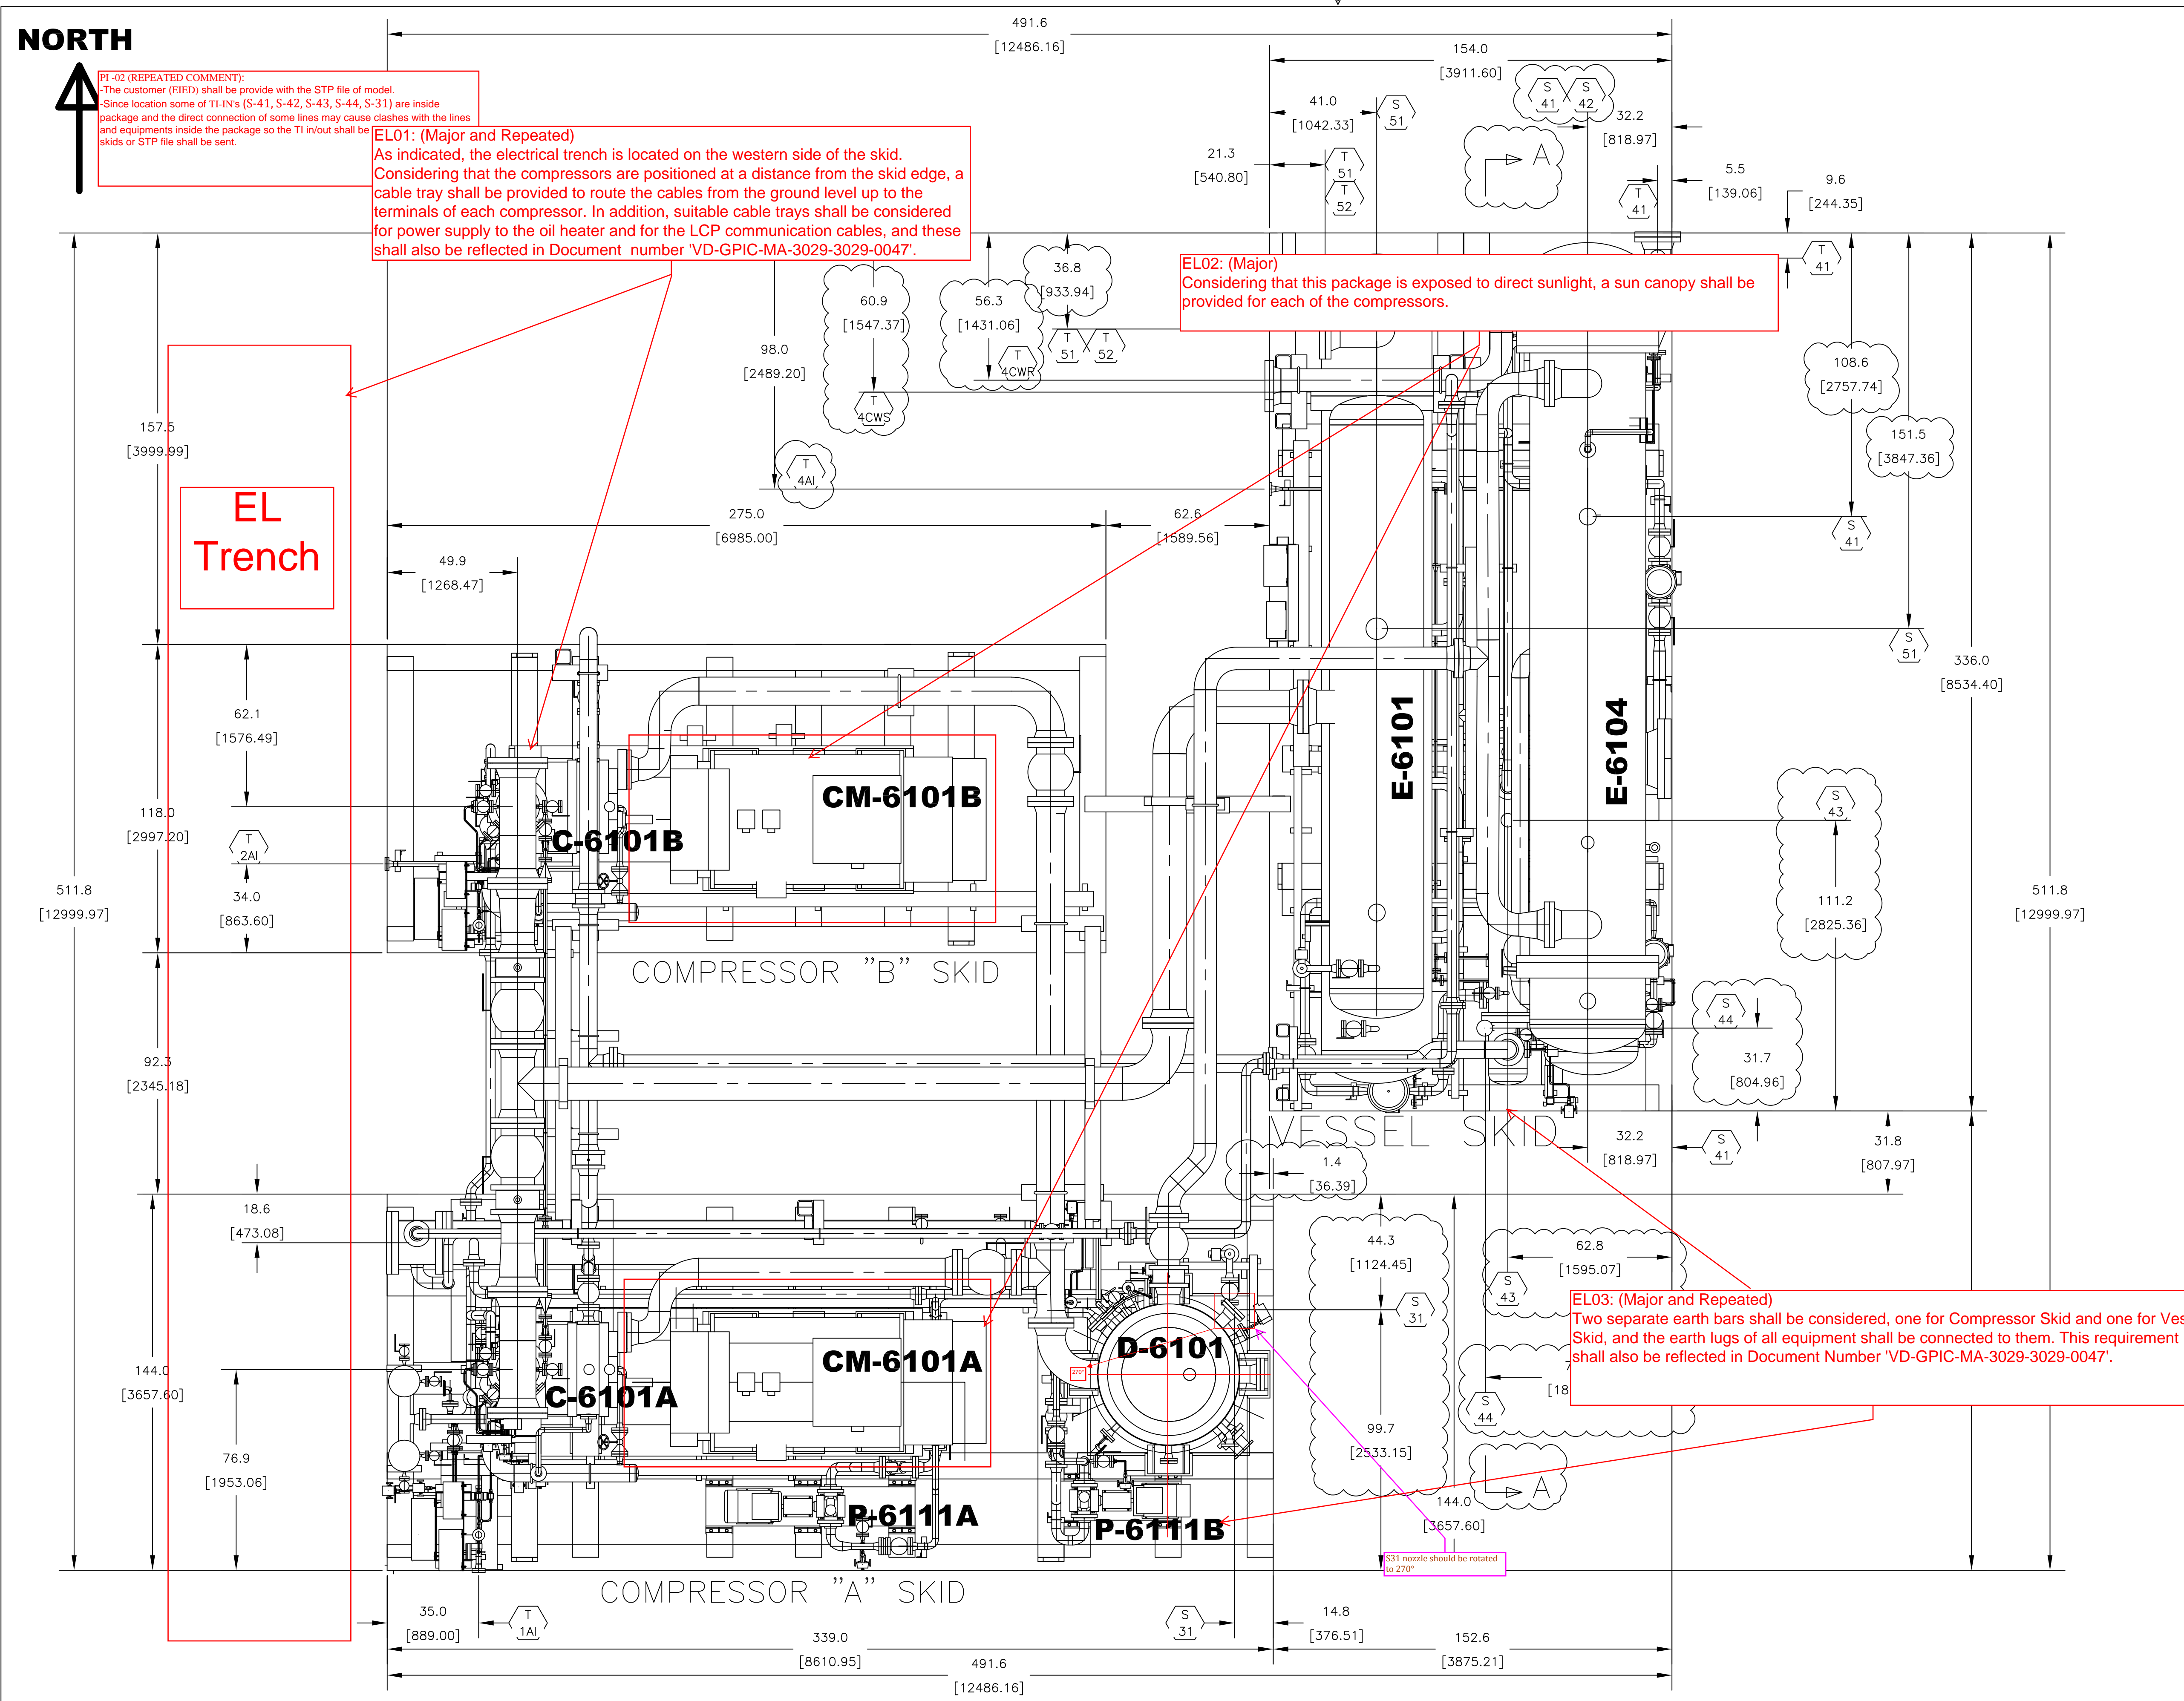

NOTES:

- FOR OPERATING AND DRY WEIGHTS, REFER TO VD-GPIC-MA-3029-3029-0071
- FOR CENTER OF GRAVITY, REFER TO VD-GPIC-MA-3029-3029-0071
- FOR DYNAMIC AND STATIC LOADS, REFER TO VD-GPIC-MA-3029-3029-0071
- FOR FOUNDATION DETAIL DRAWING, REFER TO VD-GPIC-MA-3029-3029-0071
- FOR LIFTING DETAILS, REFER TO VD-GPIC-MA-3029-3029-0062
- FOR SKID INSTALLATION, REFER TO INSTRUCTION AND OPERATIONAL MANUAL VD-GPIC-MA-3029-3029-0008
- DIMENSIONS ARE IN INCHES AND MM IN PARENTHESIS.
- ANCHOR HOLES TOLERANCES ± 0.13 in (± 3.2 mm).
- BEAM LOCATION TOLERANCES: ± 0.13 in (± 3.2 mm).
- NON-SKID GRATING UNDER MAINTENANCE AREA IS NOT INCLUDED.
- SKID FLATNESS SHALL BE 0.0625" (1.6 mm).
- SURFACE PREPARATION SHALL BE PER PROJECT PAINTING SPECIFICATION.
- ANCHOR BOLT HOLES SHALL BE WITHIN THE SAME XY AND XZ PLANES WITHIN ± 0.13 in (± 3.2 mm).
- COMPRESSOR SKIDS SHALL BE GROUTED. GROUT SPECIFICATION AND SELECTION BY OTHER AND SHALL BE SUITABLE TO PAINTING APPLICATION.
- FOR PIPE NOZZLE LOADS REFER TO DOCUMENT NUMBER VD-GPIC-MA-3029-3029-0062-G

Code1	<input type="checkbox"/> No Comment/ Approved (Applicable Only for "FOR REVIEW" and "For Approval" Documents) No comment and the document are released for Manufacturing
Code2	<input type="checkbox"/> No Comment / Approved with Note(s) Vendor/Sub-Contractor shall correct, revise and resubmit the document. The document is released for Manufacturing if changes incorporated.
Code3	<input type="checkbox"/> Commented Vendor/Sub-Contractor shall correct, revise and resubmit the document by the date specified. The document shall be revised under the Status of "Revised Issue". All corrected documents shall be resubmitted before starting the Manufacturing Process
Code4	<input type="checkbox"/> Not Accepted (Rejected) Vendor/Sub-Contractor shall re-work/re-design/re-specify the contents of the document according to the comments/reasons for rejection. All corrected documents shall be resubmitted before starting the manufacturing. Vendor Sub-Contractor shall not proceed with subsequent work of Material Supply or Manufacturing until receiving Code1/Code2 or No Code from PURCHASER. Vendor/Sub-Contractor shall resubmit the document with the same revision within 6 working days after receiving comments
No Code	<input type="checkbox"/> No Code (Only for "For Information" Documents and "As Built DWGs") Document has been submitted for PURCHASER'S information (I). Consistency, completeness and correctness of document content is in Vendor/Sub-Contractor's responsibility.

The above checking result by EIED shall in no way relieve Vendor of any liability, obligation and responsibility out of the purchase order and the mutual agreement in writing

EIED

DATE: _____
DEPT: _____
Signature: _____

CV	PI	EL	IN	ME	MA
ST	BU	FR	SA	HV	TL

REV.	DATE (DD.MM.YY)	Purpose of Issue	Prepared	Checked	Approved
01	20.12.25	IFR	FA	IM	OG
02	28.06.25	IFR	FA	IM	OG
00	16.09.25	IFR	FA	IM	OG
00	28.06.25	IFR	FA	IM	OG

PO No.: GPIC-PT-MA-PO-000-3029

DRAWING TITLE: **GENERAL ARRANGEMENT DRAWING**

DRAWING NO. VD-GPIC-MA-3029-3029-0062

REV. 04


SHEET NO. 3 of 12

SIZE A1


SCALE: 3/8":1'

Gachsan Polymer Industries Company
HDPE Plant

EIED

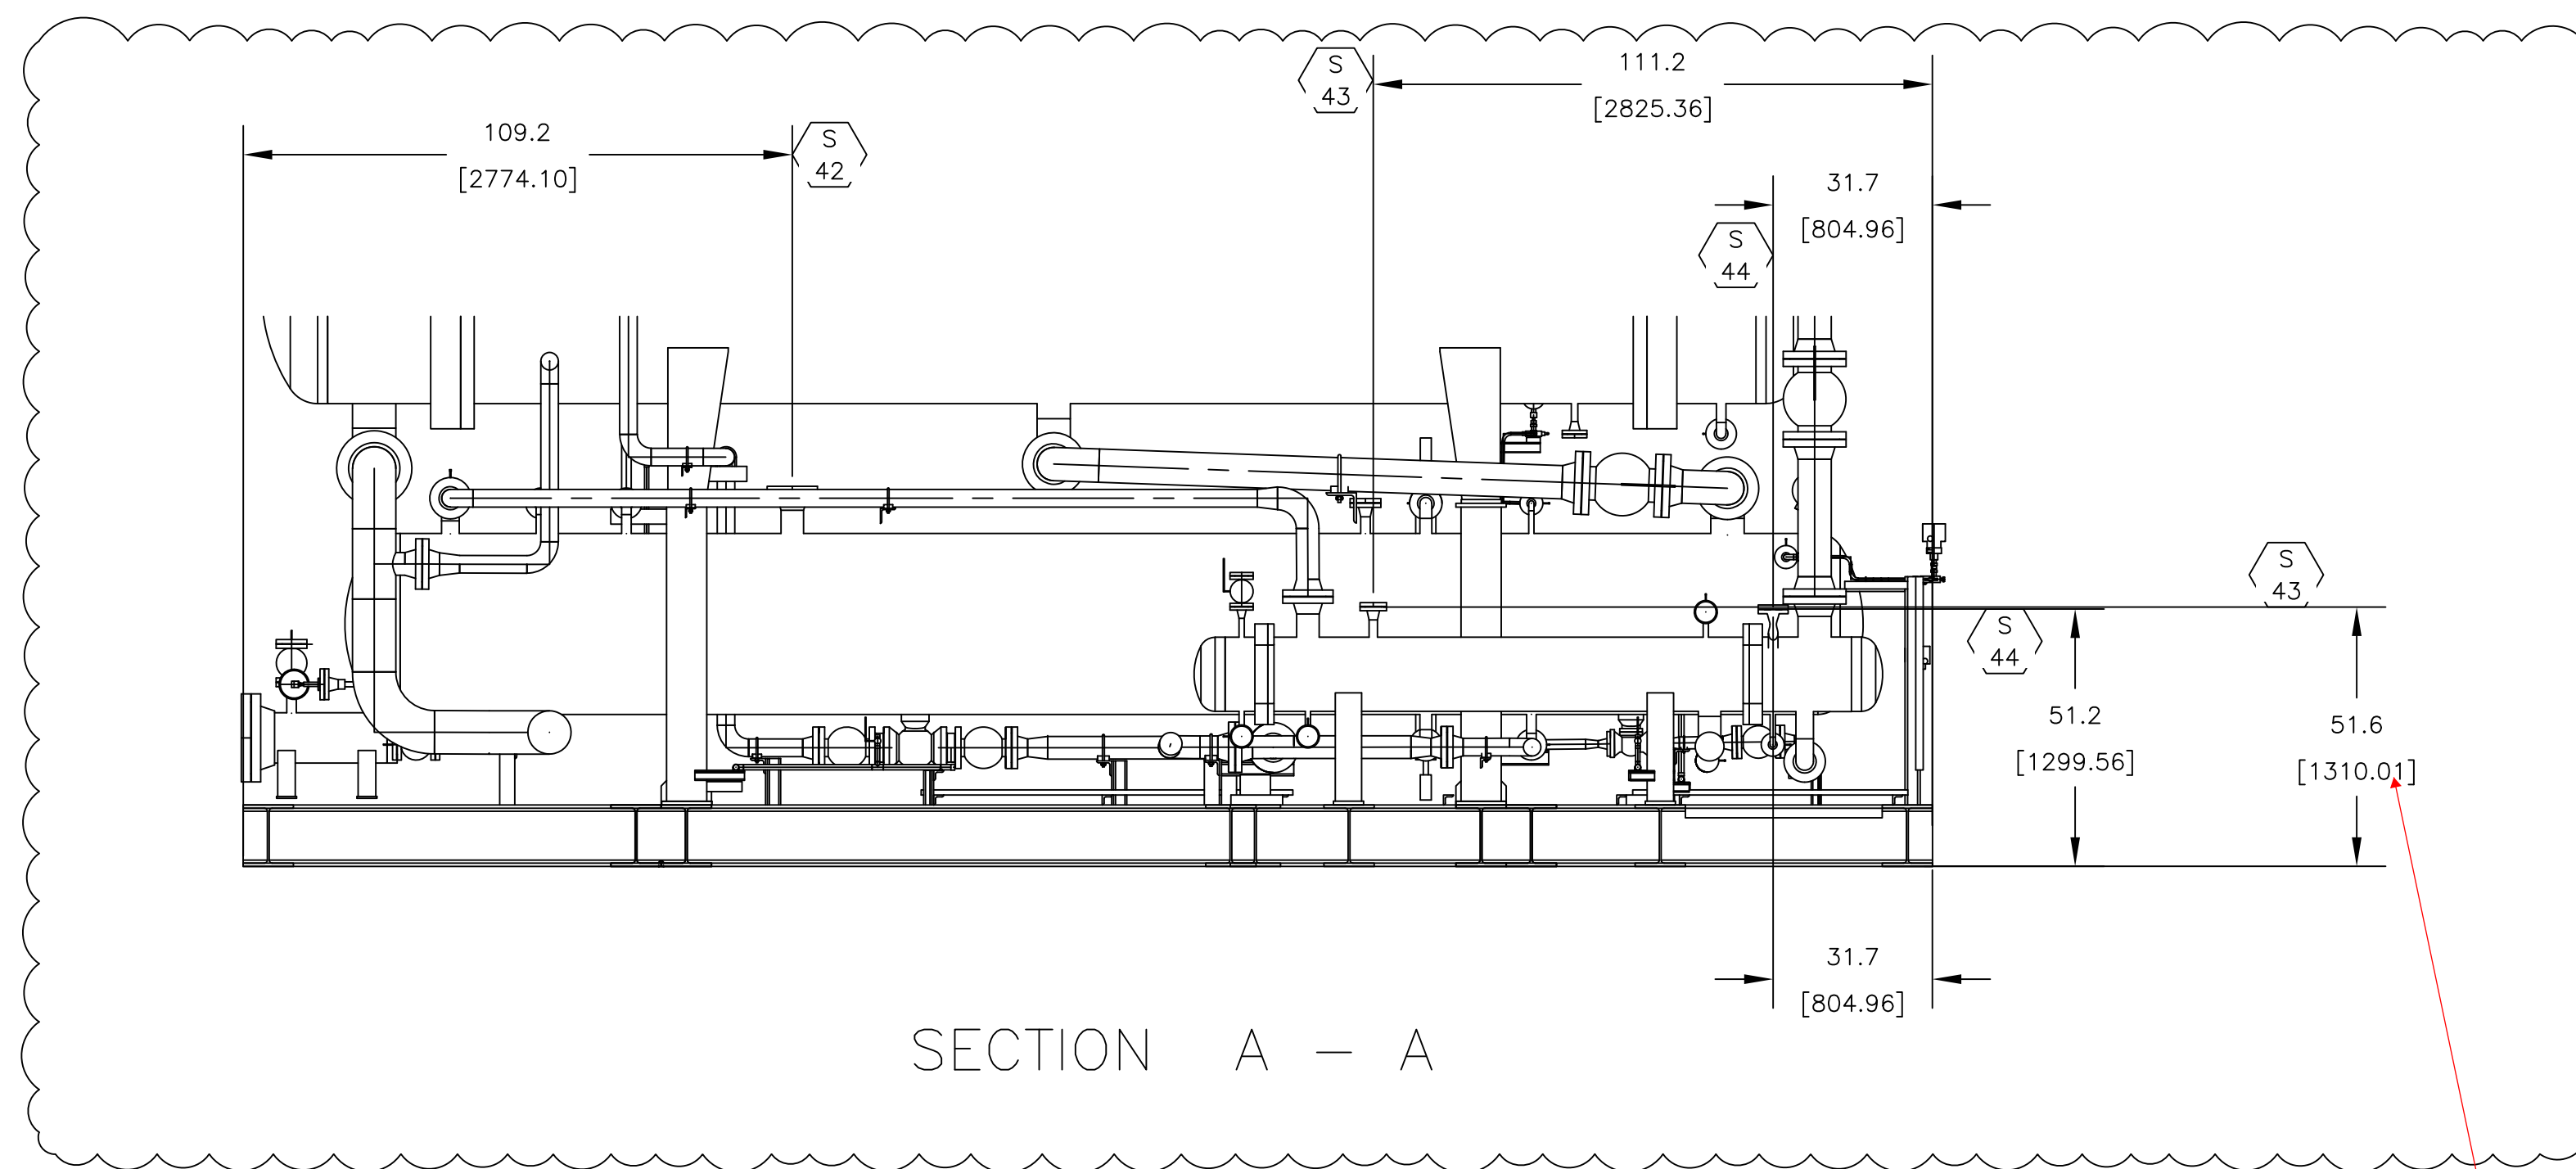

SECTION A - A

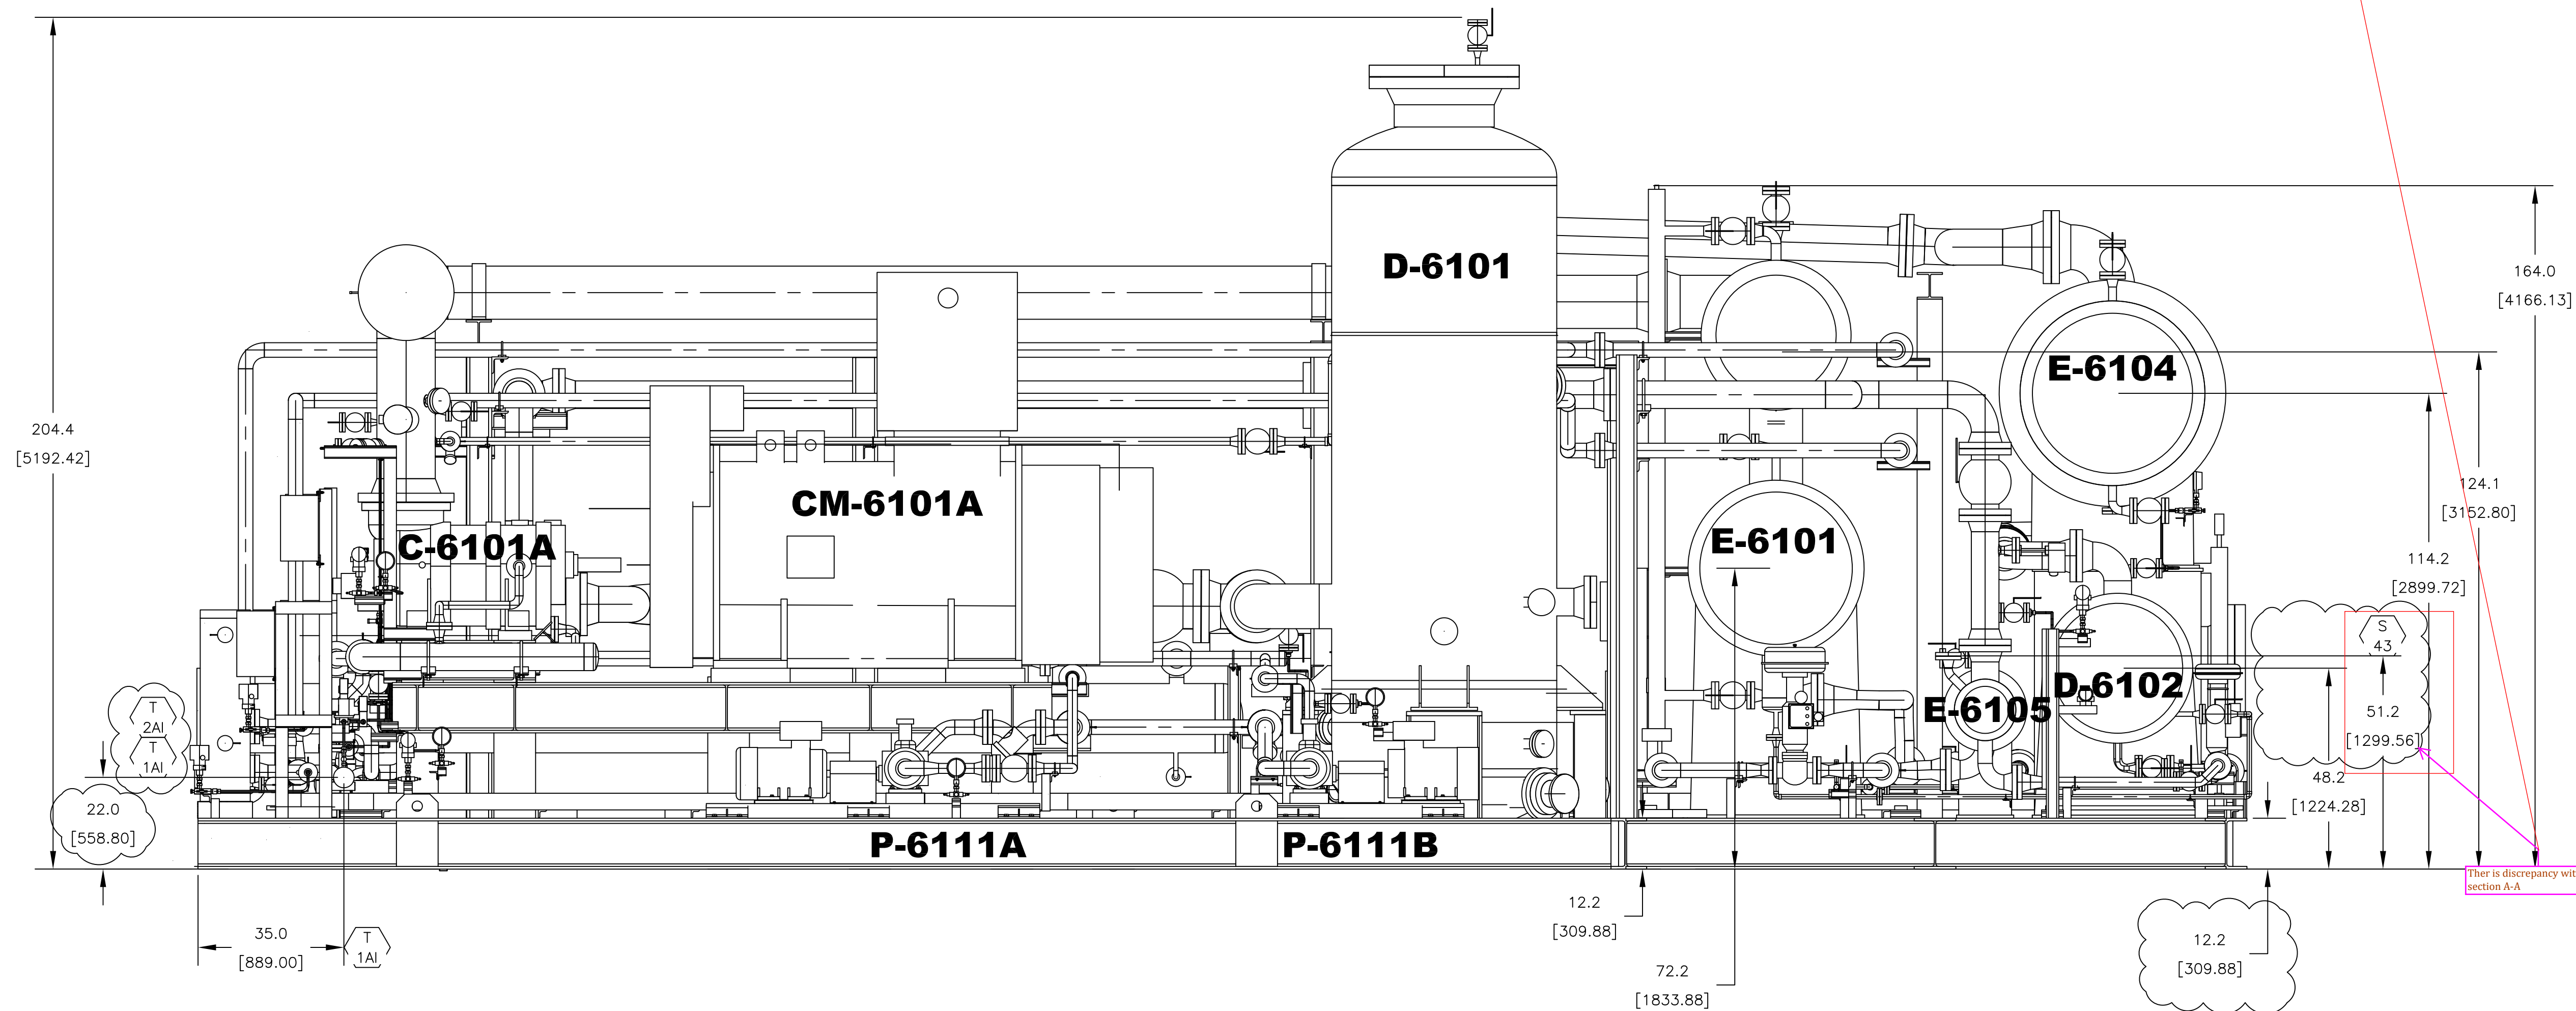

FRONT VIEW

Code1	<input type="checkbox"/> No Comment/ Approved (Applicable Only for "FOR REVIEW" and "For Approval" Documents) No comment and the document are released for Manufacturing
Code2	<input type="checkbox"/> No Comment / Approved with Note(s) Vendor/Sub-Contractor shall correct, revise and resubmit the document. The document is released for Manufacturing if changes incorporated.
Code3	<input type="checkbox"/> Commented Vendor/Sub-Contractor shall correct, revise and resubmit the document by the date specified. The document shall be reissued under the Status of "R: Revised Issue". All corrected documents shall be resubmitted before starting the Manufacturing Process
Code4	<input type="checkbox"/> Not Accepted (Rejected) Vendor/Sub-Contractor shall re-work/re-design/re-specify the contents of the document according to the comments/reasons for rejection. All corrected documents shall be resubmitted before starting the manufacturing. Vendor/Sub-Contractor shall not proceed with subsequent works of Material Supply or Manufacturing until receiving Code1/Code2 or No Code from PURCHASER. Vendor/Sub-Contractor shall resubmit the document with the same revision within 6 working days after receiving comments
No Code	<input type="checkbox"/> No Code (Only for "For Information" Documents and "As Built DWG") Document has been submitted for PURCHASER'S information (I). Consistency, completeness and correctness of document content is in Vendor/Sub-Contractor's responsibility.

The above checking result by EIED shall in no way relieve Vendor of any liability, obligation and responsibility out of the purchase order and the mutual agreement in writing

DATE :
DEPT :
Signature :

CV	PI	EL	IN	ME	MA
ST	BU	PR	SA	HV	TL


There is discrepancy with section A-A

04	20.12.25	IFR	FA	IM	OG
03	28.06.25	IFR	FA	IM	OG
02	28.06.25	IFR	FA	IM	OG
01	16.09.25	IFR	FA	IM	OG
00	28.06.25	IFR	FA	IM	OG
DATE (DD.MM.YY)	Purpose of Issue	Prepared	Checked	Approved	

 Gacharan Polymer Industries Company	 EIED	Gacharan Polymer Industries Company HDPE Plant		 RHINE	
		PO No.: GPIC-PT-MA-PO-000-3029			SCALE: 1/2":1'
DRAWING TITLE: GENERAL ARRANGEMENT DRAWING					
DRAWING NO. VD-GPIC-MA-3029-3029-0062	REV. 04	SHEET NO. 4 of 12	SIZE A1		

CONNECTION LIST			
NO.	LOCATION	DESCRIPTION	SIZE
T-1AI	COMPRESSOR SKID-A	INSTRUMENT AIR SUPPLY	1"-300 ANSI RF
T-2AI	COMPRESSOR SKID-B	INSTRUMENT AIR SUPPLY	1"-300 ANSI RF
T-4AI	VESSEL SKID	INSTRUMENT AIR SUPPLY	1"-300 ANSI RF
T-4CWS	VESSEL SKID	OIL COOLER COOLING WATER SUPPLY	8"-300 ANSI RF
T-4CWR	VESSEL SKID	OIL COOLER COOLING WATER RETURN	8"-300 ANSI RF
T-41	VESSEL SKID	FILTER/DRYER INLET	1-1/2"-300 ANSI RF
T-51	VESSEL SKID	CHILLER PROCESS INLET	14"-300 ANSI RF
T-52	VESSEL SKID	CHILLER PROCESS OUTLET	14"-300 ANSI RF
S-31	COMPRESSOR SKID-A	OIL SEPARATOR PRESSURE SAFETY	4"-300 ANSI RF
S-41	VESSEL SKID	CONDENSER PRESSURE SAFETY	3"-300 ANSI RF
S-42	VESSEL SKID	RECEIVER PRESSURE SAFETY	4"-300 ANSI RF
S-43	VESSEL SKID	ECONOMIZER PRESSURE SAFETY-SHELL	1-1/2"-300 ANSI RF
S-44	VESSEL SKID	ECONOMIZER PRESSURE SAFETY-TUBE	1-1/2"-300 ANSI RF
S-51	VESSEL SKID	CHILLER PRESSURE SAFETY	3"-300 ANSI RF

EQUIPMENT TAG NUMBER	
TAG NO.	DESCRIPTION
C-6101A	COMPRESSOR
C-6101B	COMPRESSOR
CM-6101A	COMPRESSOR MOTOR
CM-6101B	COMPRESSOR MOTOR
E-6101	CHILLER
E-6102	OIL COOLER
E-6104	CONDENSER
E-6105	ECONOMIZER
D-6101	OIL SEPARATOR
D-6102	RECEIVER
P-6111A/A	OIL PUMPS
PM-6111A/A	OIL PUMP MOTORS
F-6102	FILTER/DRYER
F-6101A/B	OIL FILTER

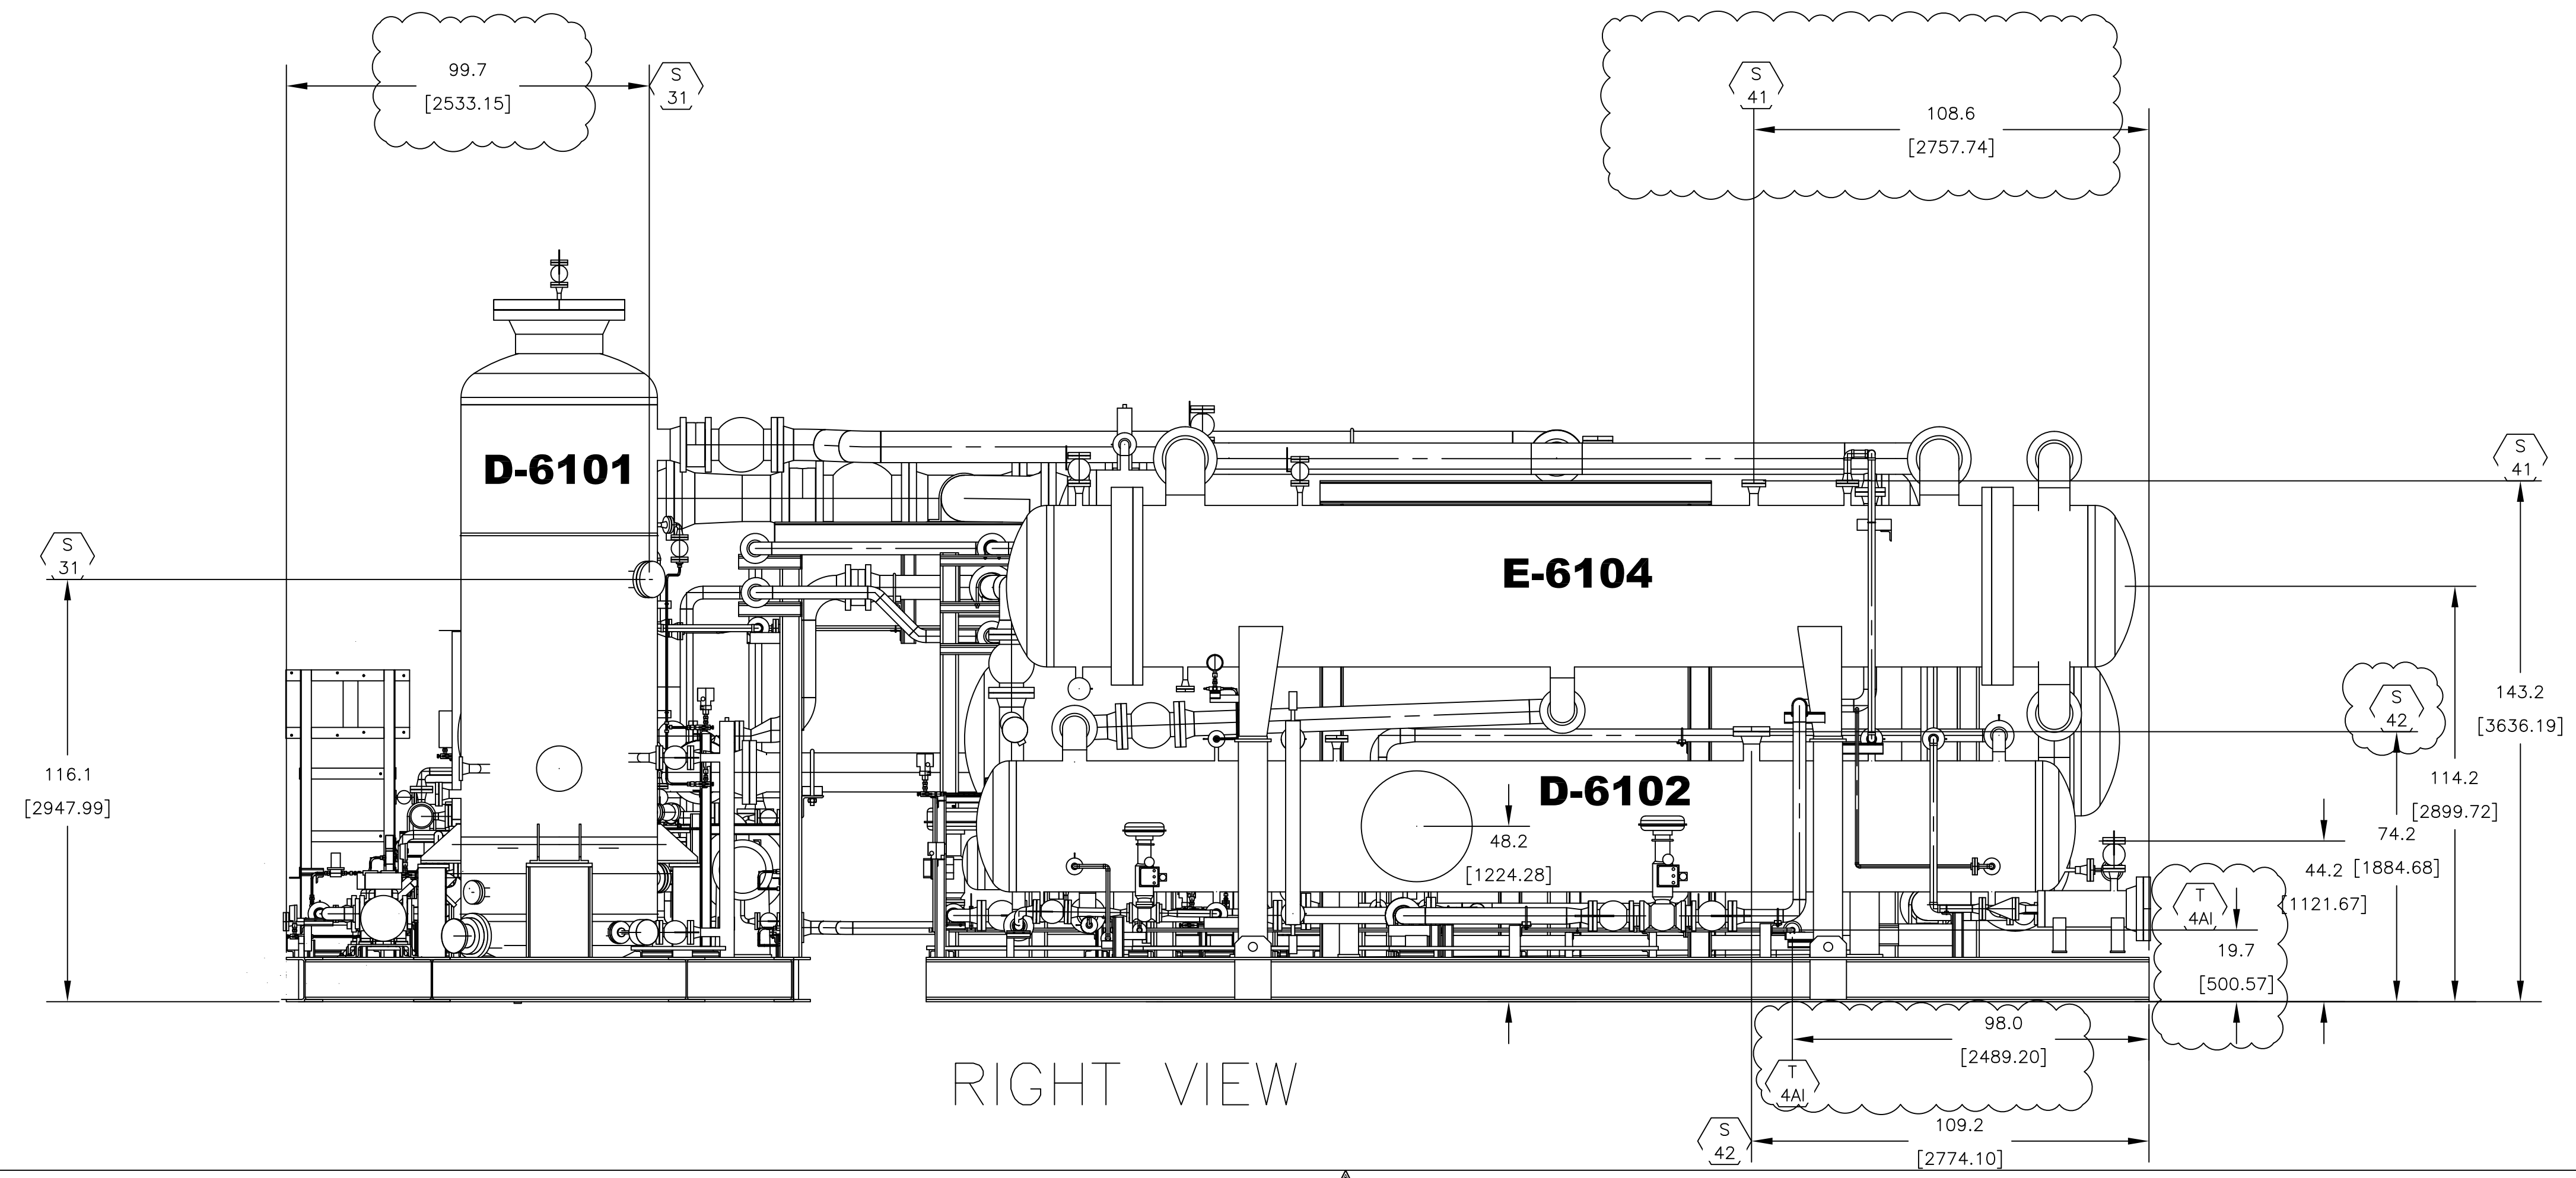

Code1	<input type="checkbox"/> No Comment/ Approved (Applicable Only for "FOR REVIEW" and "For Approval" Documents) No comment and the document are released for Manufacturing
Code2	<input type="checkbox"/> No Comment / Approved with Note(s) Vendor/Sub-Contractor shall correct, revise and resubmit the document. The document is released for Manufacturing if changes incorporated.
Code3	<input type="checkbox"/> Commented Vendor/Sub-Contractor shall correct, revise and resubmit the document by the date specified. The document shall be revised under the Status of "R: Revised Issue". All corrected documents shall be resubmitted before starting the Manufacturing Process
Code4	<input type="checkbox"/> Not Accepted (Rejected) Vendor/Sub-Contractor shall re-work/re-design/re-specify the contents of the document according to the comments/reasons for rejection. All corrected documents shall be resubmitted before starting the manufacturing. Vendor/Sub-Contractor shall not proceed with subsequent work of Material Supply or Manufacturing until receiving Code1/Code2 or No Code from PURCHASER. Vendor/Sub-Contractor shall resubmit the document with the same revision within 6 working days after receiving comments
No Code	<input type="checkbox"/> No Code (Only for "For Information" Documents and "As Built DWGs") Document has been submitted for PURCHASER'S information (If). Consistency, completeness and correctness of document content is in Vendor/Sub-Contractor's responsibility. The above checking result by EIED shall in no way relieve Vendor of any liability, obligation and responsibility out of the purchase order and the mutual agreement in writing

DATE :
DEPT :
Signature :

CV	PI	EL	IN	ME	MA
ST	BU	PR	SA	HV	TL

04	20.12.25	IFR	FA	IM	OG
03	28.06.25	IFR	FA	IM	OG
02	28.06.25	IFR	FA	IM	OG
01	16.09.25	IFR	FA	IM	OG
00	28.06.25	IFR	FA	IM	OG
REV.	DATE	Purpose of Issue	Prepared	Checked	Approved


PO No.: GPIC-PT-MA-PO-000-3029

DRAWING TITLE: **GENERAL ARRANGEMENT DRAWING**

DRAWING NO. VD-GPIC-MA-3029-3029-0062

REV. 04 SHEET NO. 5 of 12 SIZE A1

Scale: 1/2":1'

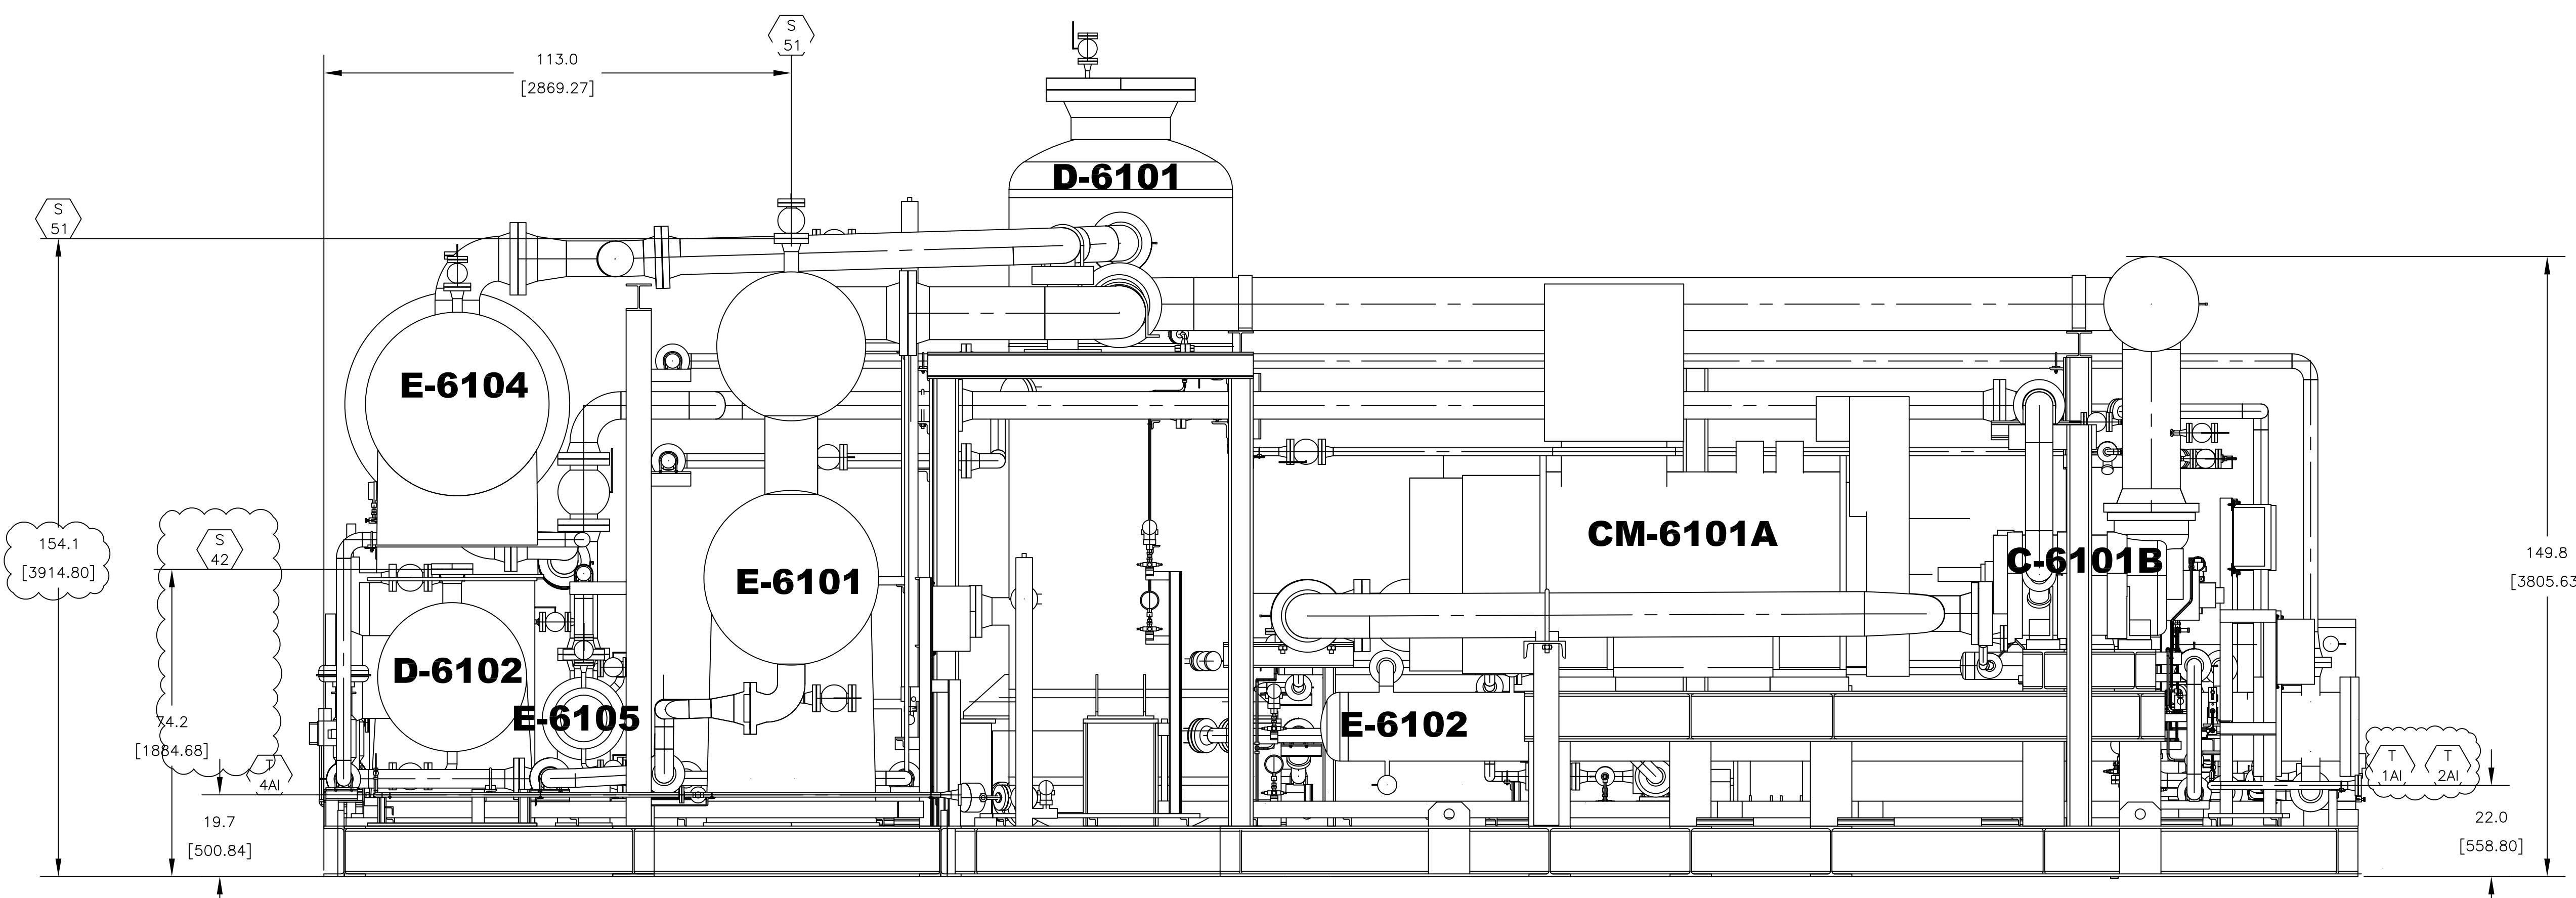

BACK VIEW

Code1 No Comment/ Approved
(Applicable Only for "FOR REVIEW" and "For Approval" Documents) No comment and the document are released for Manufacturing

Code2 No Comment / Approved with Note(s)
Vendor/Sub-Contractor shall correct, revise and resubmit the document. The document is released for Manufacturing if changes incorporated.

Code3 Commented
Vendor/Sub-Contractor shall correct, revise and resubmit the document by the date specified. The document shall be revised under the Status of "R: Revised Issue". All corrected documents shall be resubmitted before starting the Manufacturing Process

Code4 Not Accepted (Rejected)
Vendor/Sub-Contractor shall re-work/re-design/re-specify the contents of the document according to the comments/reasons for rejection. All corrected documents shall be resubmitted before starting the manufacturing. Vendor/Sub-Contractor shall not proceed with subsequent works of Material Supply or Manufacturing until receiving Code1/Code2 or No Code from PURCHASER. Vendor/Sub-Contractor shall resubmit the document with the same revision within 6 working days after receiving comments

No Code No Code
(Only for "For Information" Documents and "As Built DWGs") Document has been submitted for PURCHASER'S information (I). Consistency, completeness and correctness of document content is in Vendor/Sub-Contractor's responsibility.

The above checking result by EIED shall in no way relieve Vendor of any liability, obligation and responsibility out of the purchase order and the mutual agreement in writing

EIED

DATE :
DEPT :
Signature :

CV	PI	EL	IN	ME	MA
ST	BU	FR	SA	HV	TL

04	20.12.25	IFR	FA	IM	OG
03	28.06.25	IFR	FA	IM	OG
02	28.06.25	IFR	FA	IM	OG
01	16.09.25	IFR	FA	IM	OG
00	28.06.25	IFR	FA	IM	OG
REV.	DATE (DD.MM.YY)	Purpose of Issue	Prepared	Checked	Approved

GPI Gachasan Polymer Industries Company

Gachasan Polymer Industries Company

Gachasan Plyomer Industries Company

HDPE Plant


EIED

RING

PO No.: GPIC-PT-MA-PO-000-3029 SCALE: 1/2":1'

DRAWING TITLE: **GENERAL ARRANGEMENT DRAWING**


DRAWING NO.	REV.	SHEET NO.	SIZE
VD-GPIC-MA-3029-3029-0062	04	6 of 12	A1

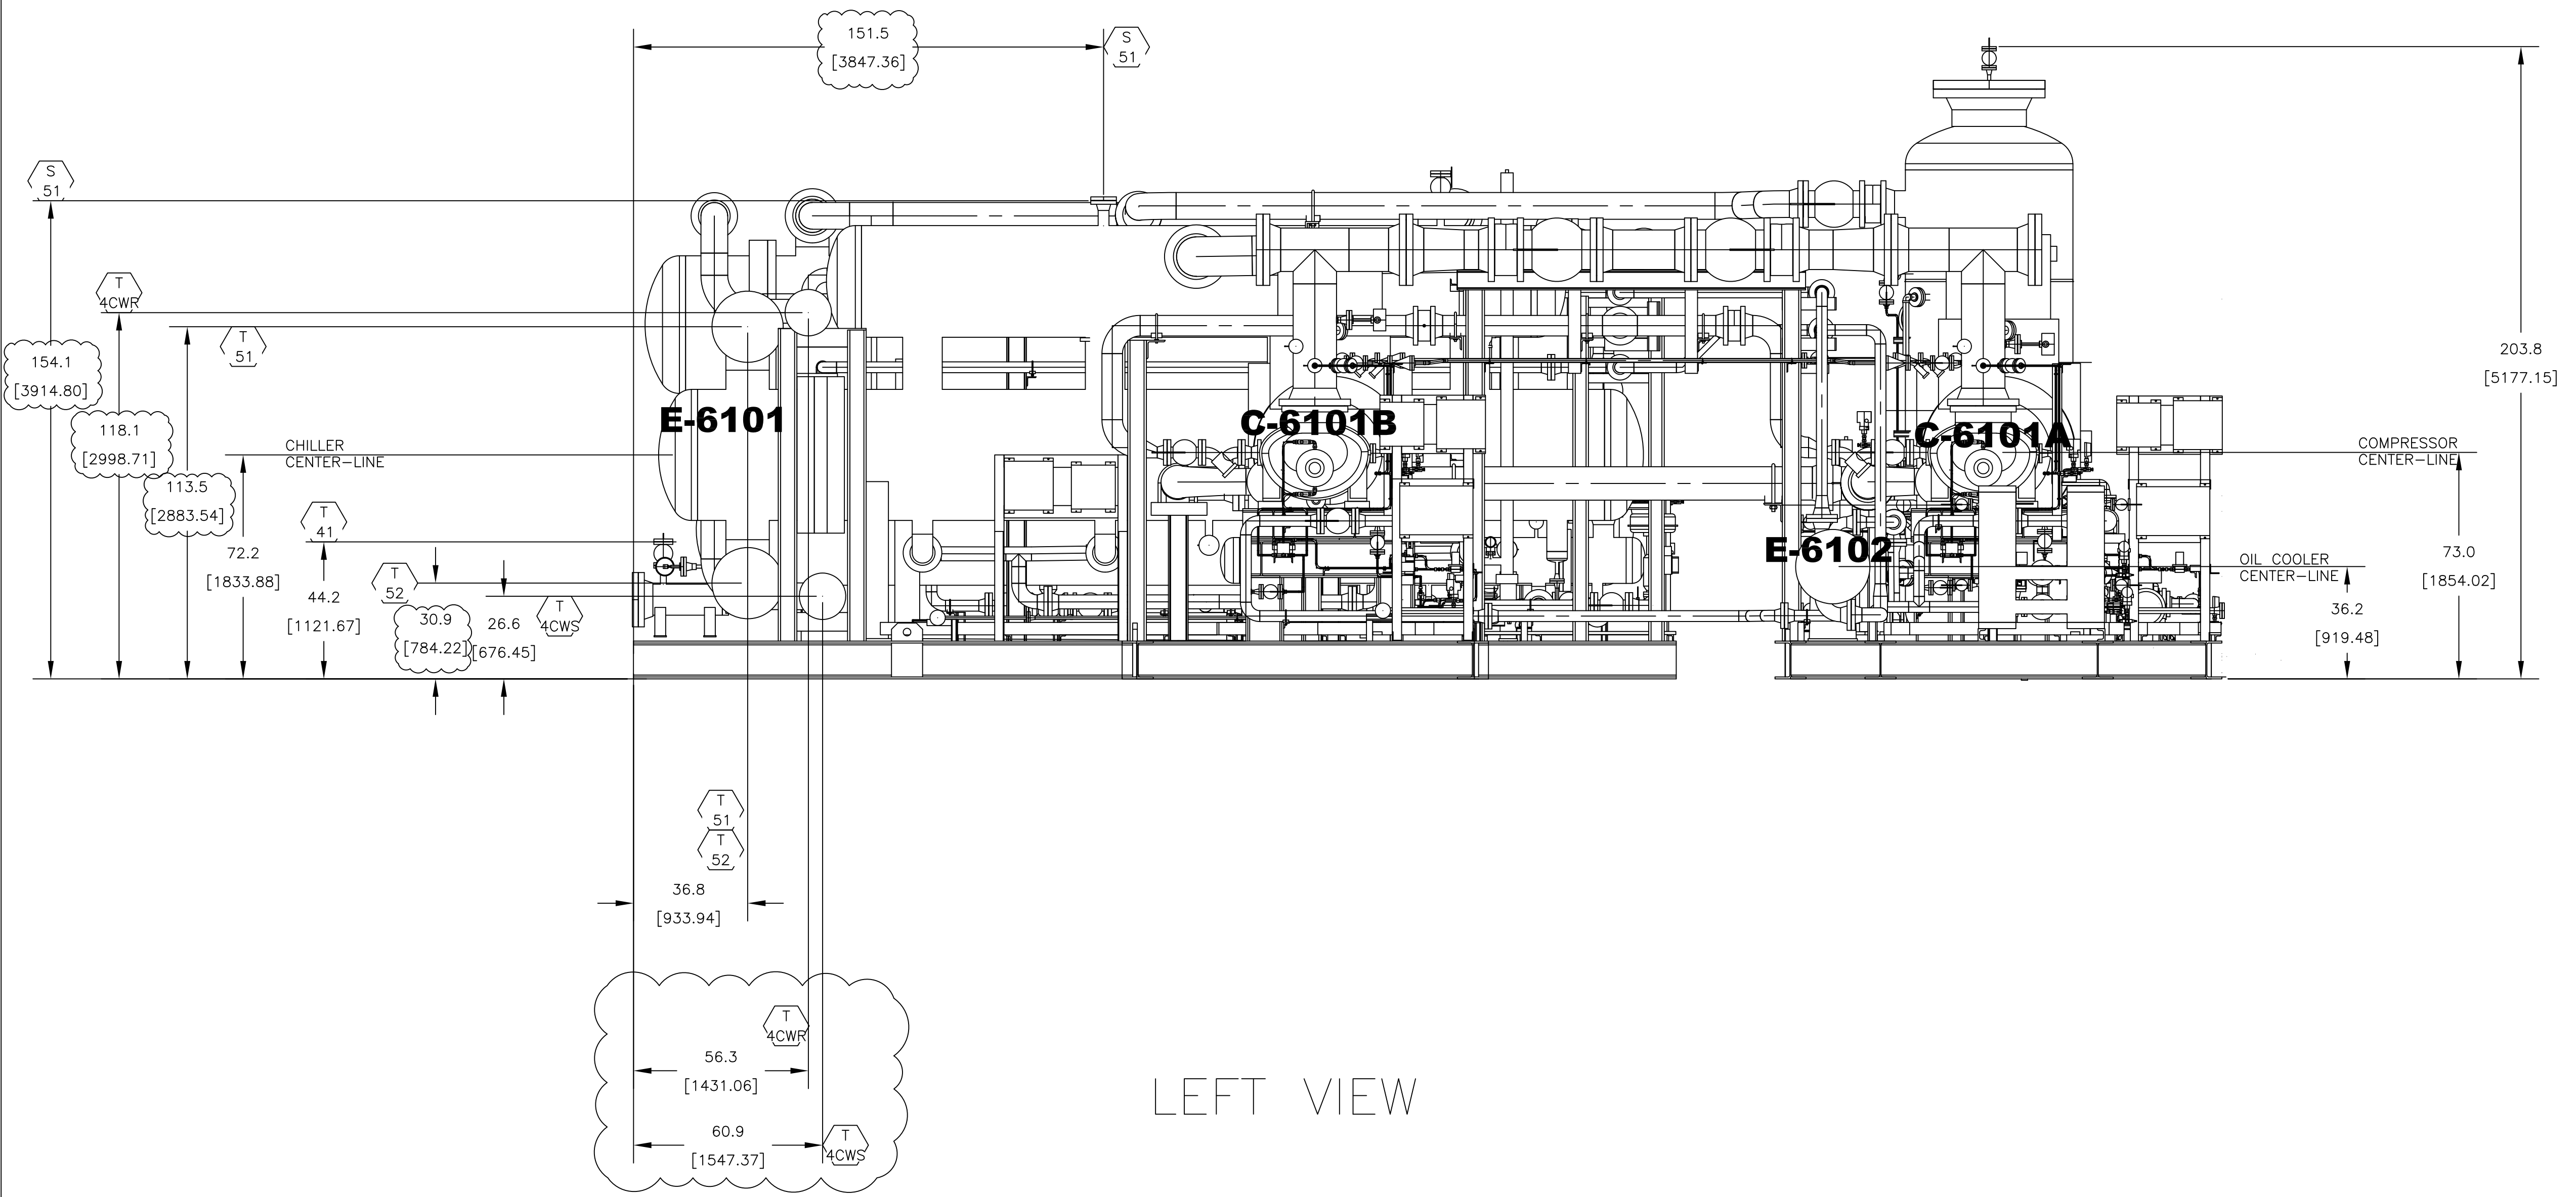

Code1	<input type="checkbox"/> No Comment/ Approved (Applicable Only for "FOR REVIEW" and "For Approval" Documents) No comment and the document are released for Manufacturing				
Code2	<input type="checkbox"/> No Comment / Approved with Note(s) Vendor/Sub-Contractor shall correct, revise and resubmit the document. The document is released for Manufacturing if changes incorporated.				
Code3	<input type="checkbox"/> Commented Vendor/Sub-Contractor shall correct, revise and resubmit the document by the date specified. The document shall be revised under the Status of "R: Revised Issue". All corrected documents shall be resubmitted before starting the Manufacturing Process				
Code4	<input type="checkbox"/> Not Accepted (Rejected) Vendor/Sub-Contractor shall re-work/re-design/re-specify the contents of the document according to the comments/reasons for rejection. All corrected documents shall be resubmitted before starting the manufacturing. Vendor/Sub-Contractor shall not proceed with subsequent work of Material Supply or Manufacturing until receiving Code1/Code2 or No Code from PURCHASER. Vendor/Sub-Contractor shall resubmit the document with the same revision within 6 working days after receiving comments				
No Code	<input type="checkbox"/> No Code (Only for "For Information" Documents and "As Built DWGs") Document has been submitted for PURCHASER'S information (I). Consistency, completeness and correctness of document content is in Vendor/Sub-Contractor's responsibility. The above checking result by EIED shall in no way relieve Vendor of any liability, obligation and responsibility out of the purchase order and the mutual agreement in writing				
DATE :					
DEPT:					
Signature :					
CV	PI	EL	IN	ME	MA
ST	BU	FR	SA	HV	TL

04	20.12.25	IFR	FA	IM	OG
03	28.06.25	IFR	FA	IM	OG
02	28.06.25	IFR	FA	IM	OG
01	16.09.25	IFR	FA	IM	OG
00	28.06.25	IFR	FA	IM	OG
REV.	DATE (dd.MMM.YY)	Purpose of Issue	Prepared	Checked	Approved

 Gachasan Polymer Industries Company	 Gachasan Polymer Industries Company	Gachasan Polymer Industries Company HDPE Plant	 EIED	 RHINE
DRAWING TITLE: GENERAL ARRANGEMENT DRAWING				
DRAWING NO. VD-GPIC-MA-3029-3029-0062	REV. 04	SHEET NO. 7 of 12	SIZE A1	

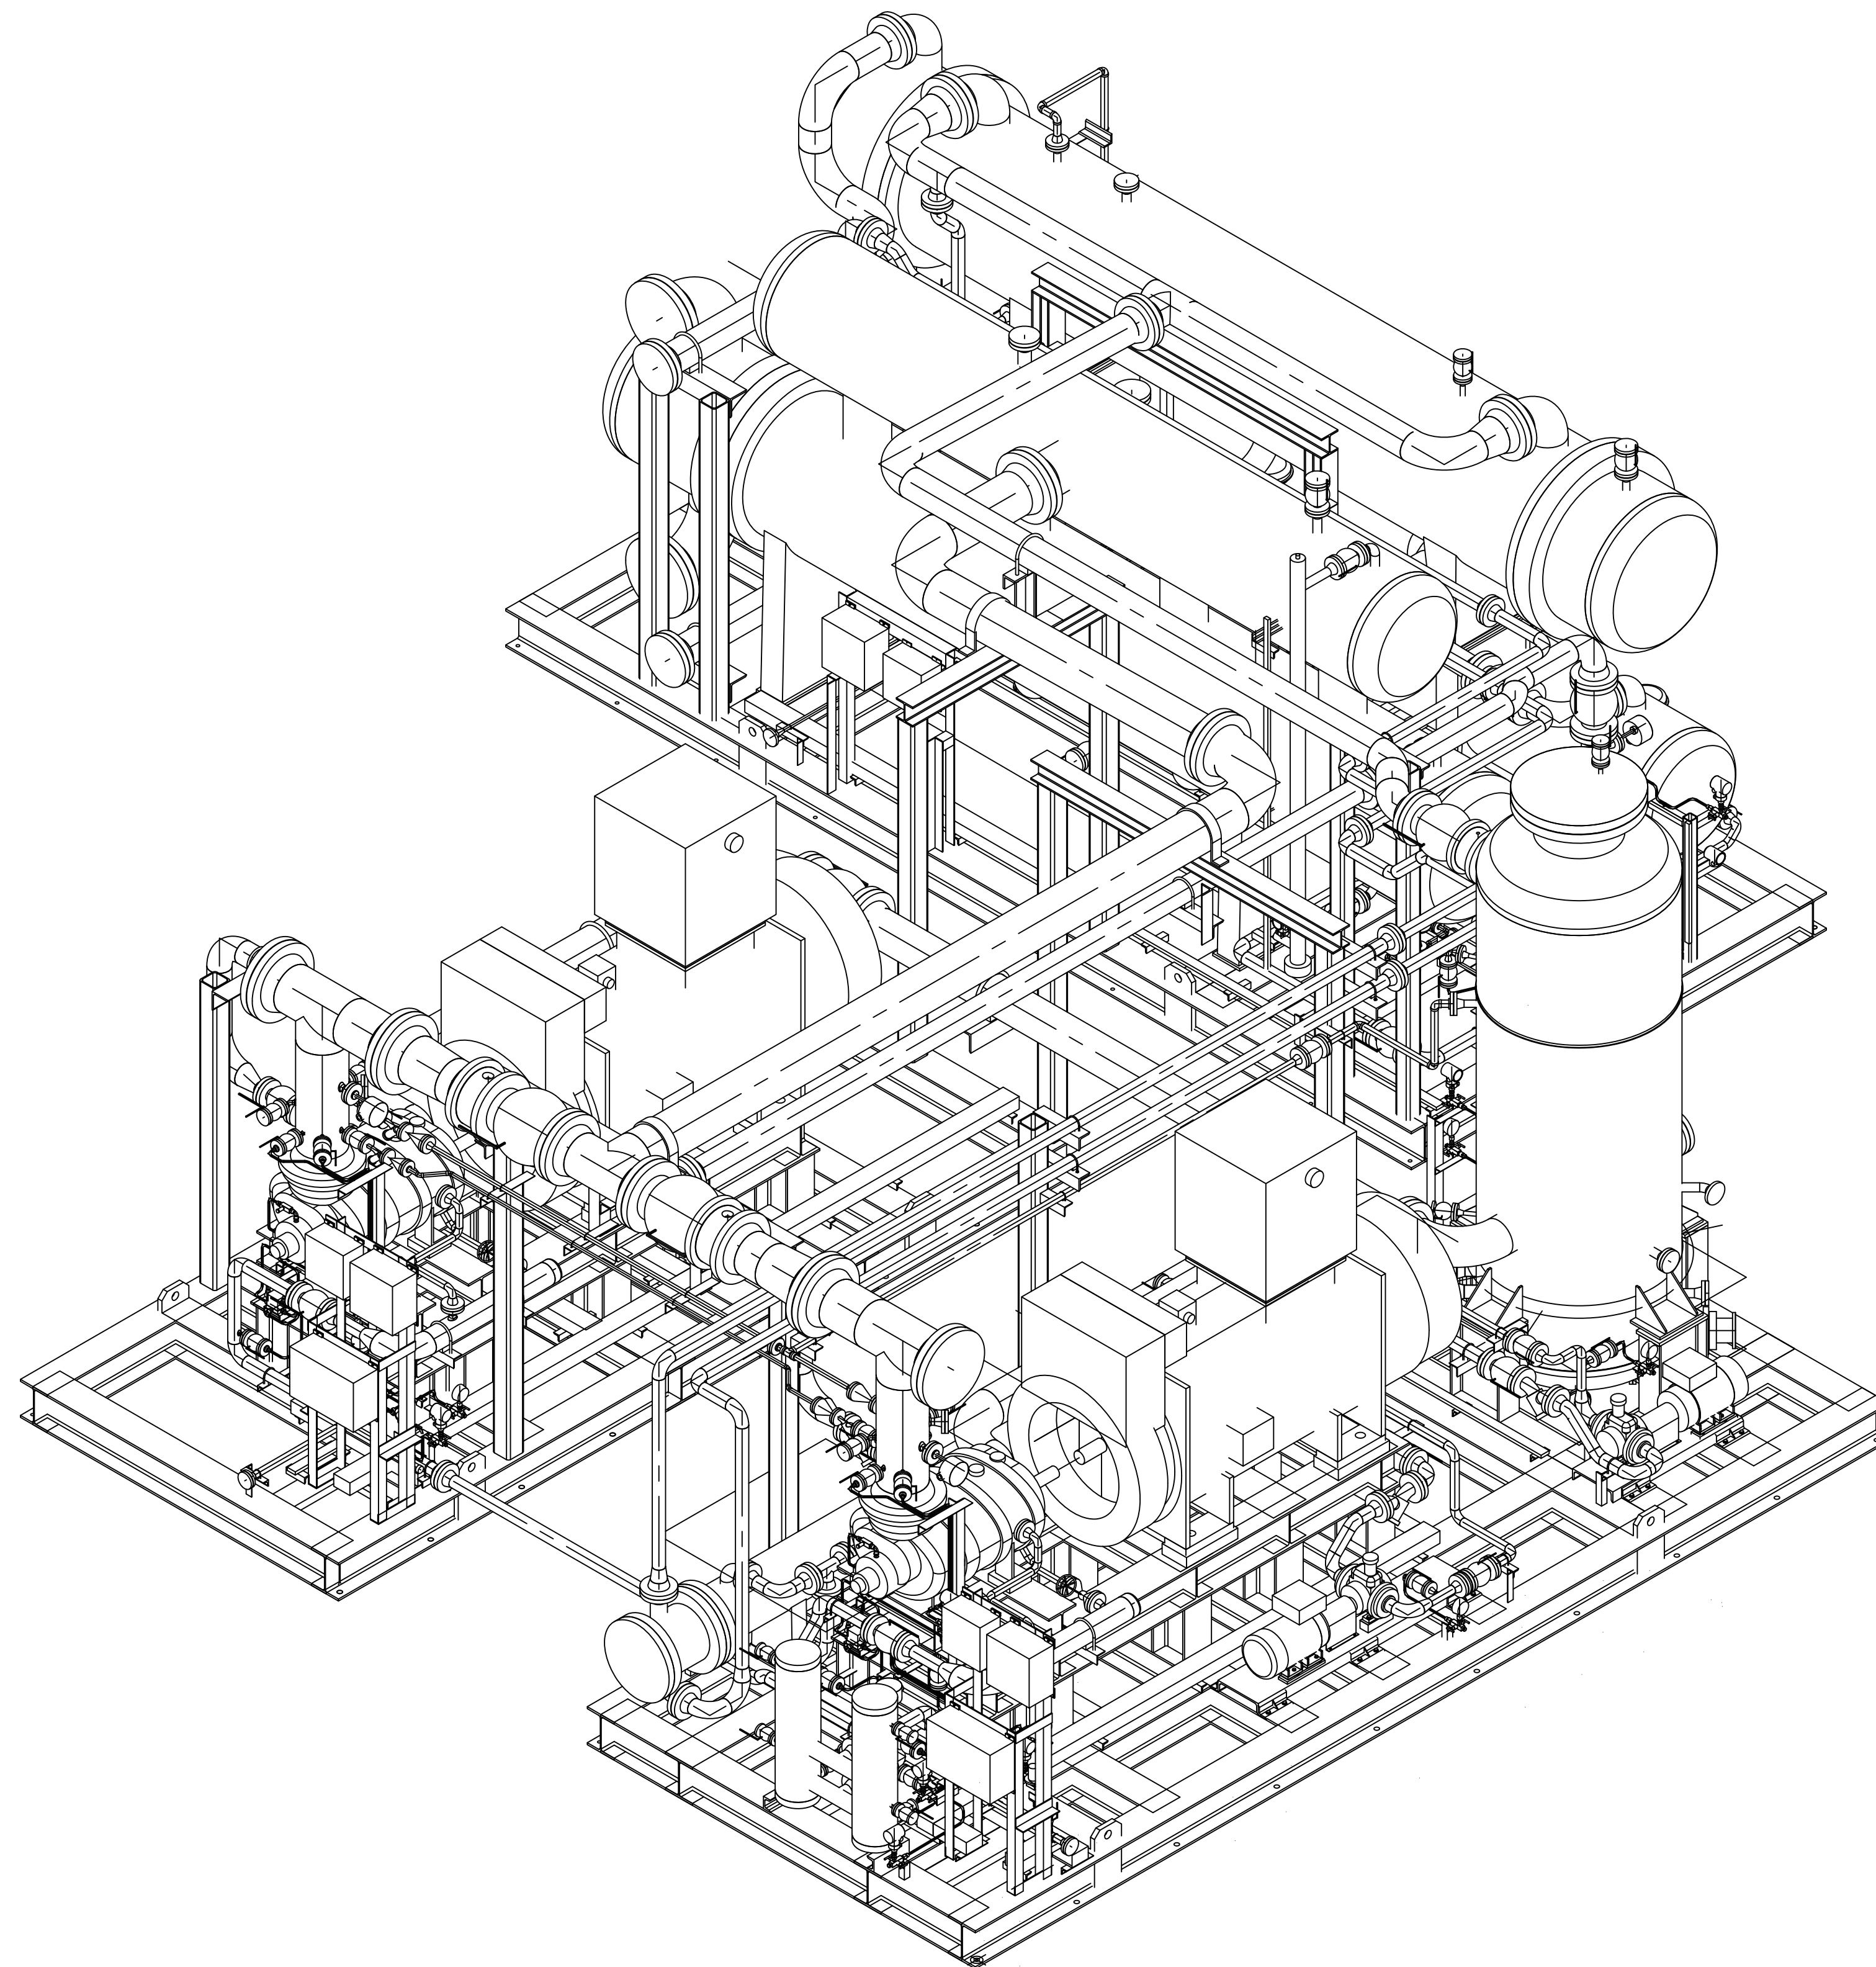

Code1 No Comment/ Approved
(Applicable Only for "FOR REVIEW" and "For Approval" Documents) No comment and the document are released for Manufacturing

Code2 No Comment / Approved with Note(s)
Vendor/Sub-Contractor shall correct, revise and resubmit the document. The document is released for Manufacturing if changes incorporated.

Code3 Commented
Vendor/Sub-Contractor shall correct, revise and resubmit the document by the date specified. The document shall be revised under the Status of "R: Revised Issue". All corrected documents shall be resubmitted before starting the Manufacturing Process

Code4 Not Accepted (Rejected)
Vendor/Sub-Contractor shall re-work/re-design/re-specify the contents of the document according to the comments/reasons for rejection. All corrected documents shall be resubmitted before starting the manufacturing Vendor Sub-Contractor shall not proceed with subsequent works of Material Supply or Manufacturing until receiving Code1/Code2 or No Code from PURCHASER. Vendor/Sub-Contractor shall resubmit the document with the same revision within 6 working days after receiving comments

No Code No Code
(Only for "For Information" Documents and "As Built DWG") Document has been submitted for PURCHASER'S Information (I). Consistency, completeness and correctness of document content is in Vendor/Sub-Contractor's responsibility.

The above checking result by EIED shall in no way relieve Vendor of any liability, obligation and responsibility out of the purchase order and the mutual agreement in writing

EIED

DATE :
DEPT :
Signature :

CV	PI	EL	IN	ME	MA
ST	BU	PR	SA	HV	TL

04	20.12.25	IFR	FA	IM	OG
03	28.06.25	IFR	FA	IM	OG
02	28.06.25	IFR	FA	IM	OG
01	16.09.25	IFR	FA	IM	OG
00	28.06.25	IFR	FA	IM	OG
REV.	DATE (DD.MMM.YY)	Purpose of Issue	Prepared	Checked	Approved


		Gacharan Polymer Industries Company HDPE Plant	
PO No.: GPIC-PT-MA-PO-000-3029			SCALE: 3/8":1'

DRAWING TITLE: **GENERAL ARRANGEMENT DRAWING**

DRAWING NO.	REV.	SHEET NO.	SIZE
VD-GPIC-MA-3029-3029-0062	04	8 of 12	A1

IN-02 Tag number of all JB and LCP shall be corrected based on final revision of IO list.


IN-01. In addition to GA, this document is cable route and for cable route, symbol for instrument cable tray/ladder/conduit/JB shall be specified clearly in symbol and legend and related cable route shall be shown in the drawing. Width/depth/size of trays/ladders/conduits shall be added and shown in this drawing.

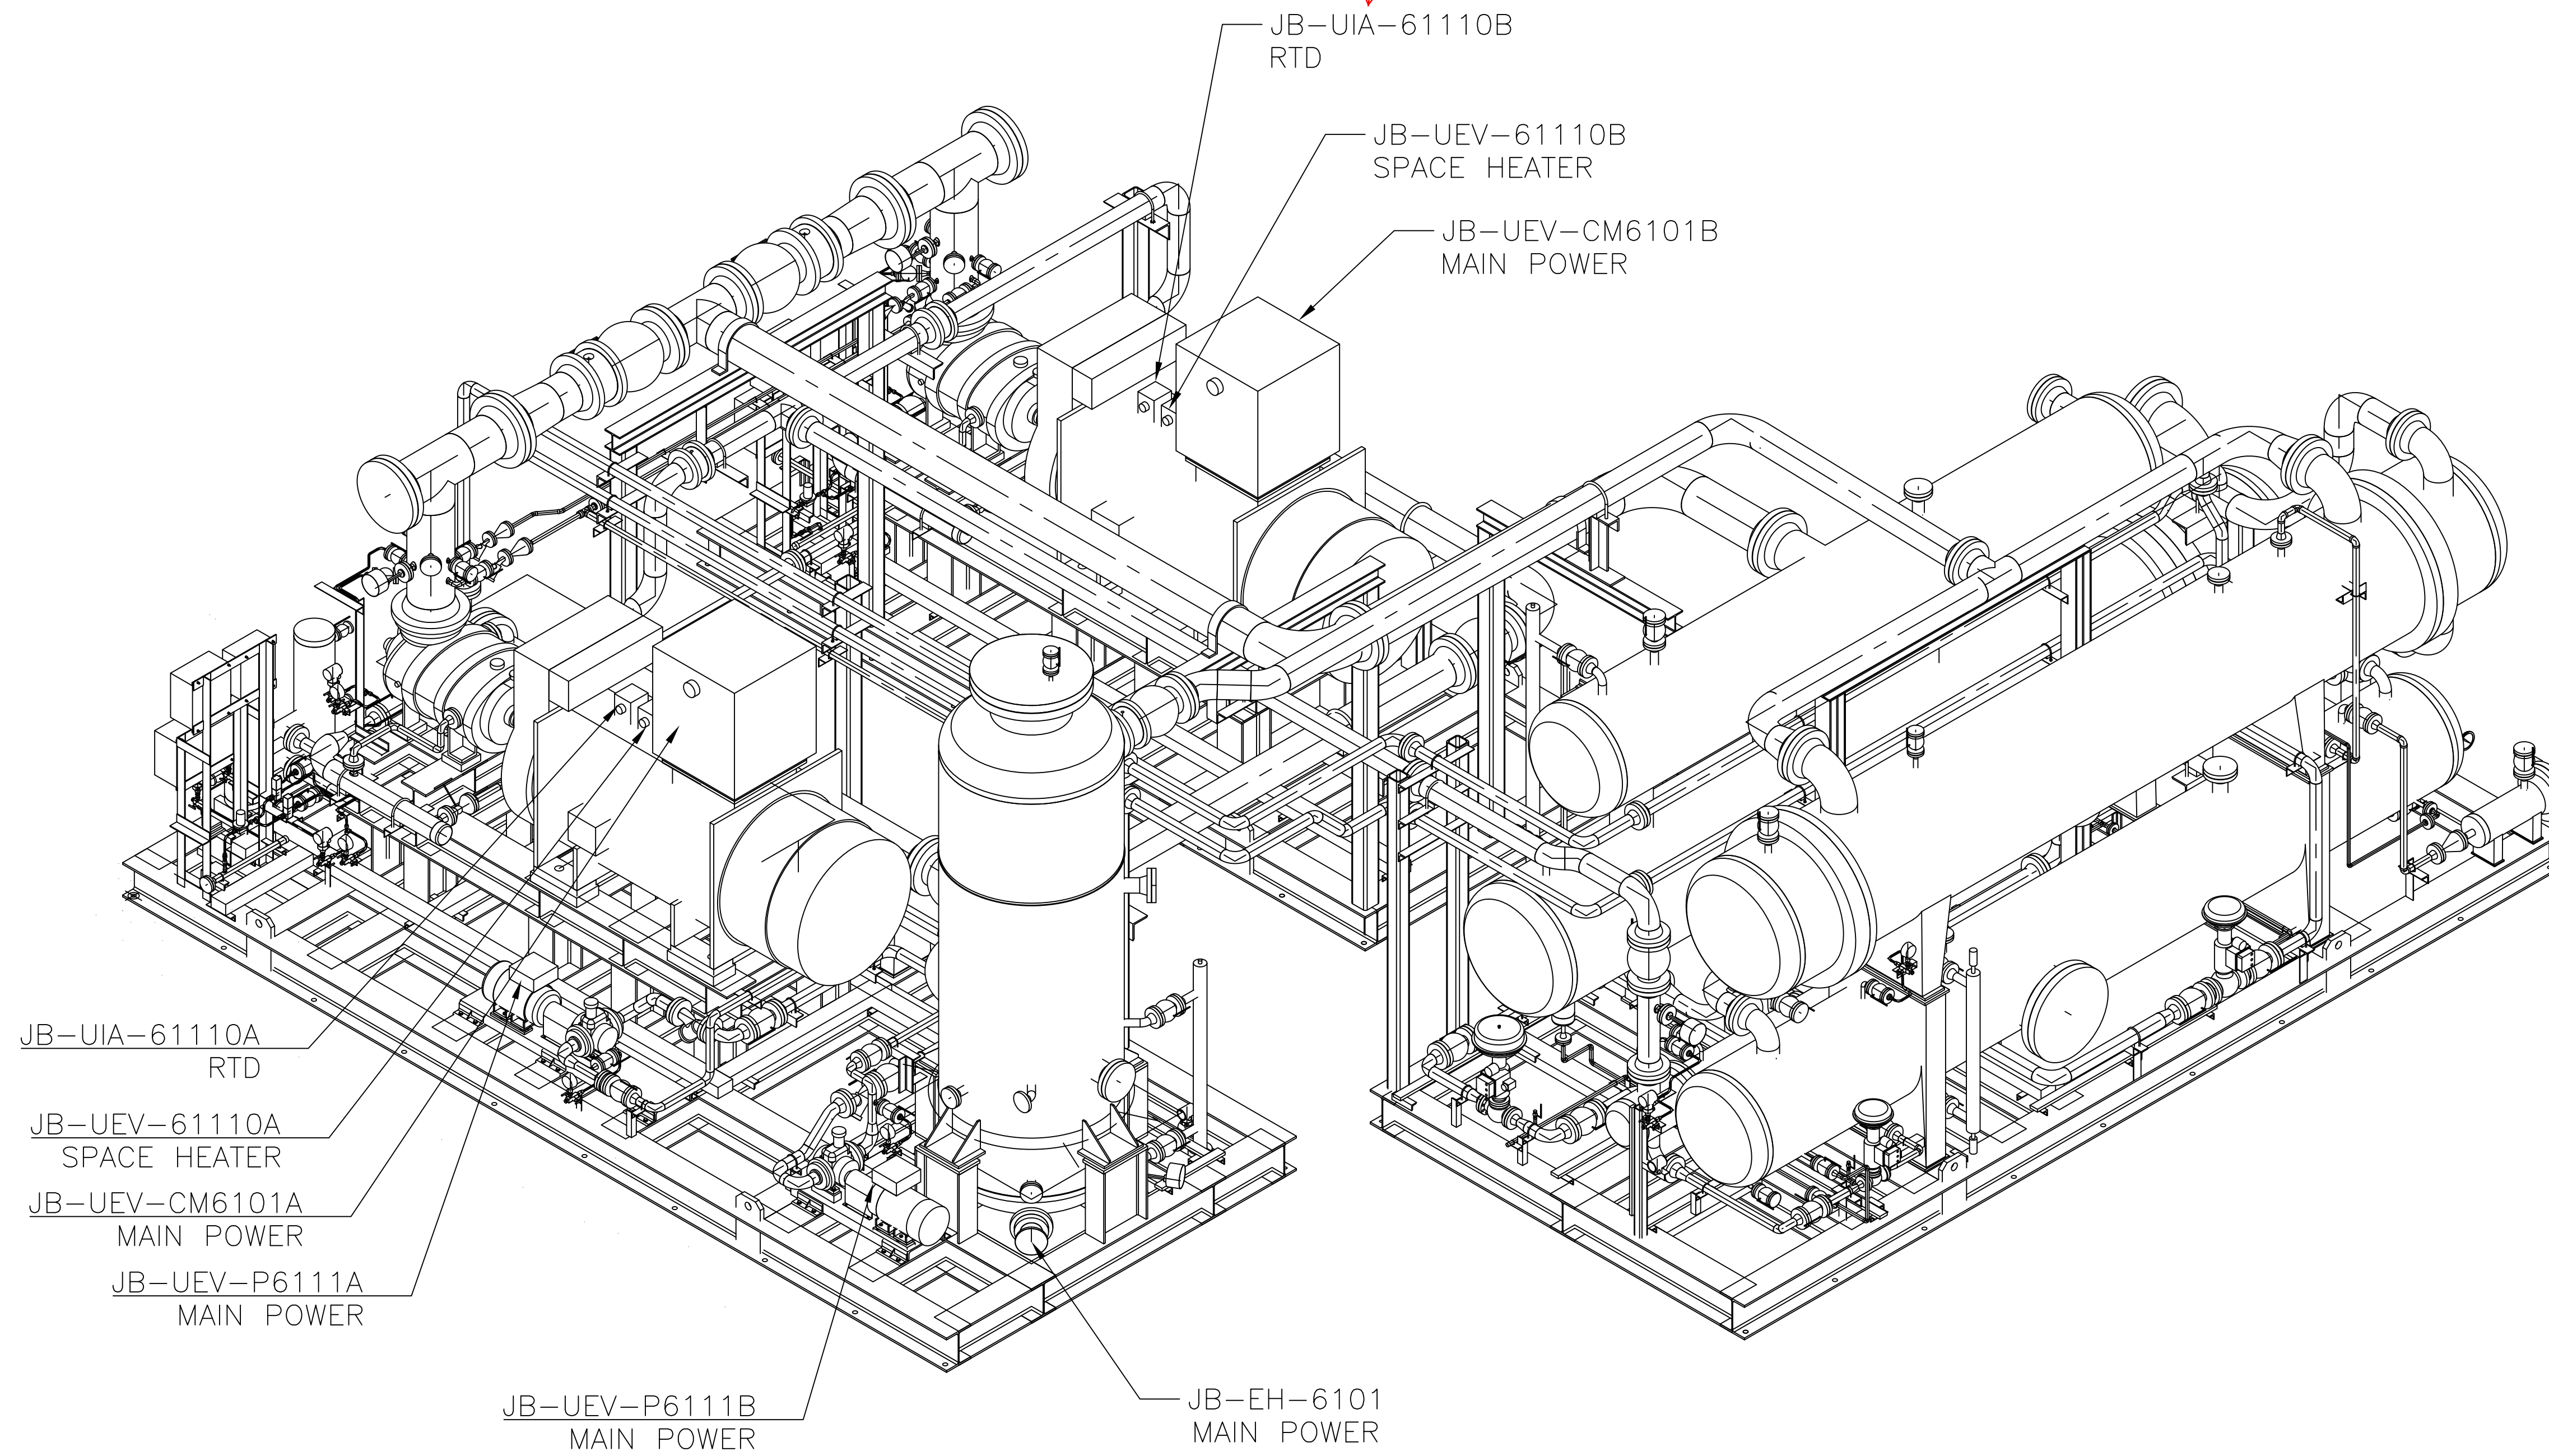

Code1	<input type="checkbox"/> No Comment/ Approved (Applicable Only for "FOR REVIEW" and "For Approval" Documents) No comment and the document are released for Manufacturing				
Code2	<input type="checkbox"/> No Comment / Approved with Note(s) Vendor/Sub-Contractor shall correct, revise and resubmit the document. The document is released for Manufacturing if changes incorporated.				
Code3	<input type="checkbox"/> Commented Vendor/Sub-Contractor shall correct, revise and resubmit the document by the date specified. The document shall be revised under the Status of "R: Revised Issue". All corrected documents shall be resubmitted before starting the Manufacturing Process				
Code4	<input type="checkbox"/> Not Accepted (Rejected) Vendor/Sub-Contractor shall re-work/re-design/re-specify the contents of the document according to the comments/reasons for rejection. All corrected documents shall be resubmitted before starting the manufacturing. Vendor Sub-Contractor shall not proceed with subsequent works of Material Supply or Manufacturing until receiving Code1/Code2 or No Code from PURCHASER. Vendor/Sub-Contractor shall resubmit the document with the same revision within 6 working days after receiving comments				
No Code	<input type="checkbox"/> No Code (Only for "For Information" Documents and "As Built DWGs") Document has been submitted for PURCHASER'S information (I). Consistency, completeness and correctness of document content is in Vendor/Sub-Contractor's responsibility. The above checking result by EIED shall in no way relieve Vendor of any liability, obligation and responsibility out of the purchase order and the mutual agreement in writing				
DATE :					
DEPT :					
Signature :					
CV	PI	EL	IN	ME	MA
ST	BU	FR	SA	HV	TL

04	20.12.25	IFR	FA	IM	OG
03	28.06.25	IFR	FA	IM	OG
02	28.06.25	IFR	FA	IM	OG
01	16.09.25	IFR	FA	IM	OG
00	28.06.25	IFR	FA	IM	OG
REV.	DATE (DD.MM.YY)	Purpose of Issue	Prepared	Checked	Approved


		Gachasan Plyomer Industries Company HDPE Plant	
PO No.: GPIC-PT-MA-PO-000-3029		SCALE: 3/8":1'	
DRAWING TITLE: GENERAL ARRANGEMENT DRAWING			
DRAWING NO. VD-GPIC-MA-3029-3029-0062	REV. 04	SHEET NO. 9 of 12	SIZE A1

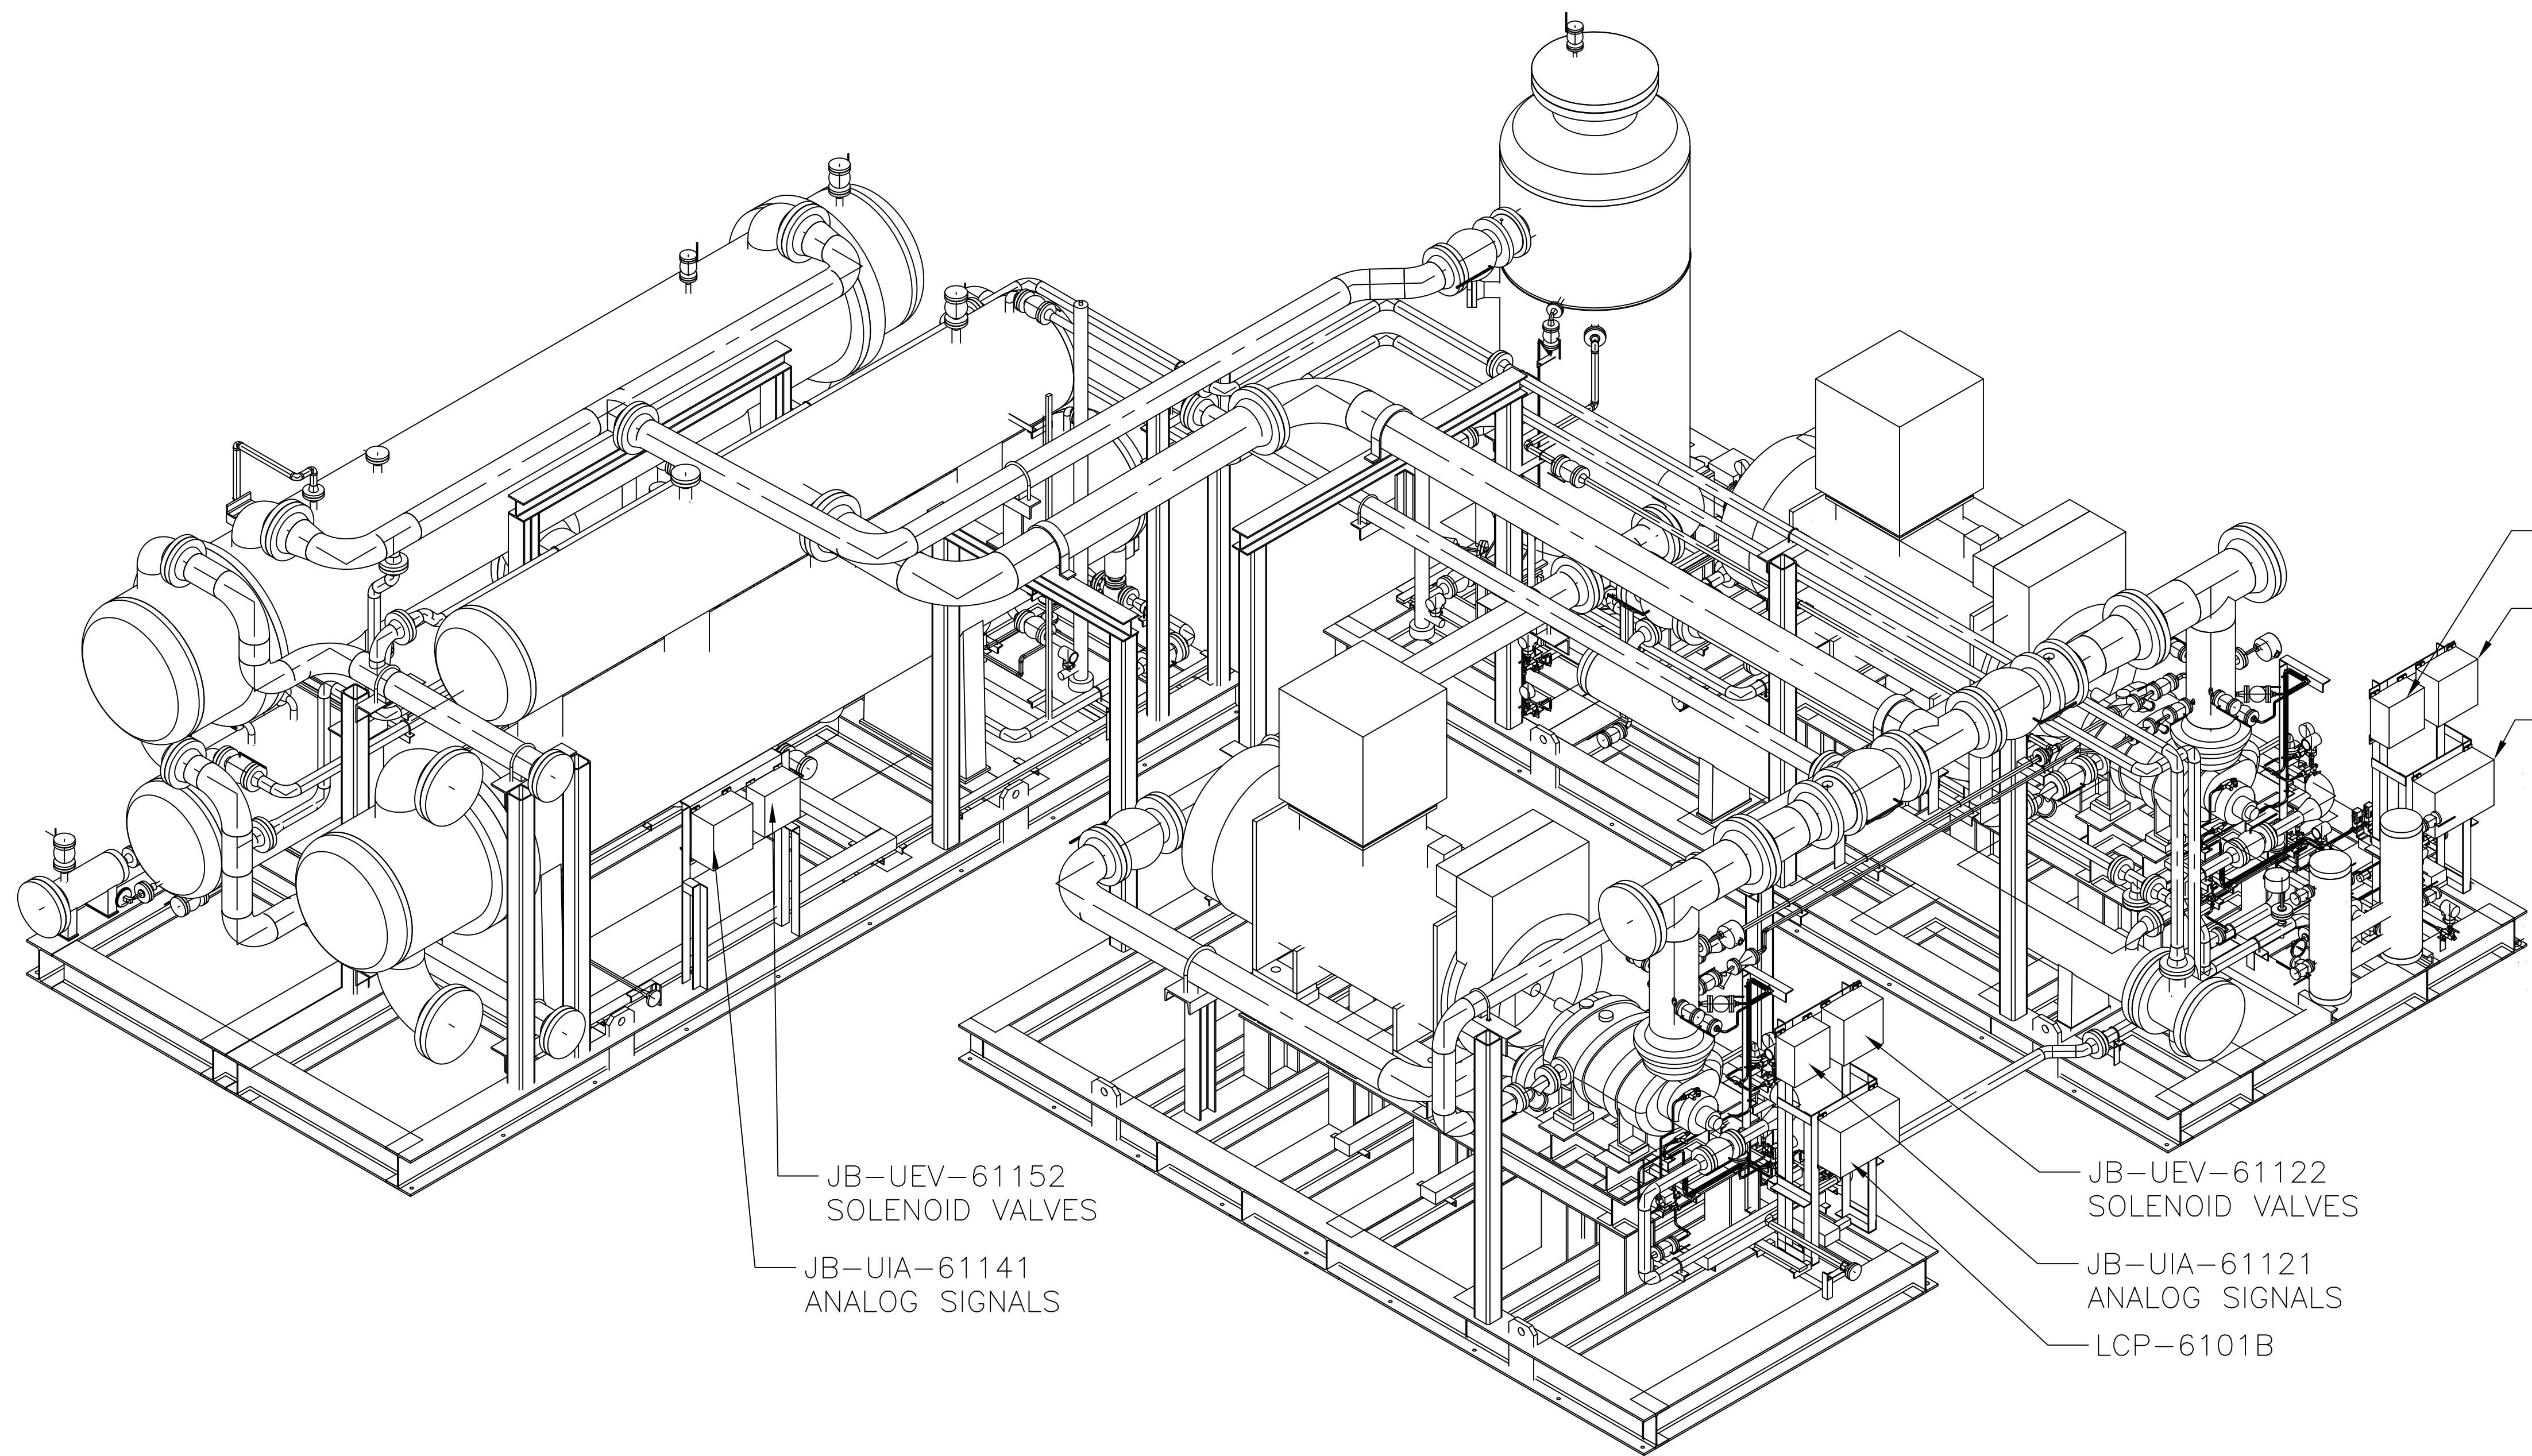





JB-UEV-61152
SOLENOID VALVES
JB-UIA-61141
ANALOG SIGNALS


JB-UEV-61112
SOLENOID VALVES
JB-UIA-61111
ANALOG SIGNALS
LCP-6101A

JB-UEV-61122
SOLENOID VALVES
JB-UIA-61121
ANALOG SIGNALS
LCP-6101B

Code1	<input type="checkbox"/> No Comment/ Approved (Applicable Only for "FOR REVIEW" and "For Approval" Documents) No comment and the document are released for Manufacturing				
Code2	<input type="checkbox"/> No Comment / Approved with Note(s) Vendor/Sub-Contractor shall correct, revise and resubmit the document. The document is released for Manufacturing if changes incorporated.				
Code3	<input type="checkbox"/> Commented Vendor/Sub-Contractor shall correct, revise and resubmit the document by the date specified. The document shall be revised under the Status of "R: Revised Issue". All corrected documents shall be resubmitted before starting the Manufacturing Process				
Code4	<input type="checkbox"/> Not Accepted (Rejected) Vendor/Sub-Contractor shall re-work/re-design/re-specify the contents of the document according to the comments/reasons for rejection. All corrected documents shall be resubmitted before starting the manufacturing. Vendor Sub-Contractor shall not proceed with subsequent works of Material Supply or Manufacturing until receiving Code1/Code2 or No Code from PURCHASER. Vendor/Sub-Contractor shall resubmit the document with the same revision within 6 working days after receiving comments				
No Code	<input type="checkbox"/> No Code (Only for "For Information" Documents and "As Built DWGs") Document has been submitted for PURCHASER'S information (I). Consistency, completeness and correctness of document content is in Vendor/Sub-Contractor's responsibility.				
The above checking result by EIED shall in no way release Vendor of any liability, obligation and responsibility out of the purchase order and the mutual agreement in writing					
 DATE : DEPT : Signature :					
CV	PI	EL	IN	ME	MA
ST	BU	FR	SA	HV	TL


04	20.12.25	IFR	FA	IM	OG
03	28.06.25	IFR	FA	IM	OG
02	28.06.25	IFR	FA	IM	OG
01	16.09.25	IFR	FA	IM	OG
00	28.06.25	IFR	FA	IM	OG
REV.	DATE (DD.MMM.YY)	Purpose of Issue	Prepared	Checked	Approved

 Gachasan Polymer Industries Company	 Gachasan Polymer Industries Company HDPE Plant	 
PO No.: GPIC-PT-MA-PO-000-3029		SCALE: 3/8":1'
DRAWING TITLE: GENERAL ARRANGEMENT DRAWING		
DRAWING NO. VD-GPIC-MA-3029-3029-0062	REV. 04	SHEET NO. 10 of 12
		SIZE A1

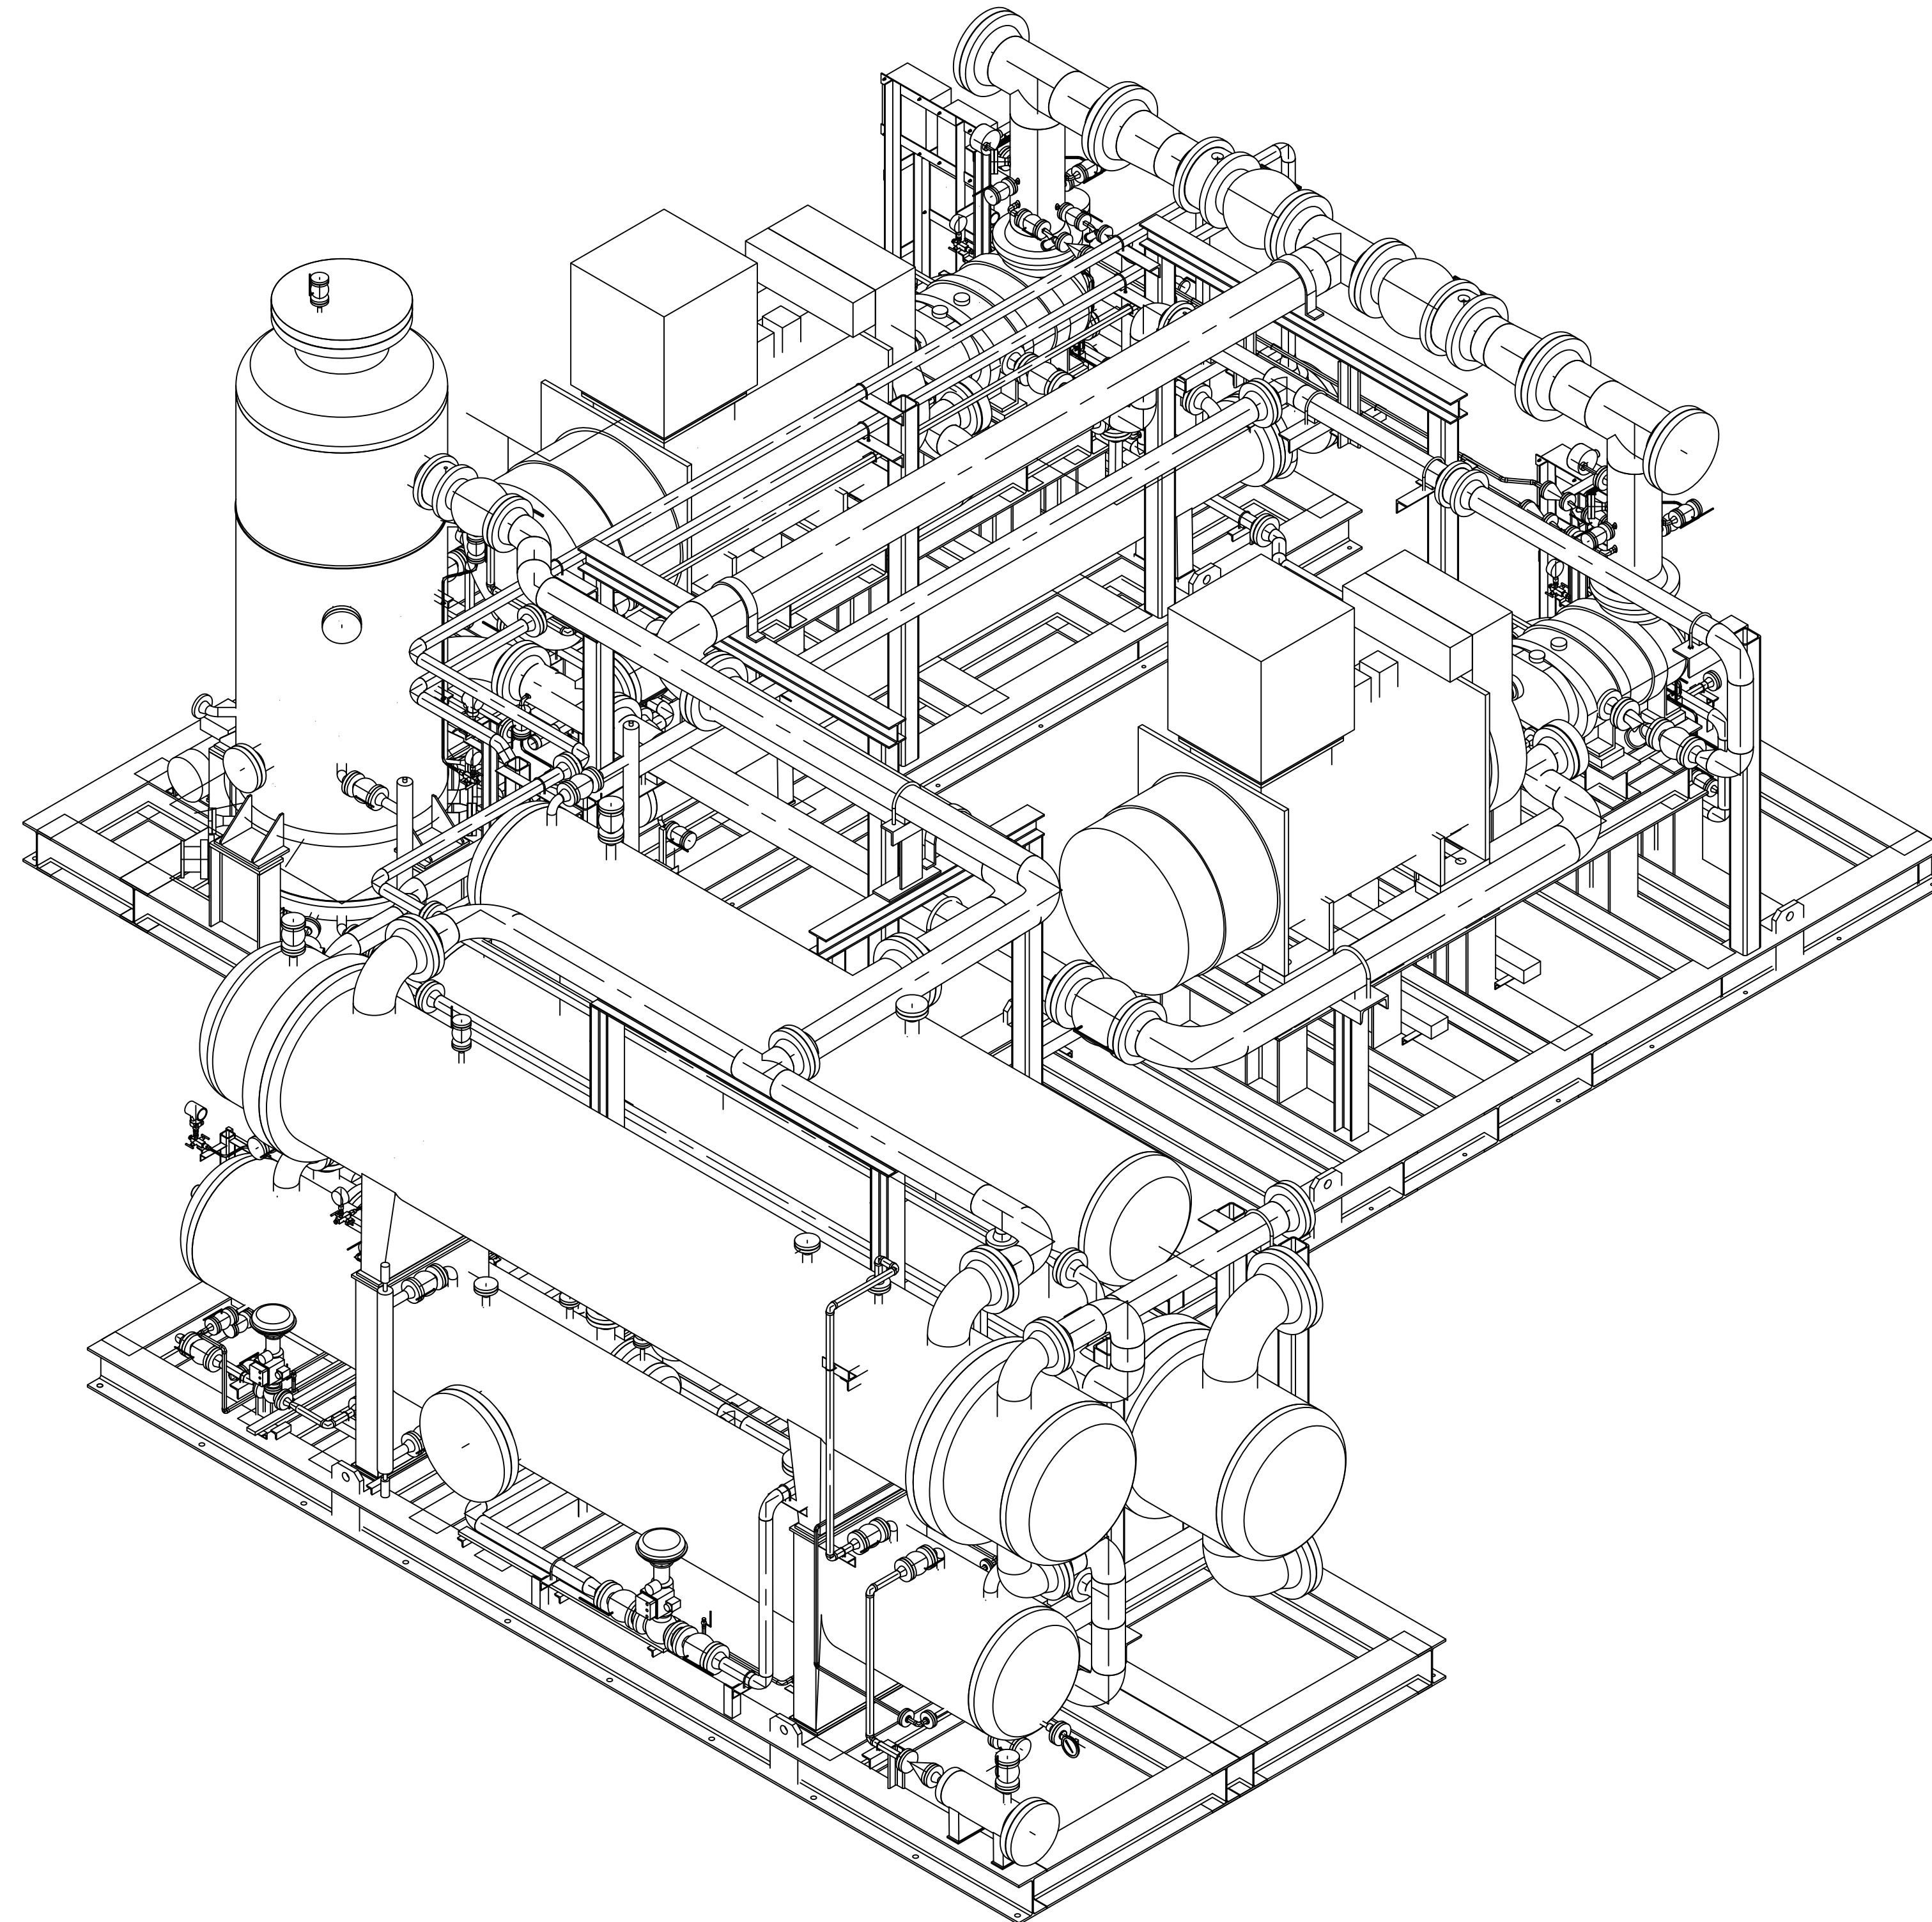





Code1	<input type="checkbox"/> No Comment/ Approved (Applicable Only for "FOR REVIEW" and "For Approval" Documents) No comment and the document are released for Manufacturing
Code2	<input type="checkbox"/> No Comment / Approved with Note(s) Vendor/Sub-Contractor shall correct, revise and resubmit the document. The document is released for Manufacturing if changes incorporated.
Code3	<input type="checkbox"/> Commented Vendor/Sub-Contractor shall correct, revise and resubmit the document by the date specified. The document shall be revised under the Status of "R: Revised Issue". All corrected documents shall be resubmitted before starting the Manufacturing Process
Code4	<input type="checkbox"/> Not Accepted (Rejected) Vendor/Sub-Contractor shall re-work/re-design/re-specify the contents of the document according to the comments/reasons for rejection. All corrected documents shall be resubmitted before starting the manufacturing. Vendor Sub-Contractor shall not proceed with subsequent work of Material Supply or Manufacturing until receiving Code1/Code2 or No Code from PURCHASER. Vendor/Sub-Contractor shall resubmit the document with the same revision within 6 working days after receiving comments
No Code	<input type="checkbox"/> No Code (Only for "For Information" Documents and "As Built DWGs") Document has been submitted for PURCHASER'S information (I). Consistency, completeness and correctness of document content is in Vendor/Sub-Contractor's responsibility.

The above checking result by EIED shall in no way release Vendor of any liability, obligation and responsibility out of the purchase order and the mutual agreement in writing


 DATE : _____
 DEPT: _____
 Signature : _____

CV	PI	EL	IN	ME	MA
ST	BU	FR	SA	HV	TL

04	20.12.25	IFR	FA	IM	OG
03	28.06.25	IFR	FA	IM	OG
02	28.06.25	IFR	FA	IM	OG
01	16.09.25	IFR	FA	IM	OG
00	28.06.25	IFR	FA	IM	OG
REV.	DATE (DD.MM.YY)	Purpose of Issue	Prepared	Checked	Approved

 Gachsaran Polymer Industries Company		Gachsaran Polymer Industries Company HDPE Plant	 
---	---	--	--

PO No.: GPIC-PT-MA-PO-000-3029 SCALE: 3/8":1'

DRAWING TITLE: **GENERAL ARRANGEMENT DRAWING**

DRAWING NO.	REV.	SHEET NO.	SIZE
VD-GPIC-MA-3029-3029-0062	04	11 of 12	A1

