












OWNER:  شرکت سست و سویی آمو ایرانیان (سهامی خاص)	BUSHEHR PETROCHEMICAL COMPANY MEG PLANT							EPC CONTRACTOR:  Chagalesh-Enerchimi-Steam Joint Venture BUPC-MEG PLANT PROJECT	
	UCP/LCP/JB GENERAL ARRANGEMENT DRAWING & TERMINAL DETAILS FOR EMERGENCY INSTRUMENT AIR COMPRESSOR INCL. BOM							 Netherlands	
MC:  شرکت سست و سویی آمو ایرانیان (سهامی خاص)	Project	Area	Phase	Unit	Dis.	Doc.	Seq.	Contract No: 52-98/445	
Owner Document Number: 17811-07B	BU	20	VD	303	IN	DWG	0089	Rev.:	Page
								05	1 of 8

UCP/LCP/JB GENERAL ARRANGEMENT DRAWING & TERMINAL DETAILS FOR EMERGENCY INSTRUMENT AIR COMPRESSOR INCL. BOM

 شرکت سست و سویی آمو ایرانیان (سهامی خاص)	 Chagalesh-Enerchimi-Steam Joint Venture BUPC-MEG PLANT PROJECT	BUSHEHR PETROCHEMICAL COMPANY MEG PLANT
Document Review		
Issue Purpose:	IFA	
Result Code: AP,AN,CM,RE,NC	AN	
Next Status : IFC,IFA,IFI,AFC,AB	AFC	
Responsible Department	MECHANICAL	
Commented Date	Oct.15,2022	
Approval or review hereunder shall not be construed to relieve Vendor / Subcontractor of his responsibilities and liability under the contract.		

05	30/09/2022	For approval	BK	RB	KP	
04	08/08/2022	For approval	BK	RB	KP	
03	16/06/2022	For approval	BK	RB	KP	
02	14/12/2021	For approval	HT	RB	KP	
01	19/10/2021	For approval	HT	RB	KP	
00	24/11/2020	For approval	HT	RB	KP	
Rev.	Date	Purpose of Issue	Prepared	Checked	Approved	AC Code
					Class: 1	Phase: P

OWNER:  شرکت ست و سوبی نوس ایرپان (سهامی خاص)	BUSHEHR PETROCHEMICAL COMPANY MEG PLANT						EPC CONTRACTOR  Chagalesh-Enerchimi-Steam Joint Venture BUPC-MEG PLANT PROJECT		
	UCP/LCP/JB GENERAL ARRANGEMENT DRAWING & TERMINAL DETAILS FOR EMERGENCY INSTRUMENT AIR COMPRESSOR INCL. BOM						 Netherlands		
MC:   شرکت ست و سوبی نوس ایرپان (سهامی خاص)	Project	Area	Phase	Unit	Dis.	Doc.	Seq.	Contract No: 52-98/445	
Owner Document Number: 17811-07B	BU	20	VD	303	IN	DWG	0089	Rev.:	Page
								05	2 of 8

TABULATION OF REVISED PAGES

Page	D01	D02	D03	D04	D05
1.	X	X	X	X	X
2.	X	X	X	X	X
3.	X	X	X	X	X
4.	X	X	X	X	X
5.	X	X	X	X	X
6.	X	X	X	X	X
7.	X	X	X	X	X
8.	X	X	X	X	X
9.					
10.					
Page	D00	D01	D02	D03	D04
35.					
36.					
Nr	Description	Tagnumber	Make	Qty	Modelnumbers
1.	Panel power on lamp (white)	2H19	Schneider	1	XB4BVB1
2.	Display	8A9	Siemens	1	6AV2124-0MC01-0AX0
3.	Hourmeter	25U12	Bauser	1	629.2
4.	Operational lamp (green)	25H4	Schneider	1	XB4BVB3
5.	Running lamp (green)	25H6	Schneider	1	XB4BVB3
6.	Common alarm lamp (amber)	25H8	Schneider	1	XB4BVB5
7.	Common trip lamp (red)	25H10	Schneider	1	XB4BVB4
8.	Start pushbutton (green)	11S4	Schneider	1	XB4BA31
9.	Stop pushbutton (red)	11S6	Schneider	1	XB4BA42
10.	Accept pushbutton (black)	11S10	Schneider	1	XB4BA21
11.	Reset pushbutton (black)	11S12	Schneider	1	XB4BA21
12.	Lamp test pushbutton (black)	11S8	Schneider	1	XB4BA21
13.	ESD button	3S6	Schneider	1	(XB4BS8444 + ZBZ1605)
14.	Maintenance switch	2S2, 2S4, 2S6	Schneider	3	VBF01
15.	Panel fan + outlet filter	2M14	Rittal	1	SK3239.124 + SK3239.200
16.	PLC power supply	5M2, 5M11	Siemens	2	6ES7405-0KR02-0AA0
17.	CPU	5M3, 5M12	Siemens	2	6ES7414-5HM06-0AB0
18.	CP443-1 Communication module	5M5, 5M14	Siemens	2	6GK7443-1EX30-0XE0
19.	Panel light	2H10	Rittal	1	SZ2500.200/400/470
20.	Ethernet switch	5M18	Siemens	1	6GK7277-1AA10-0AA0
21.	IM153-2 HF Profibus DP module	6M2, 6M4, 7M2, 7M4	Siemens	4	6ES7153-2BA10-0XBA
22.	24 Digital input module	6M7, 6M9, 7M7, 7M9	Siemens	4	6ES7326-1BK02-0AB0
23.	6 Analog input module	6M10, 6M12, 6M14, 7M10, 7M12, 7M14	Siemens	6	6ES7336-4GE00-0AB0
24.	10 Digital output module	6M15, 6M16, 6M18, 6M19, 7M15, 7M16, 7M18, 7M19	Siemens	8	6ES7326-2BF10-0AB0
25.	Interface relay	24K4/6, 27K8, 28K3/5/8/10/12, 30K4/6/10, 56K4/6/8/10/13/15/17, 57K8/10/12/17, 58K9	Phoenix contact	24	296617
26.	Miniature circuit breaker 1P+N 110VAC / 230VAC	2F9, 2F11, 2F15, 2F17	Schneider	4	A9P54 (606/ 602/ 610/ 610)
27.	Thermostat	2TH11, 2TH14	Rittal	2	SK3110000
28.	Panel power supply	2V15, 2V17	Phoenix contact	2	2866776
29.	Miniature circuit breaker 1P	215.1, 2F17.1	Schneider	2	A6N61512
30.	Loop splitter	9U4/5/6/6.1/7/8/9/10/11/12/13	Pepperl+Fuchs	17	KFD2-STC5-EX1.20
31.	Panel heater	2U13	Rittal	1	SK3105320
32.	Miniature circuit breaker 2P 24VDC	5F2, 5F11	Schneider	2	A9N61526
33.	Diode	9V4, 9V4.1, 24V4/6, 25V4/6/8/10/12, 26V4/6/8/10/12, 27V4/6/8, 28V3/5/8/10/12, 30V4/6/10 47V4/6, 48V4/6/8/10/12, 49V4/6/8/10/12, 50V4/6/8, 51V4/6/8/10/12, 53V4/6/10	Phoenix contact	48	3064137
35.	PID controller	58U5	Omron	1	(E5CC-CX3D5M-005+492F-52)
36.	Quint diode	2G15	Phoenix contact	1	2907719

GENERAL NOTES
1. Tag numbers correspond with electrical diagram
2. All the parts that are on the list in the panel layout will be included in the IOM.




REFERENCE DRAWINGS	DWG.No.
WIRING DIAGRAM	BU-20-VD-303-IN-DIG-009.3

Please clarify why ESD relay has been removed.

Shall be in one cell

Nr	Description	Tagnumber	Make	Qty	Modelnumbers
X0	Terminal strip	X0...	Weidmuller	9	WDU4
X1	Terminal strip	X1...	Weidmuller	10	WDU4
X2	Terminal strip	X2...	Weidmuller	44	WDU4
X4	Terminal strip	X4...	Weidmuller	16	WDU4
X5	Terminal strip	X5...	Weidmuller	30	WDU4
X8	Terminal strip	X8...	Weidmuller	22	WDU4
X9	Terminal strip	X9...	Weidmuller	9	WDU4
X10	Terminal strip	X10...	Weidmuller	9	WDU4
X11	Terminal strip	X11...	Weidmuller	4	WDU4

05/26/09/22	For approval	RT	RB	RB	RB	1	
04/04/08/22	For approval	BK	RB	RB	RB	1	
03/15/06/22	For approval	BK	RB	RB	RB	1	
02/14/12/21	For approval	HT	RB	RB	RB	1	
01/19/10/21	For approval	HT	RB	RB	RB	1	
00/24/11/20	For approval	HT	RB	RB	RB	1	
REV	DATE	PURPOSE OF ISSUE (P.O.I.)		PREP.	CHKD.	APPR.	AC.

OWNER:  MC:  CONTRACTOR: 


PROJECT: BUSHEHR PETROCHEMICAL COMPANY
MEG PLANT

DRAWING TITLE: 17811-07B
UCP/LOP//B GENERAL ARRANGEMENT DRAWING & TERMINAL DETAILS FOR EMERGENCY INSTRUMENT AIR COMPRESSOR

CONTRACT NO.	SCALE	SIZE	CLASS	PHASE						
52-98/445	XX	A0	1	P						
DOCUMENT NO.	PROJECT	AREA	PHASE	MRO	NO.	DIS.	DOC.	SEQ.	SHEET	REV. NO.
OWNER DOC. NO.: BU-20-VD-303-IN-DWG-0089	BU-20-VD-303-IN-DWG-0089								1 OF 6	05


This drawing is issued to inform you that it is prepared in accordance with the standards of the IEC 60317-1 and IEC 60317-2. It is not intended for use in any other way than as a reference. THE USER OF THIS DOCUMENT IS RESPONSIBLE FOR THE PROPER USE OF THE INFORMATION CONTAINED HEREIN.

FRONT SIDE (OUTSIDE) VIEW

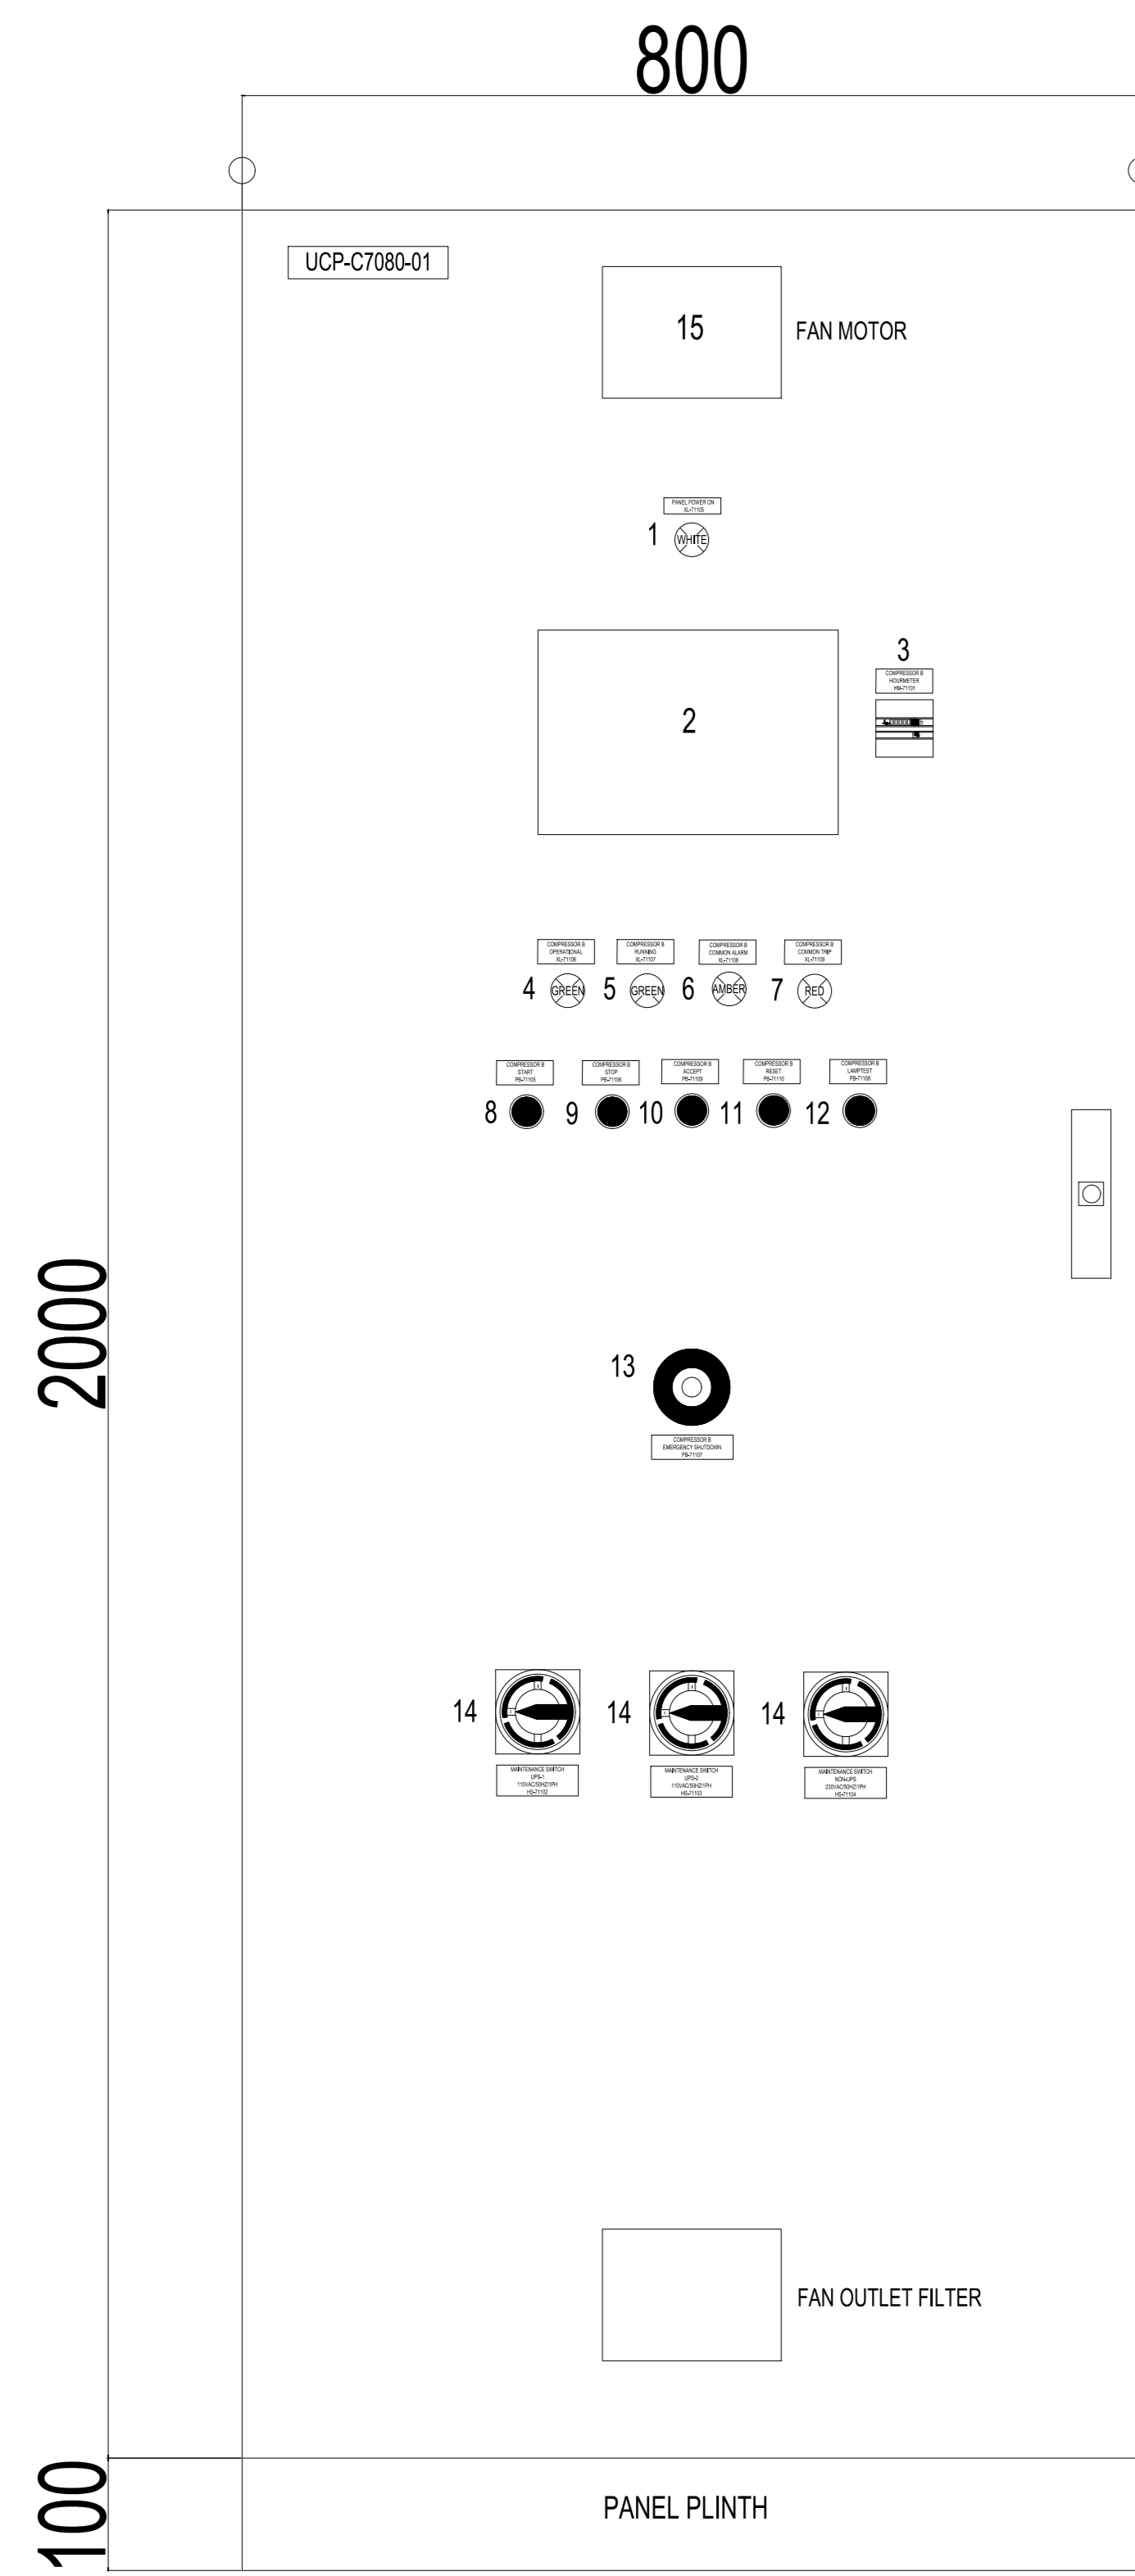


Please clarify why ESD relay has been removed.

FRONT SIDE (INSIDE) VIEW

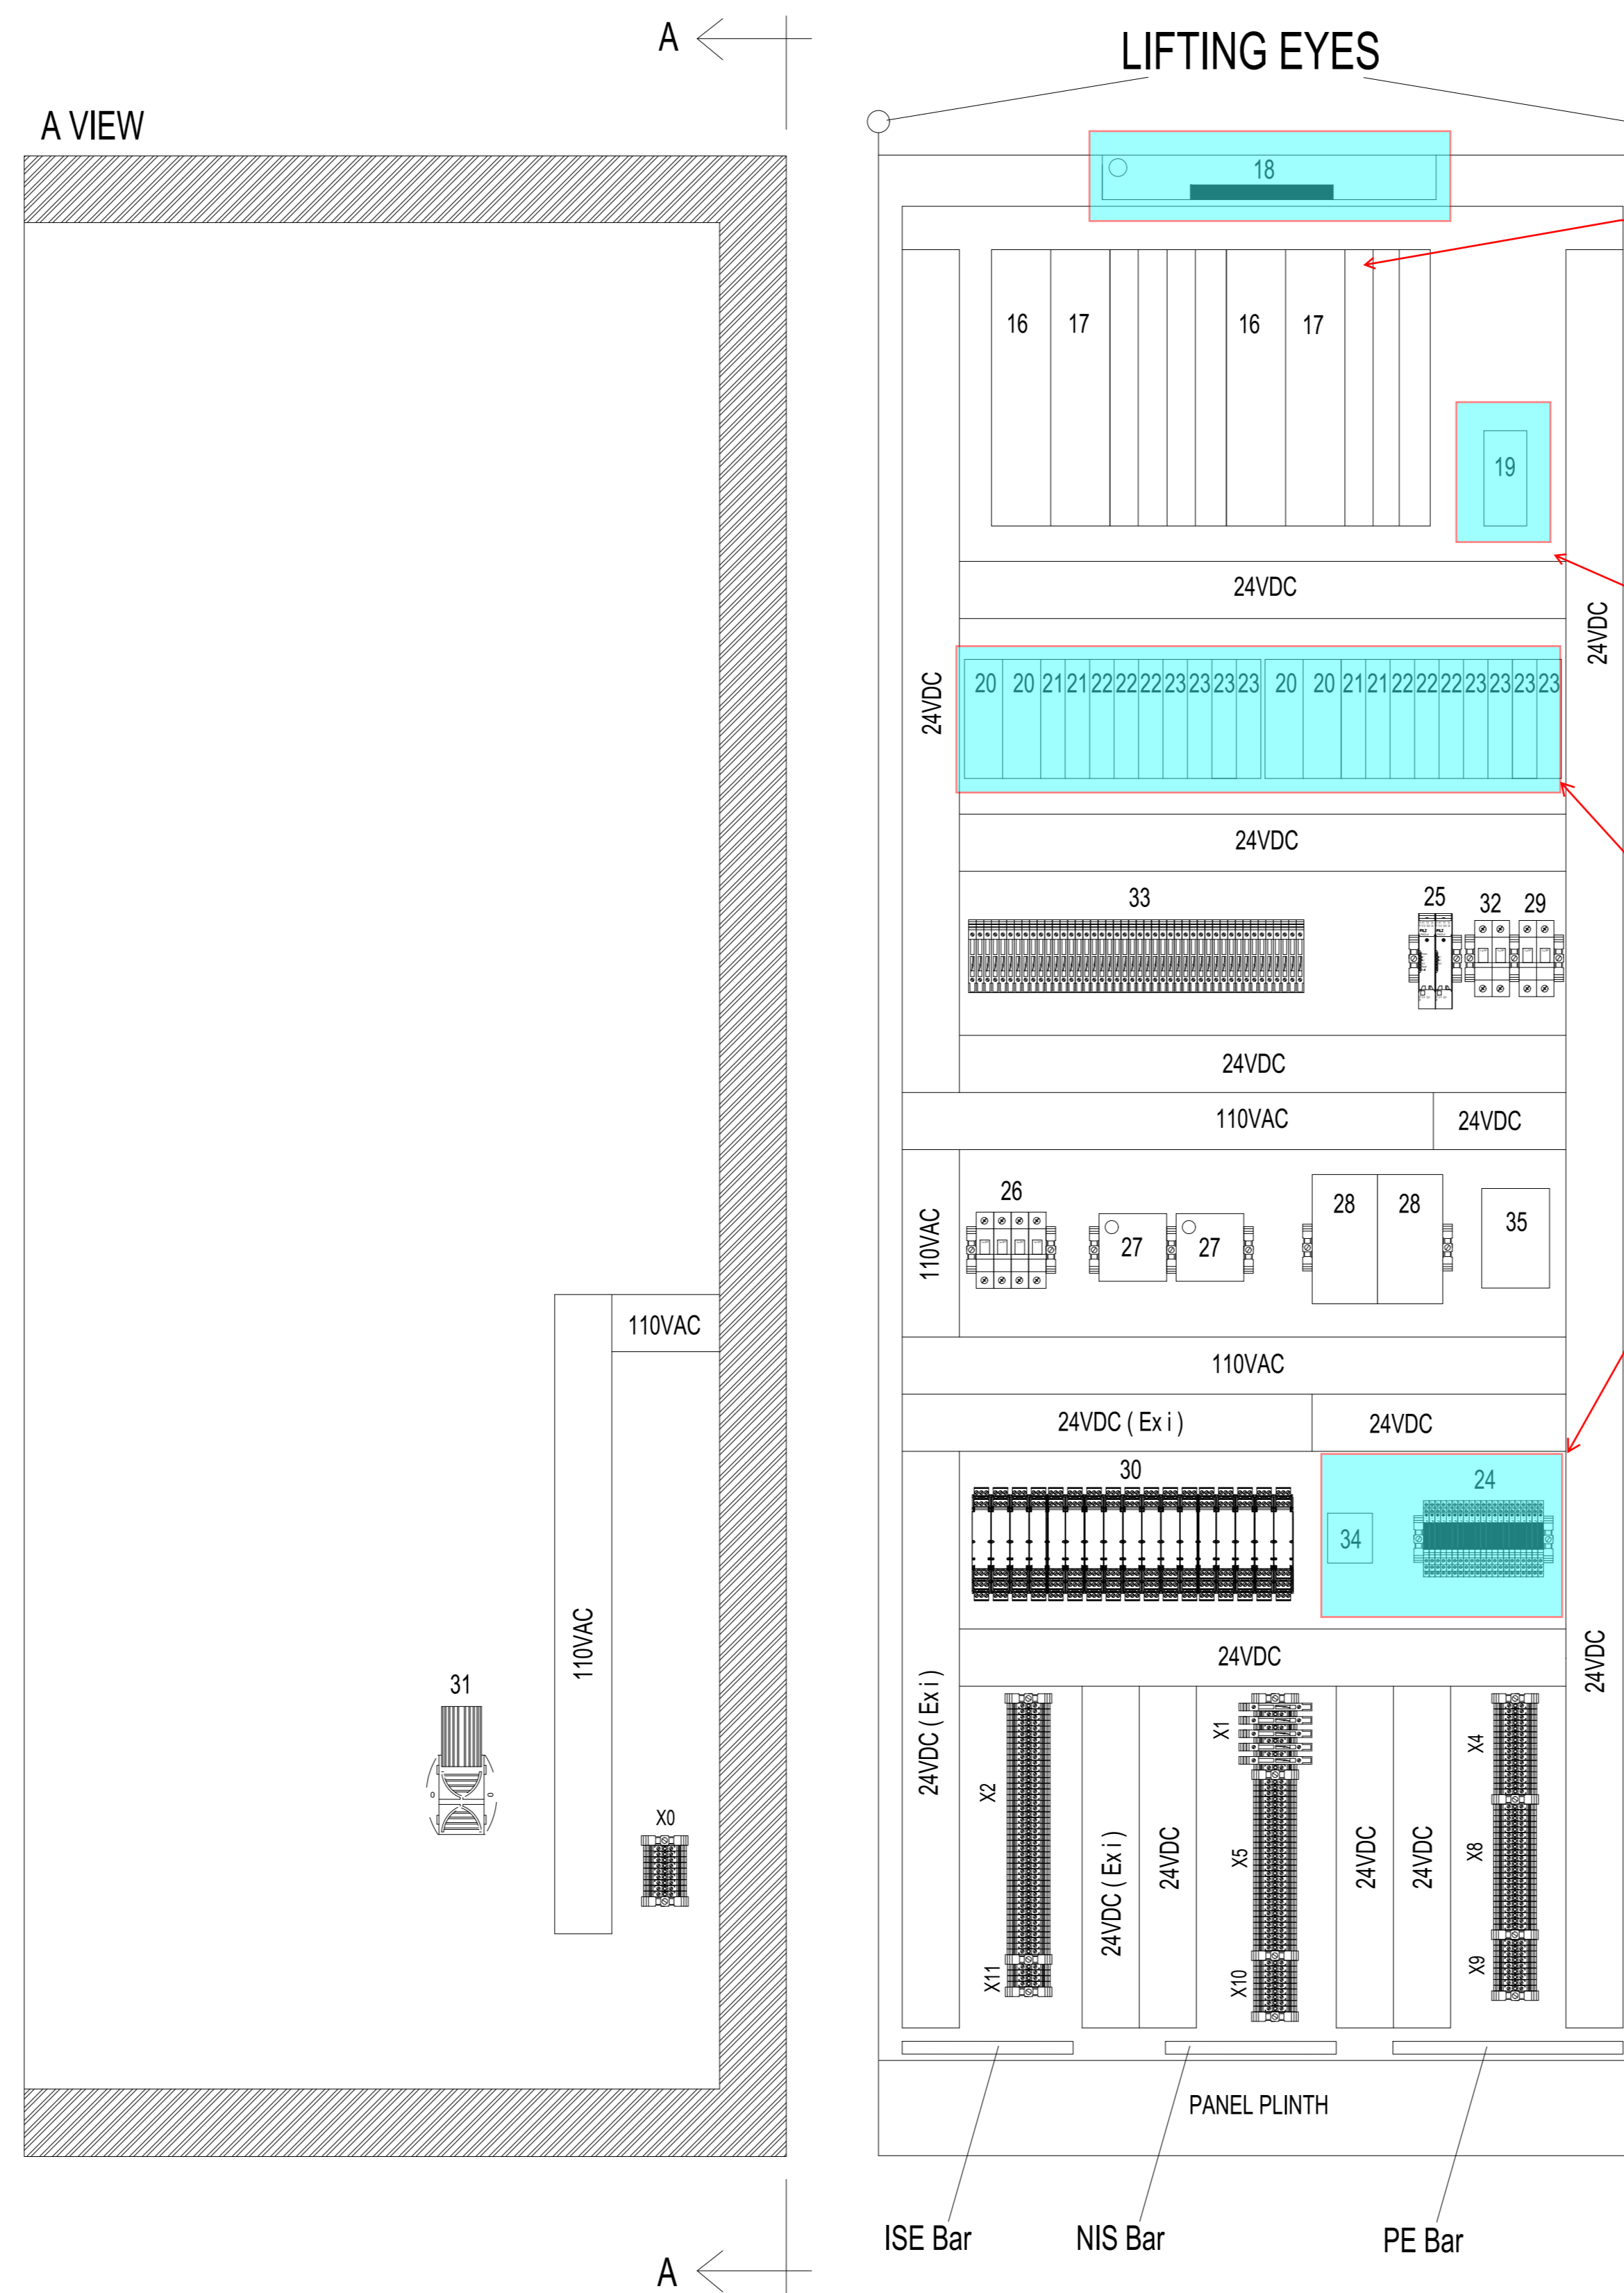

SIDE (OUTSIDE) VIEW

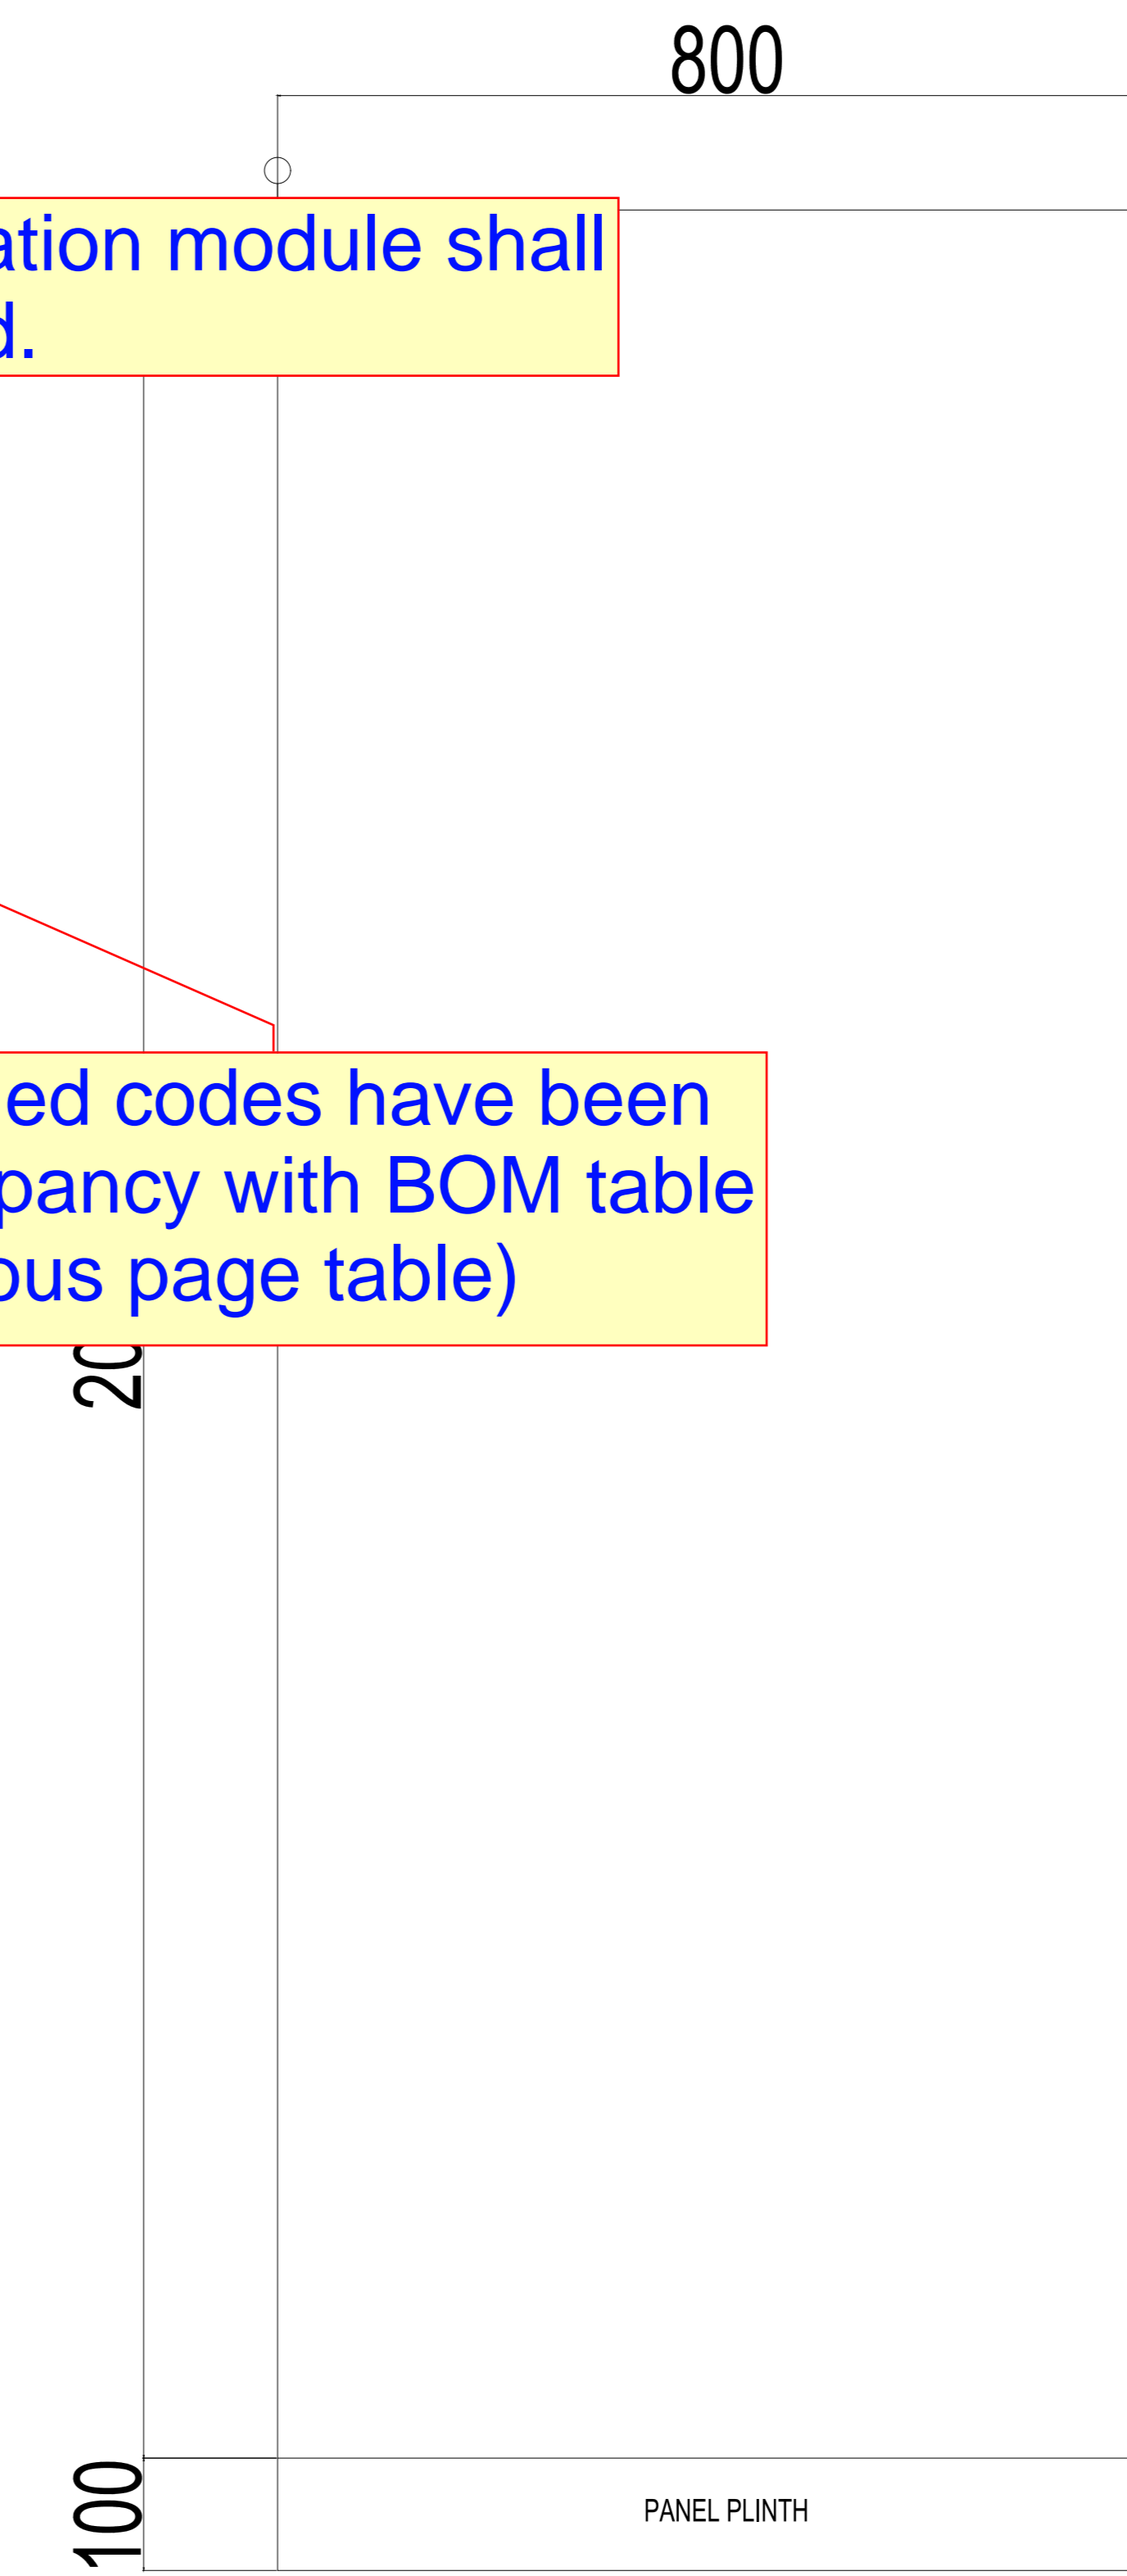

Communication module shall be specified.


specified codes have been discrepancy with BOM table (previous page table)

GENERAL NOTES


1. Panel material: Painted sheet steel (RAL7035)
2. Ingress protection: IP-42
3. Panel dimensions: 2100x800x800 mm
4. Area classification: Safe area
5. Drawing pocket will be included: (A3 format)

REFERENCE DRAWINGS	DWG.No.
WIRING DIAGRAM	BU-20-VD-303-IN-DIG-009.3


Nameplate for UCP panel

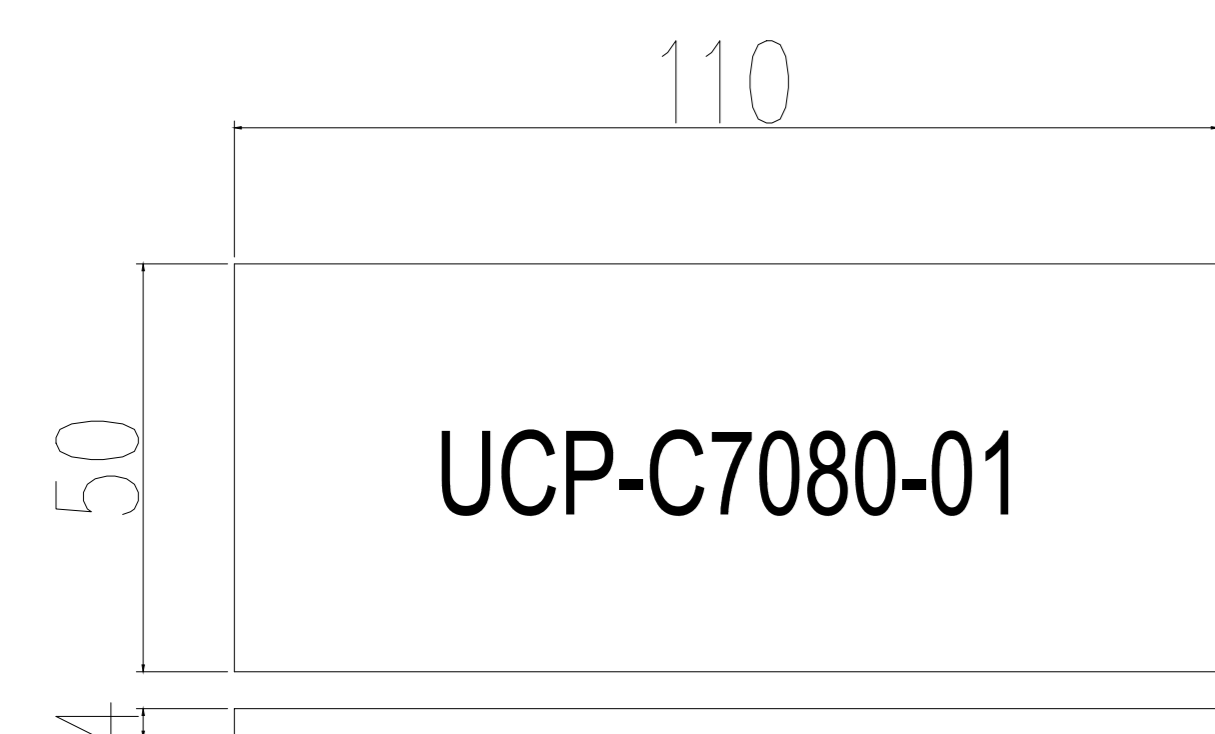


Nameplate for components on panel door (Typical)

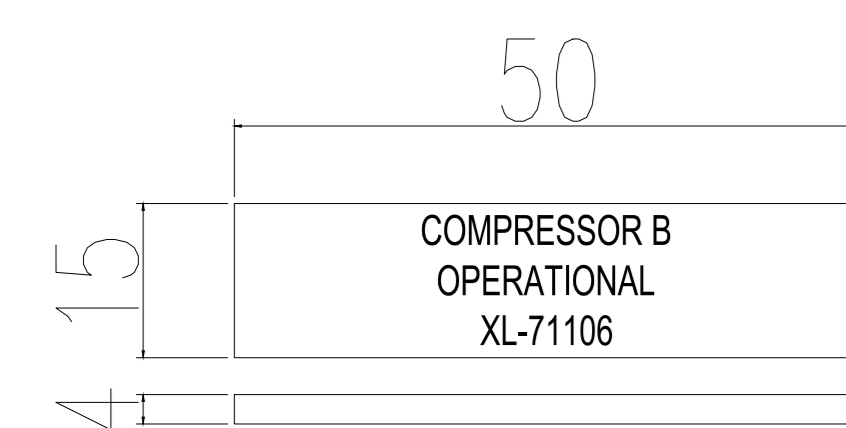

PLINTH FIXING HOLES

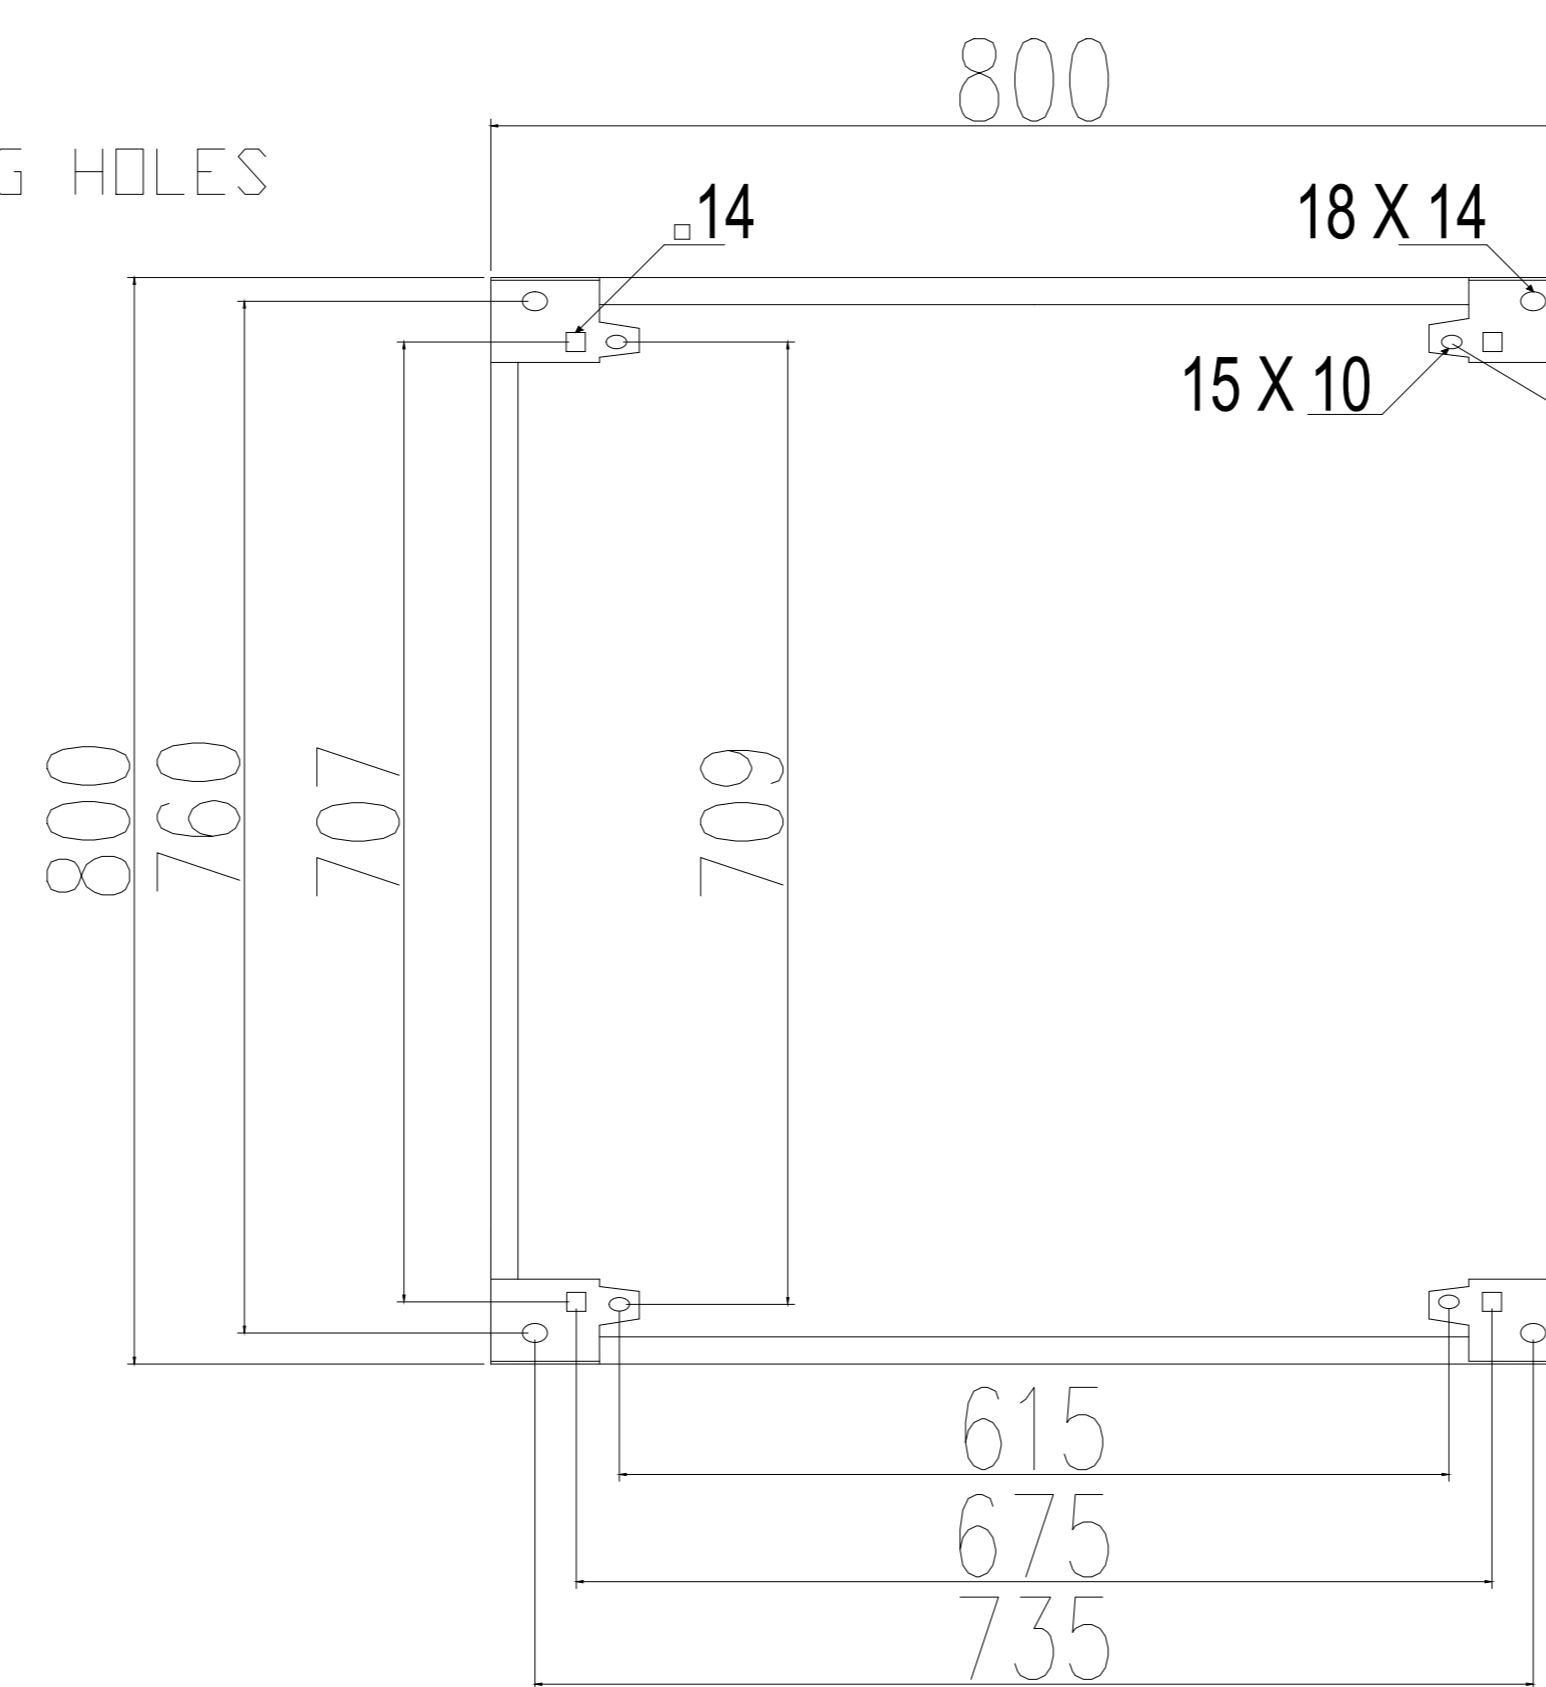

GLAND PLATE MOUNTING DETAILS

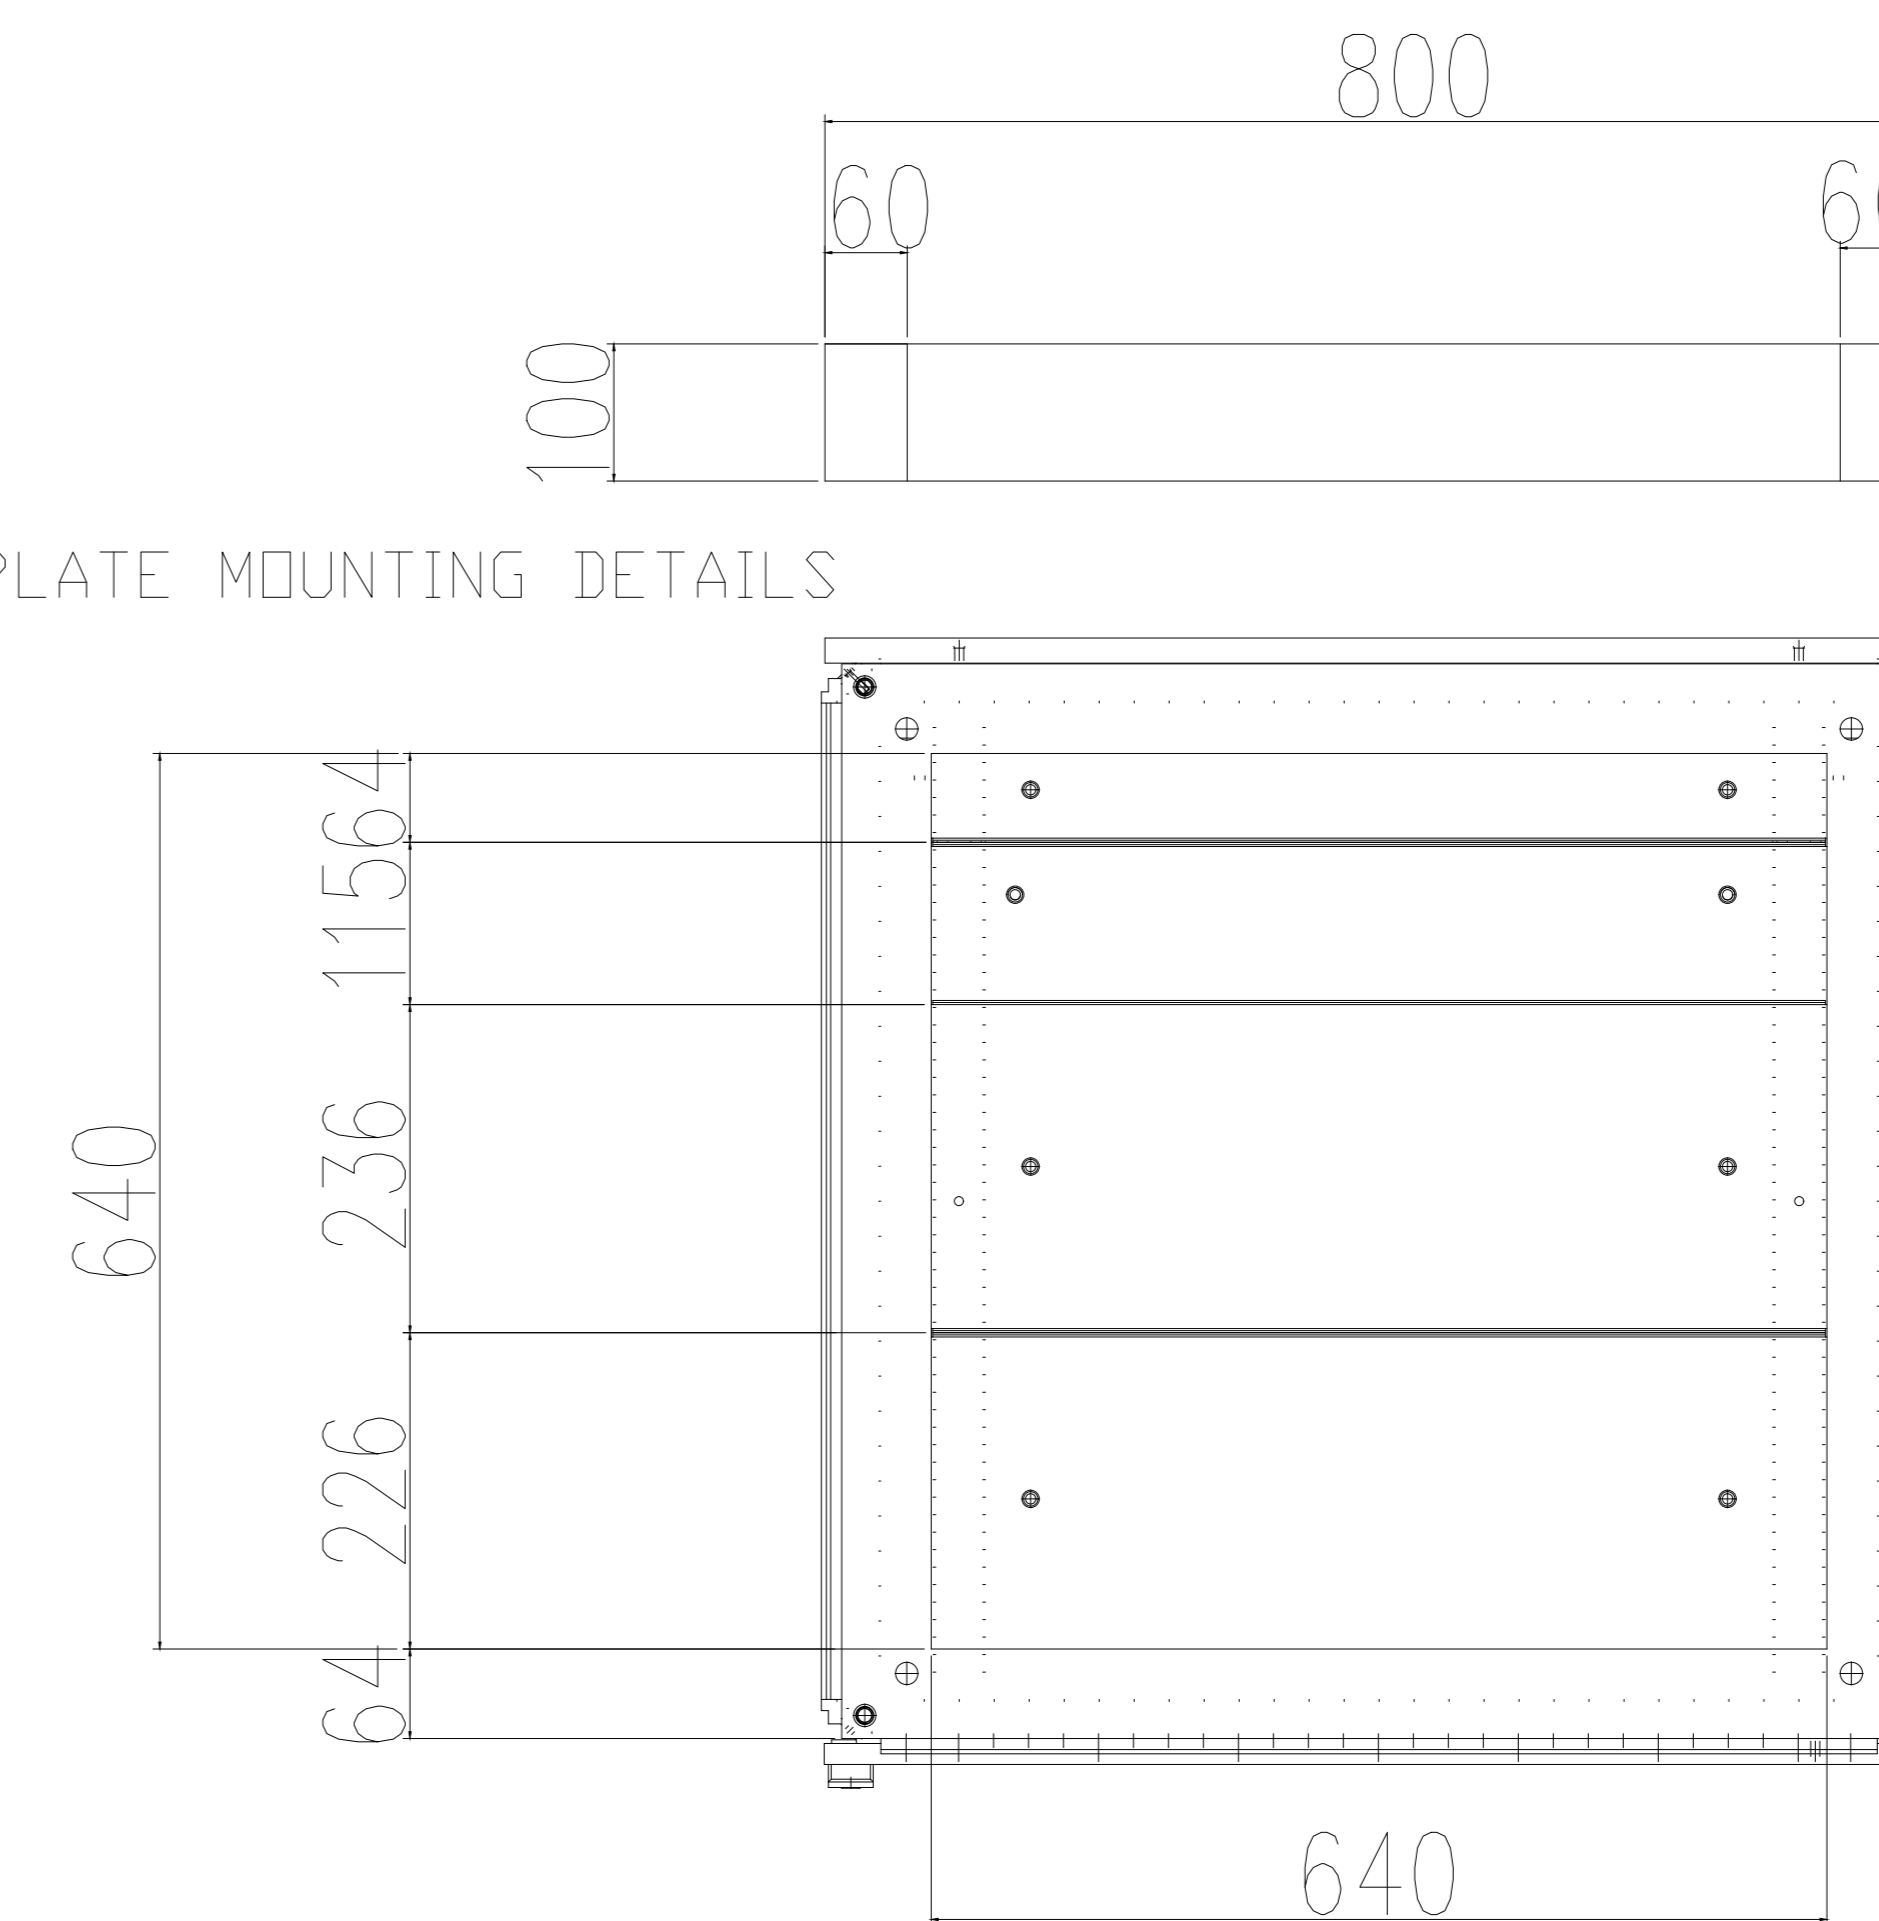

REV.	DATE	PURPOSE OF ISSUE (P.O.I.)	PREP.	CHKD.	APPR.	AC.
05	26/09/22	For approval	RT	RB	RB	I
04	04/08/22	For approval	BK	RB	RB	I
03	15/06/22	For approval	BK	RB	RB	I
02	14/12/21	For approval	HT	RB	RB	I
01	19/10/21	For approval	HT	RB	RB	I
00	24/11/20	For approval	HT	RB	RB	I

OWNER:

MC:

CONTRACTOR:


PROJECT: BUSHEHR PETROCHEMICAL COMPANY MEG PLANT

DRAWING TITLE: 17811-07B
UCP/LOP/B GENERAL ARRANGEMENT DRAWING & TERMINAL DETAILS FOR EMERGENCY INSTRUMENT AIR COMPRESSOR


CONTRACT NO.	SCALE	SIZE	CLASS	PHASE			
52-98/445	XX	A0	1	P			
DOCUMENT NO.	PROJECT AREA	PHASE MRO No.	DIS.	DOC.	SEQ.	SHEET	REV. NO.
OWNER DOC. NO.: BU-20-VD-303-IN-009-009	BU-20-VD-303-IN-DWG-0089					2 OF 6	05

JNDX-C7080-01


FRONT SIDE (OUTSIDE) VIEW

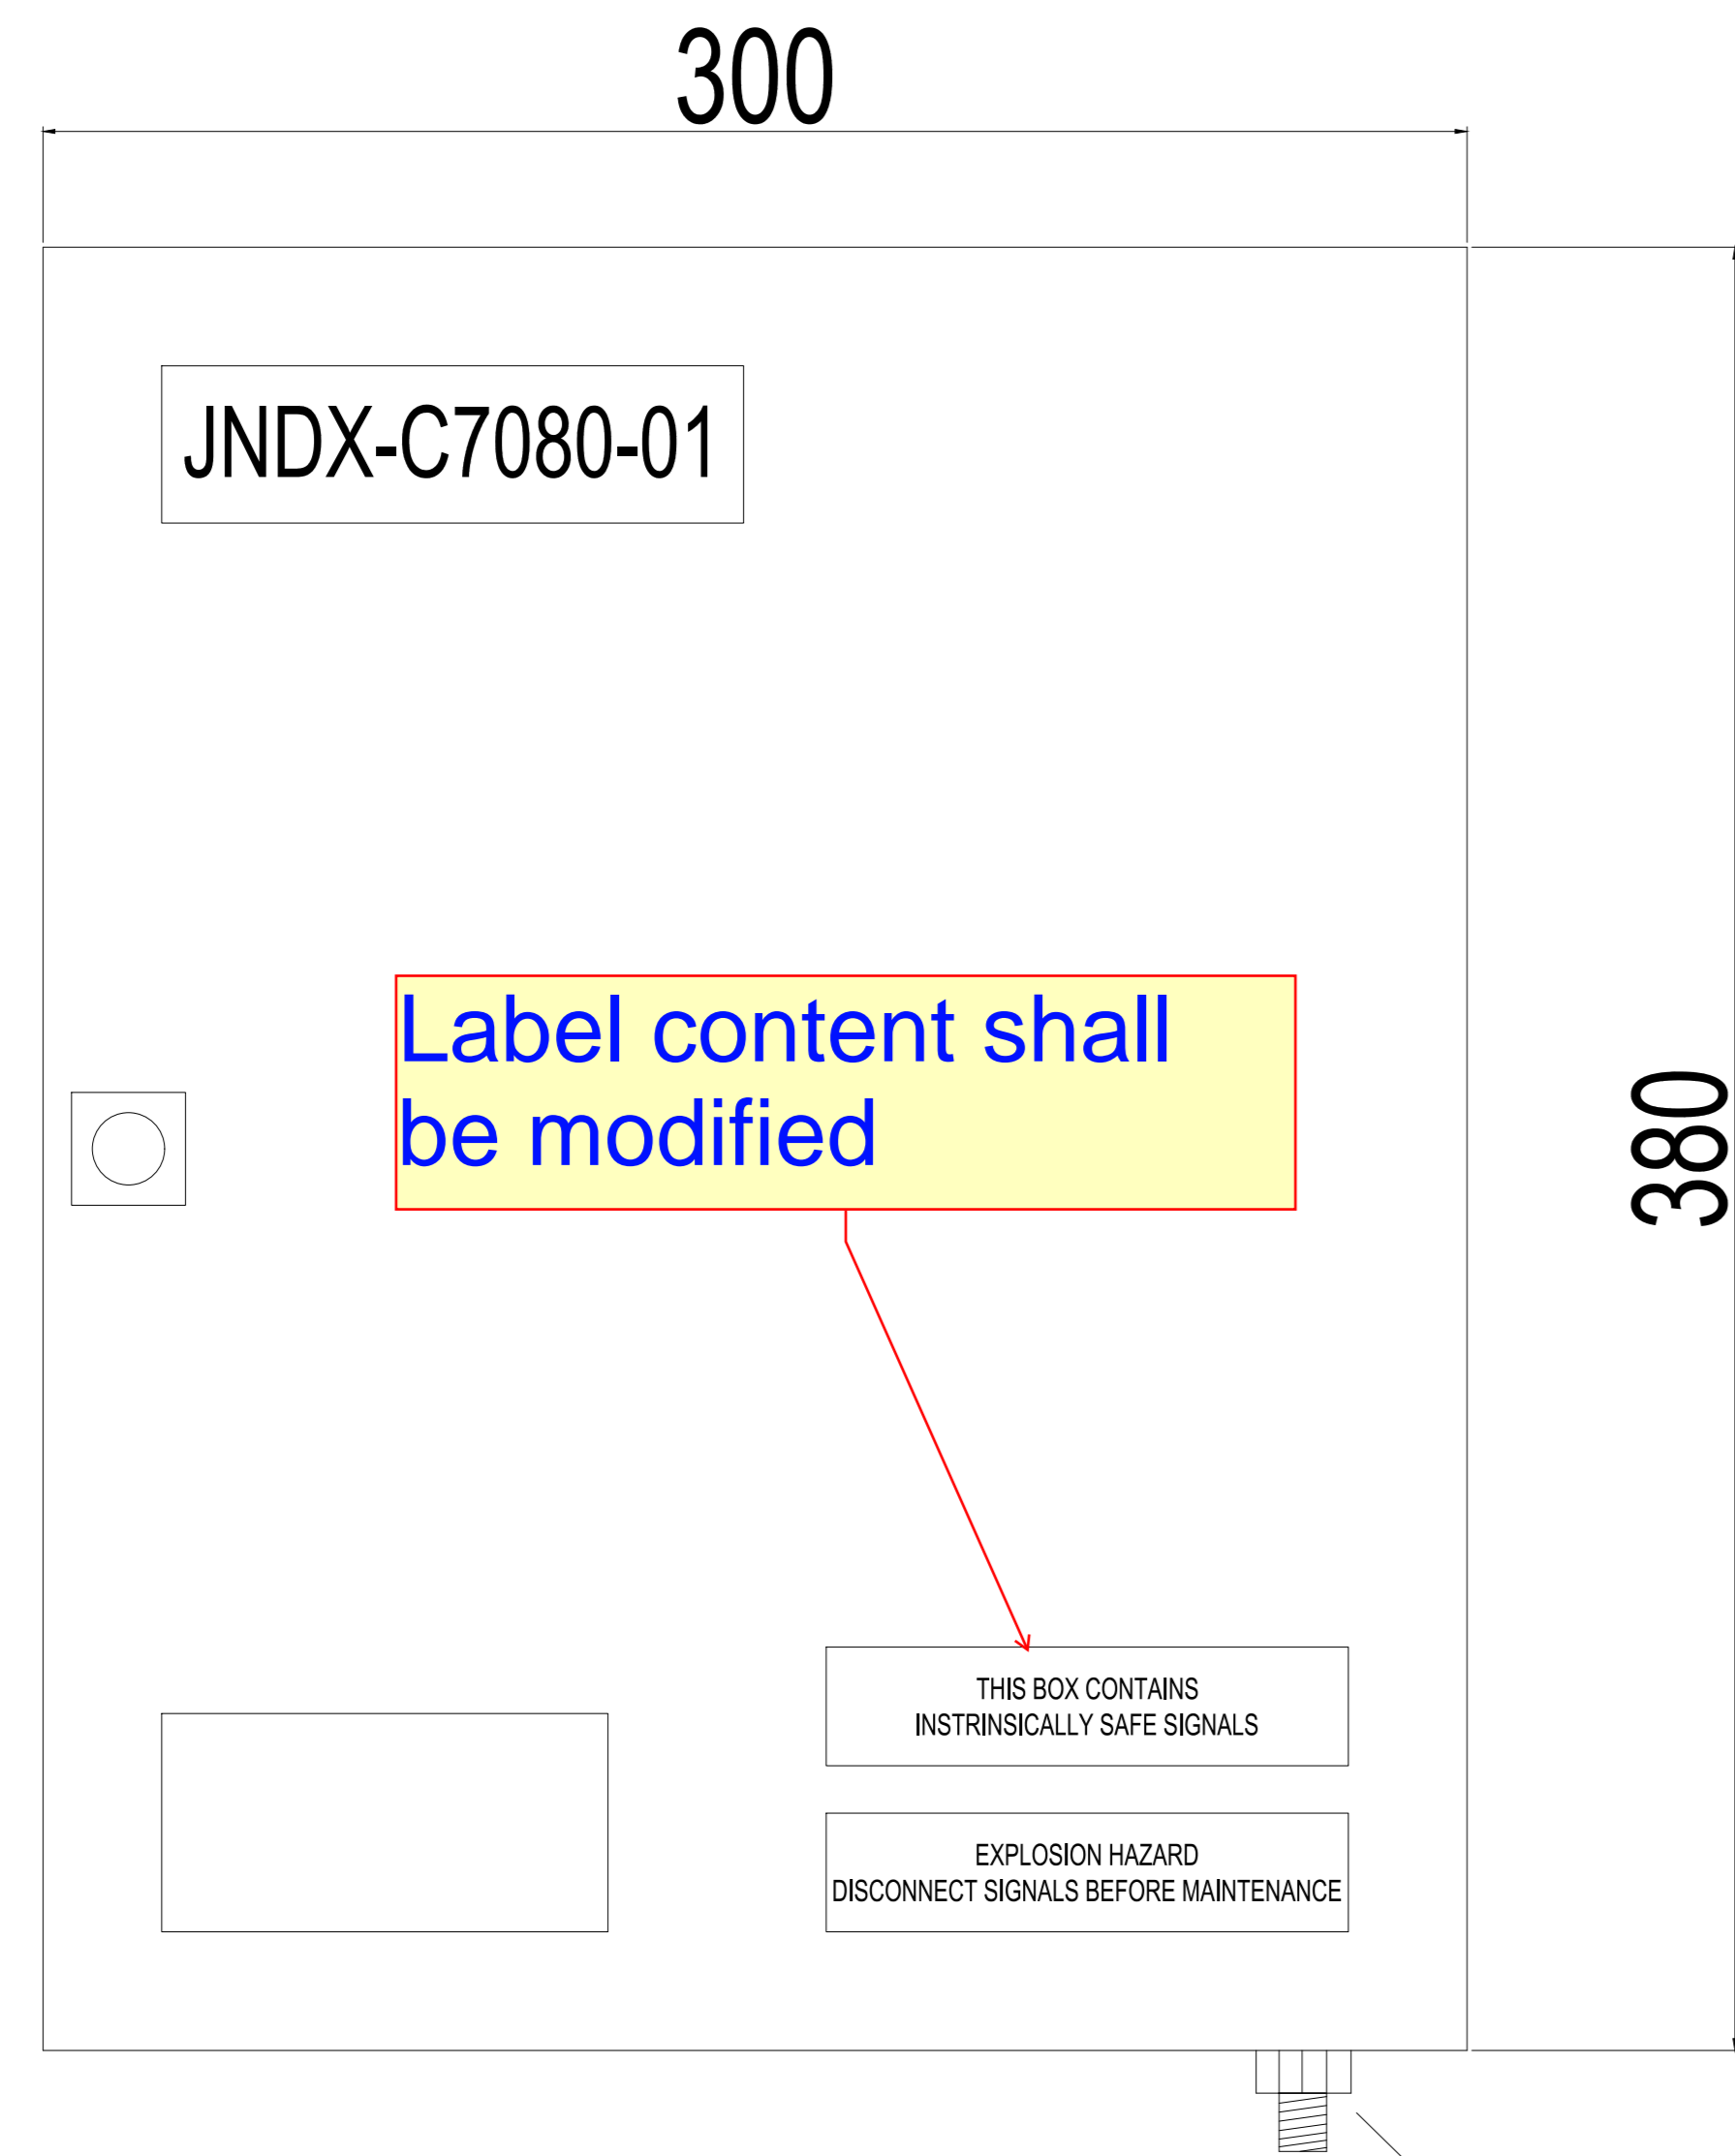


FRONT SIDE (INSIDE) VIEW

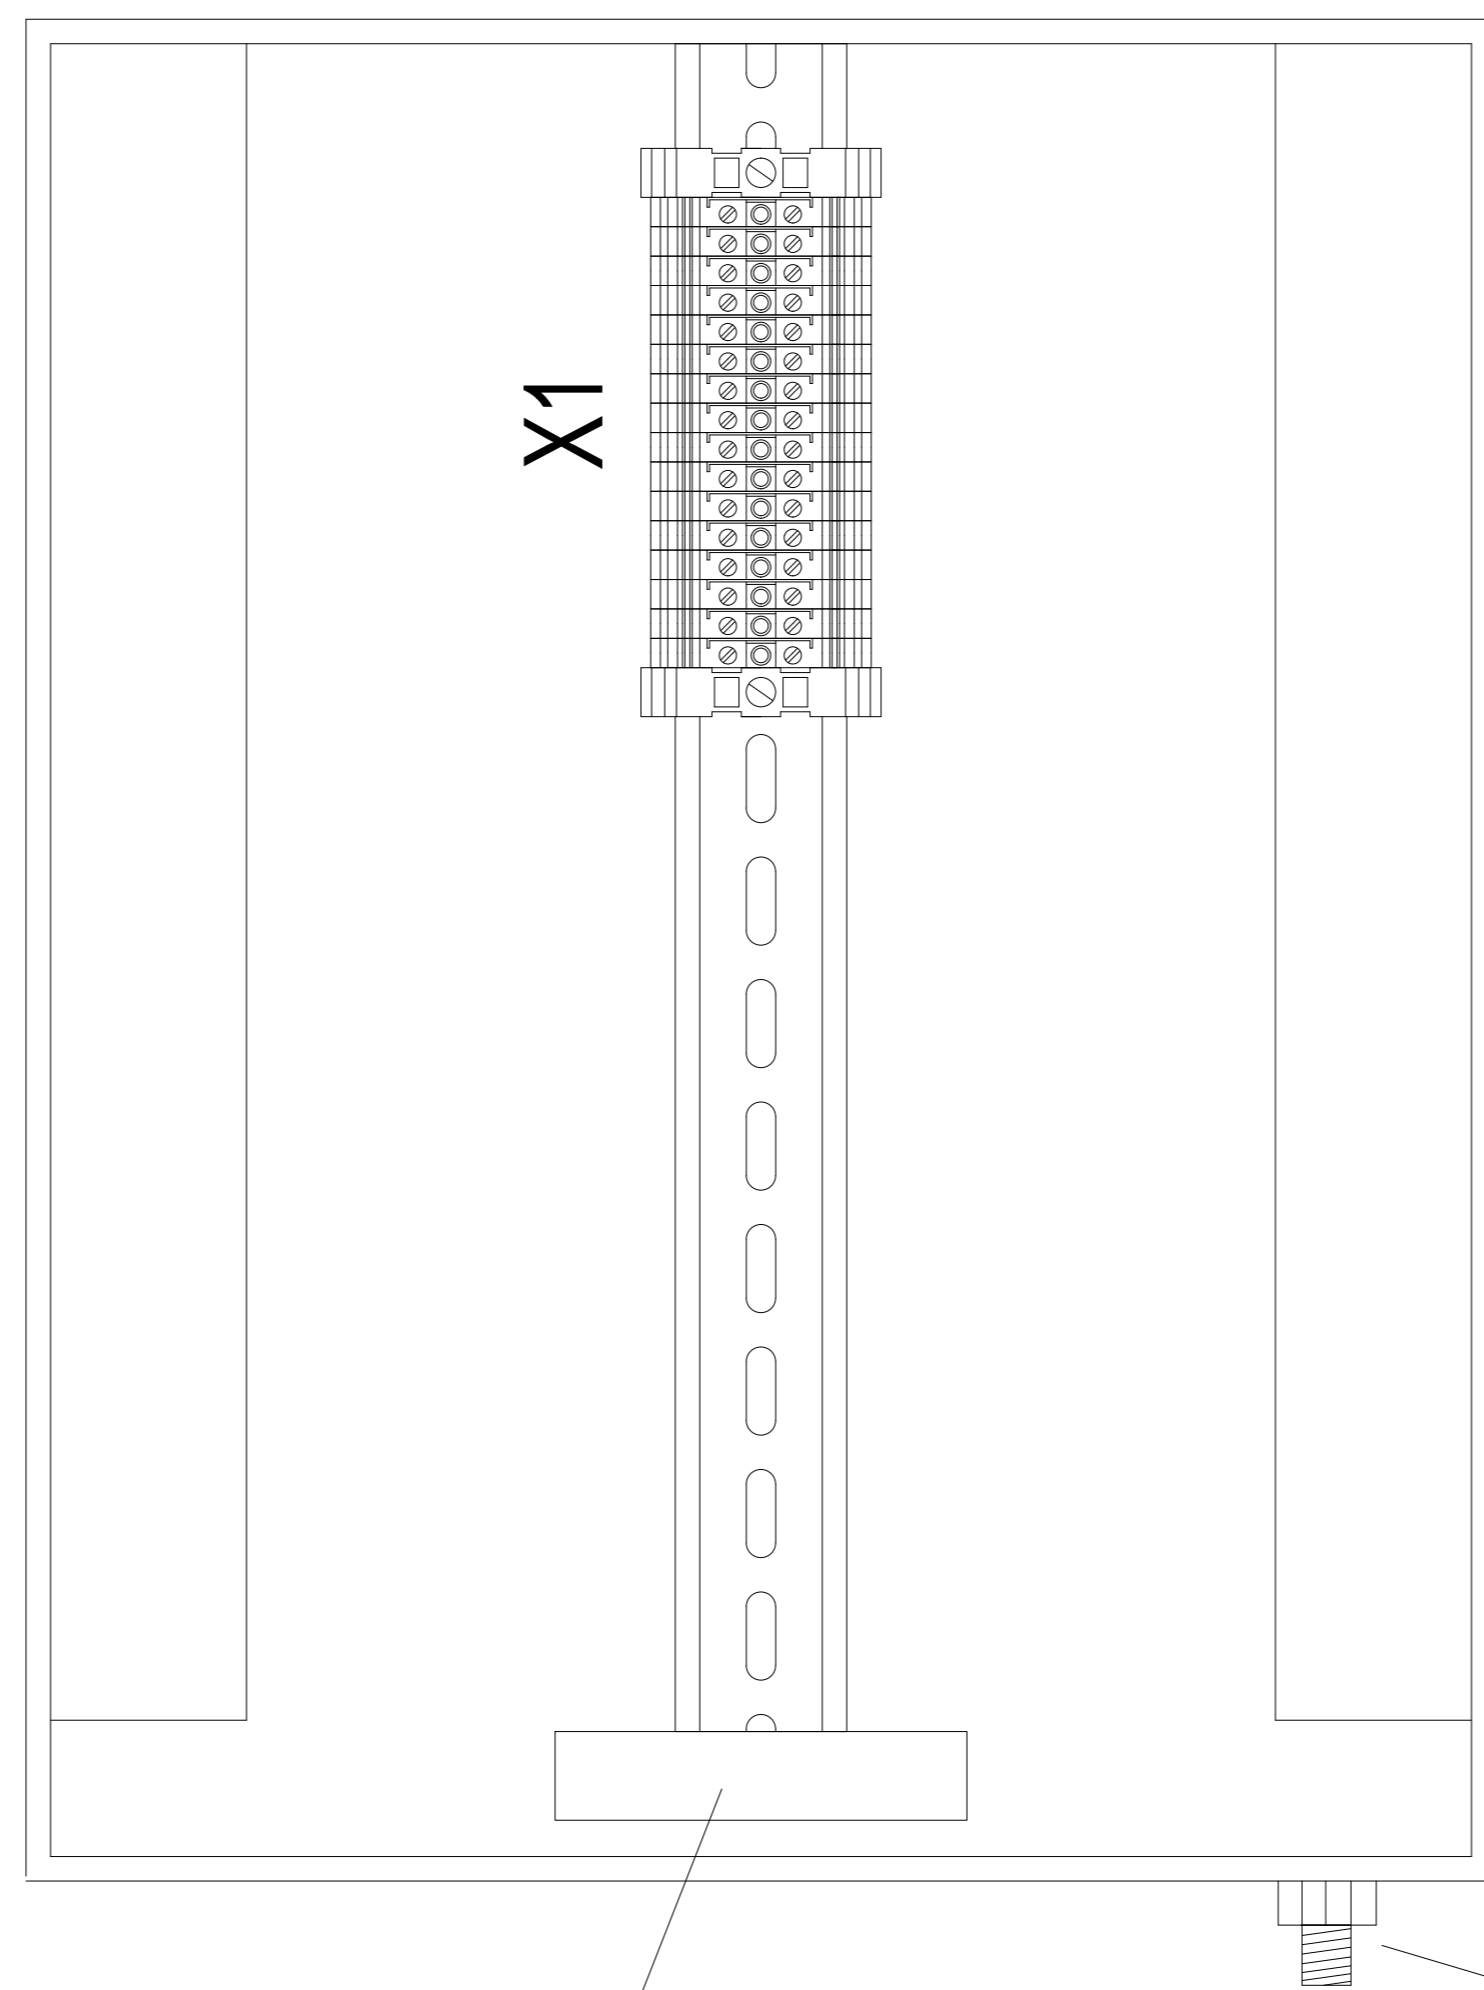

SIDE (OUTSIDE) VIEW

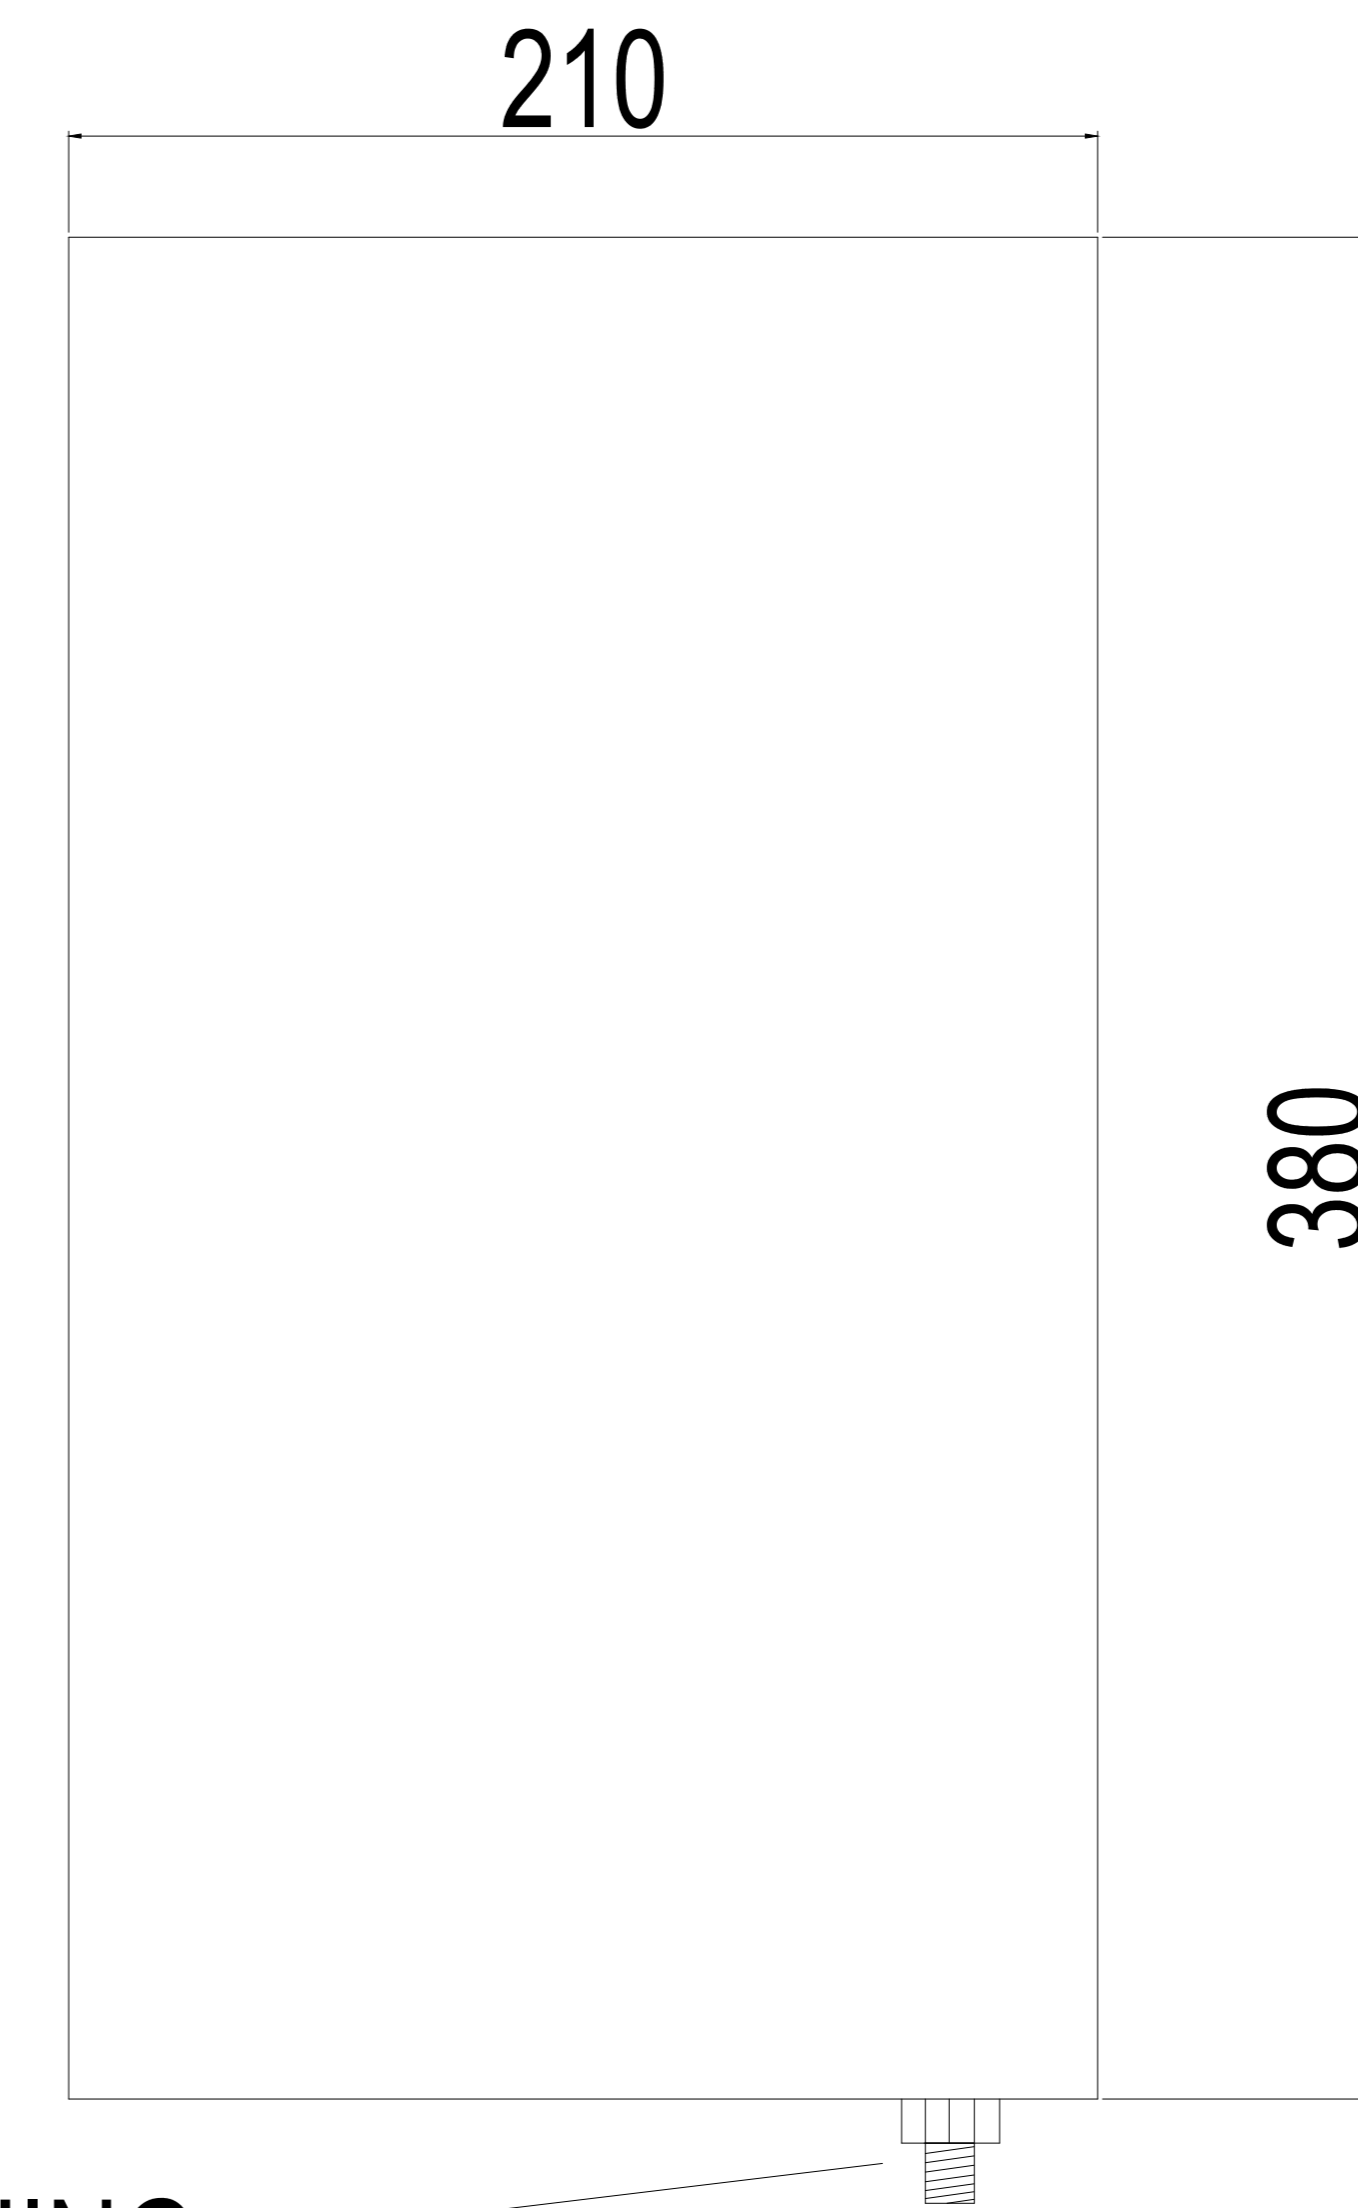

BOTTOM VIEW

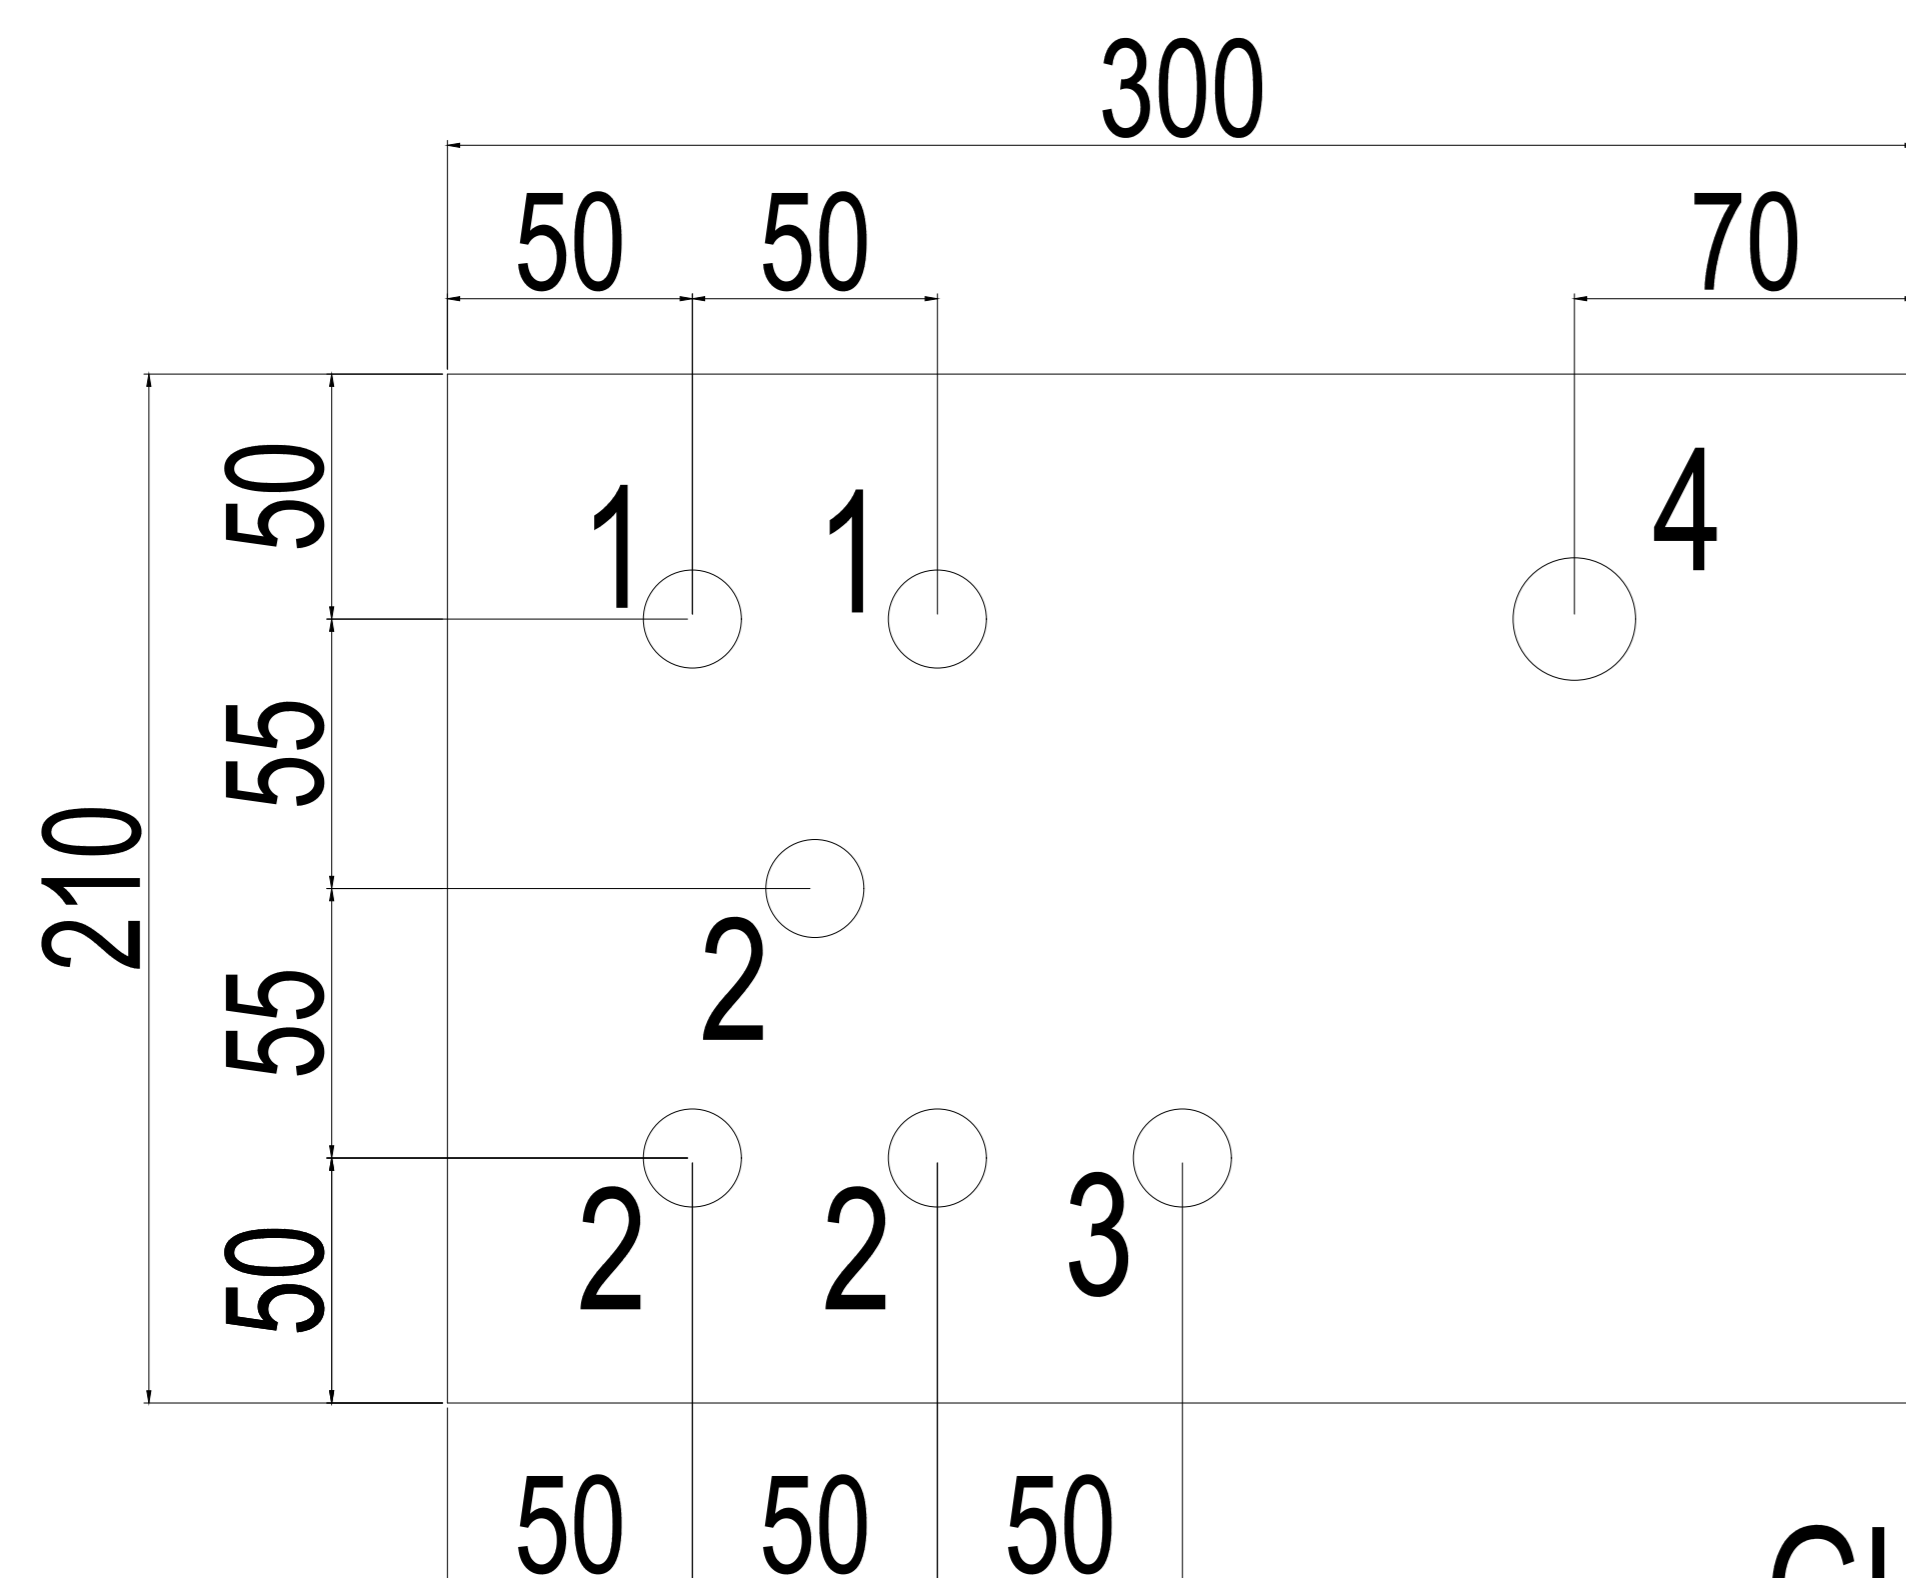

EARTHING BOSS M10

PE Bar


EARTHING BOSS M10

GLAND ENTRY DETAILS

- 1 = Solenoid cable - M20
- 2 = Spare plug - M20
- 3 = Breather / Drain - M20
- 4 = Solenoid multipair cable - M25


- M20: 1x (Breather)
- M20: 5x
- M25: 1x

Nameplate for junction box, ABS
White letters on red background

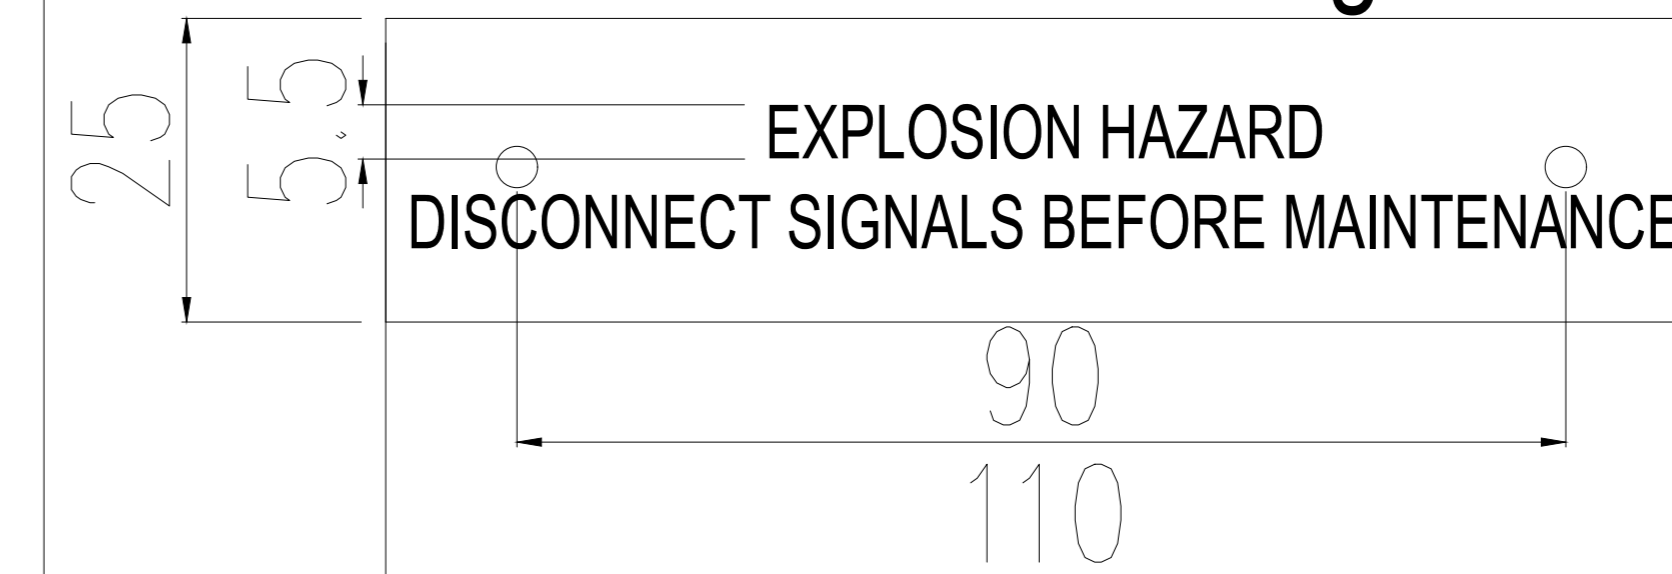


Terminal strip: X1
Make: Weidmuller
Qty: 16

Nameplate for junction box, ABS
White letters on red background

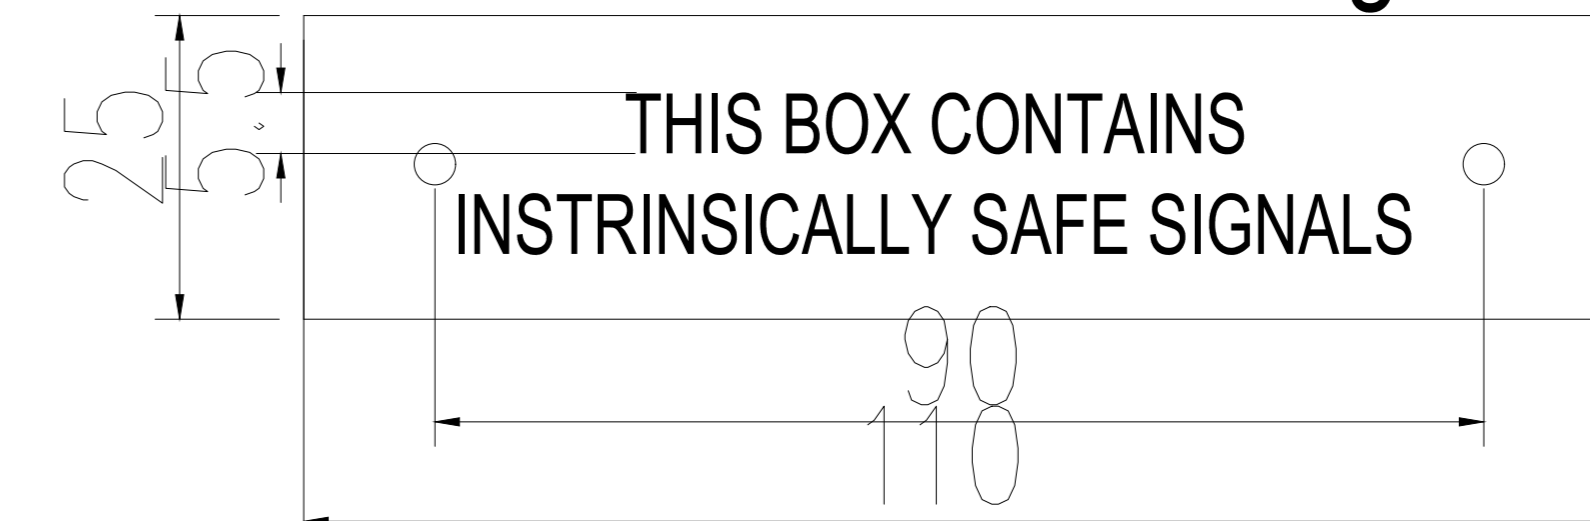

NAMEPLATE, 3:1, SS316 (typical)

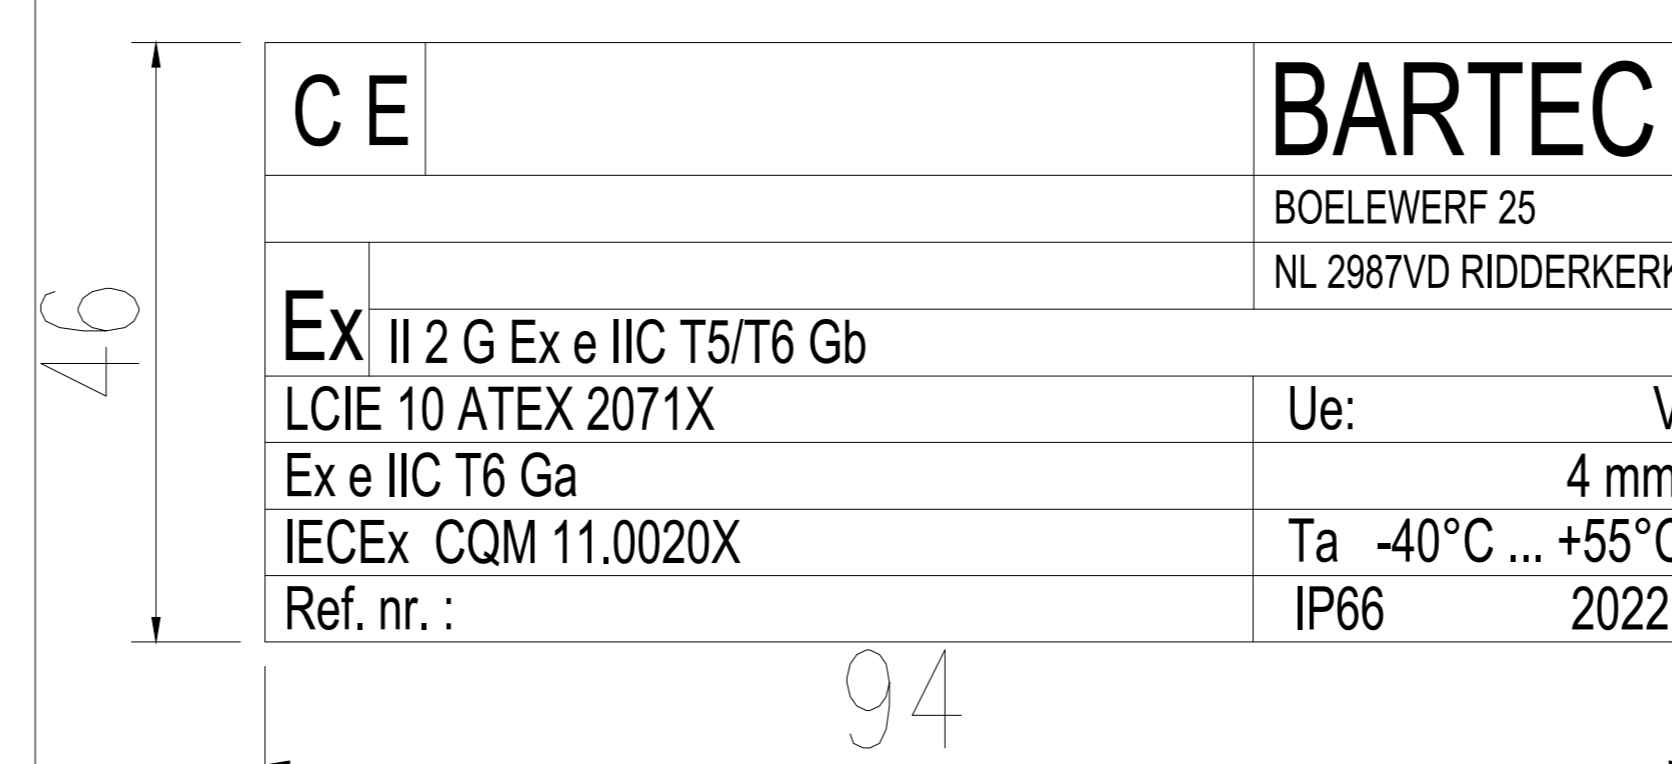

TAG.NO, 3:1, ABS
Black letters on white background



GENERAL NOTES

1. Panel material: SS316
2. Ingress protection: IP-65
3. Panel dimensions: 300x380x210 mm
4. Area classification: Eex 'e' (RAL 6021) Green
5. All spare holes are plugged with certified plugs

REFERENCE DRAWINGS	DWG.No.
WIRING DIAGRAM	BU-20-VD-303-IN-DIG-0093

REV.	DATE	PURPOSE OF ISSUE (P.O.I.)	PREP.	CHKD.	APPR.	AC.
05	26/09/22	For approval	RT	RB	RB	I
04	04/08/22	For approval	BK	RB	RB	I
03	15/06/22	For approval	BK	RB	RB	I
02	14/12/21	For approval	HT	RB	RB	I
01	19/10/21	For approval	HT	RB	RB	I
00	24/11/20	For approval	HT	RB	RB	I

OWNER:	MC:	CONTRACTOR:

PROJECT: BUSHEHR PETROCHEMICAL COMPANY
MEG PLANT

DRAWING TITLE: 17811-07B


UCL/LOP/IB GENERAL ARRANGEMENT DRAWING & TERMINAL DETAILS FOR EMERGENCY INSTRUMENT AIR COMPRESSOR

CONTRACT NO.	SCALE	SIZE	CLASS	PHASE		
52-98/445	XX	A0	1	P		
DOCUMENT NO.	PROJECT AREA	PHASE MRO No.	DIS.	DOC. SEQ.	SHEET NO.	REV. NO.
BU-20-VD-303-IN-DWG-0089					3 OF 6	05

OTHER USE OF THE DOCUMENT IN WHOLE OR IN PART, OR A MODIFICATION TO BE MADE WITHOUT THE WRITTEN CONSENT OF B.U.P.C.


JIAX-C7080-01

FRONT SIDE (OUTSIDE) VIEW

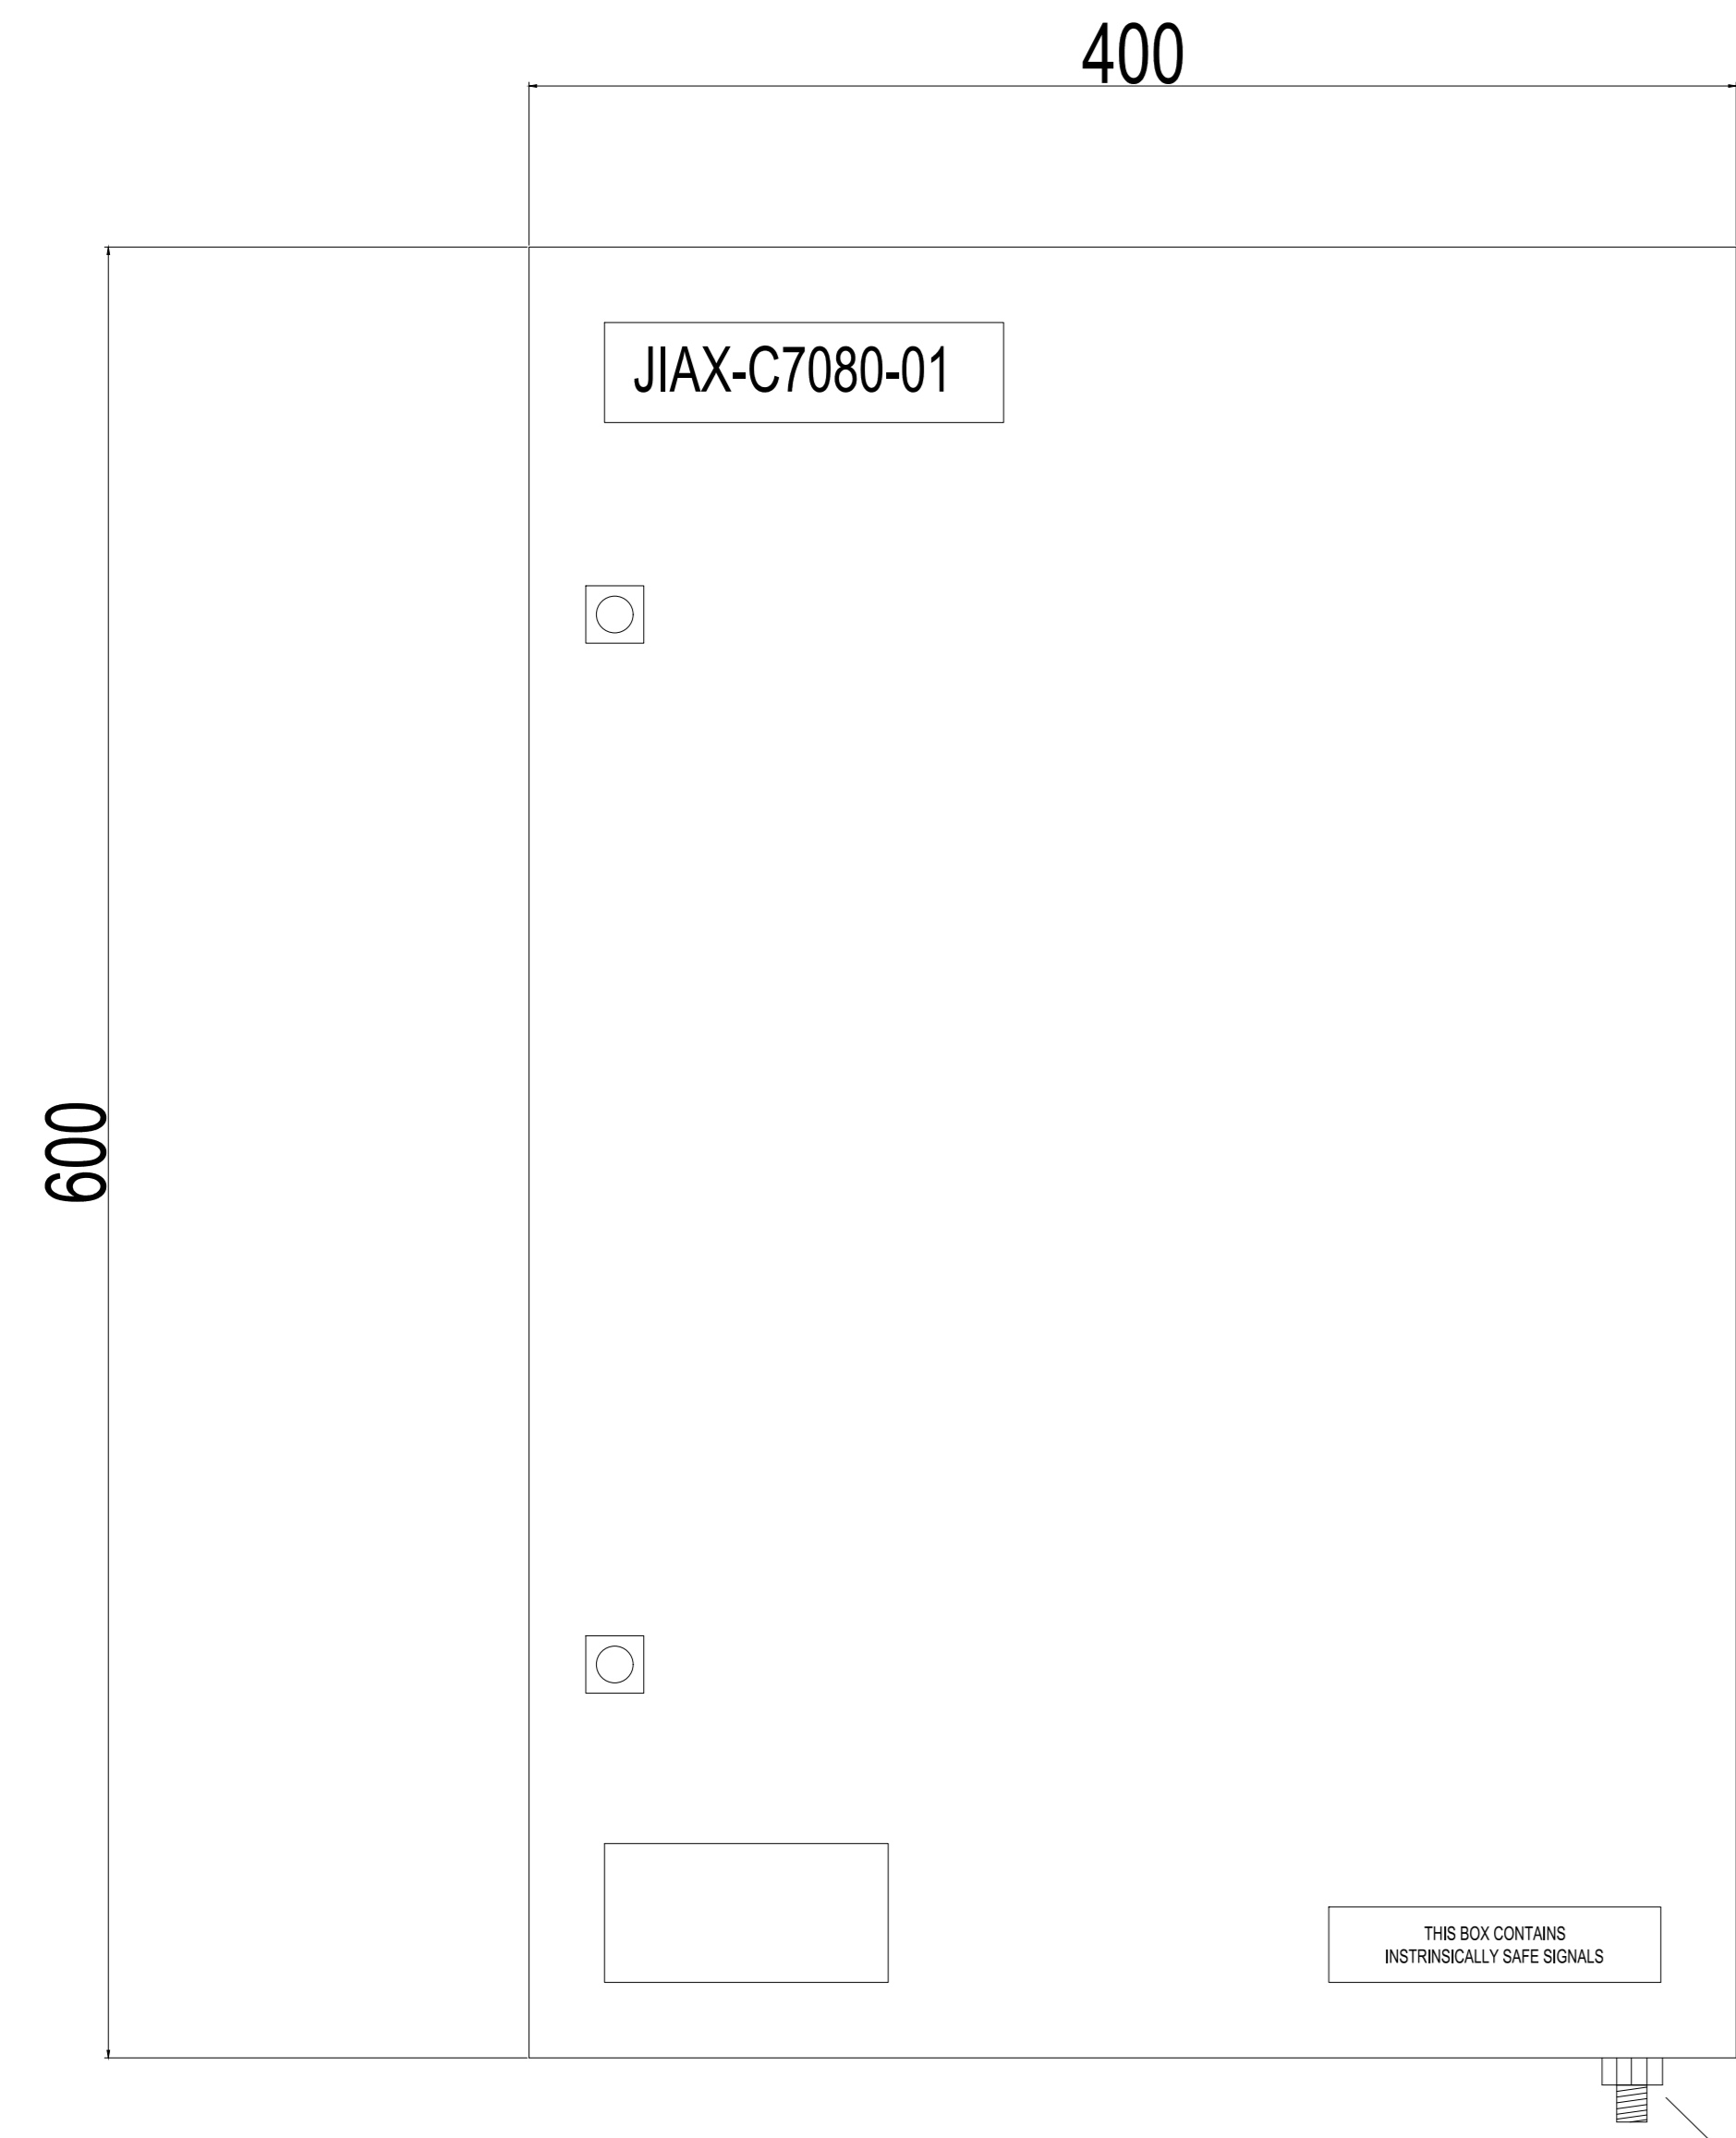

EARTHING BOSS M10


FRONT SIDE (INSIDE) VIEW

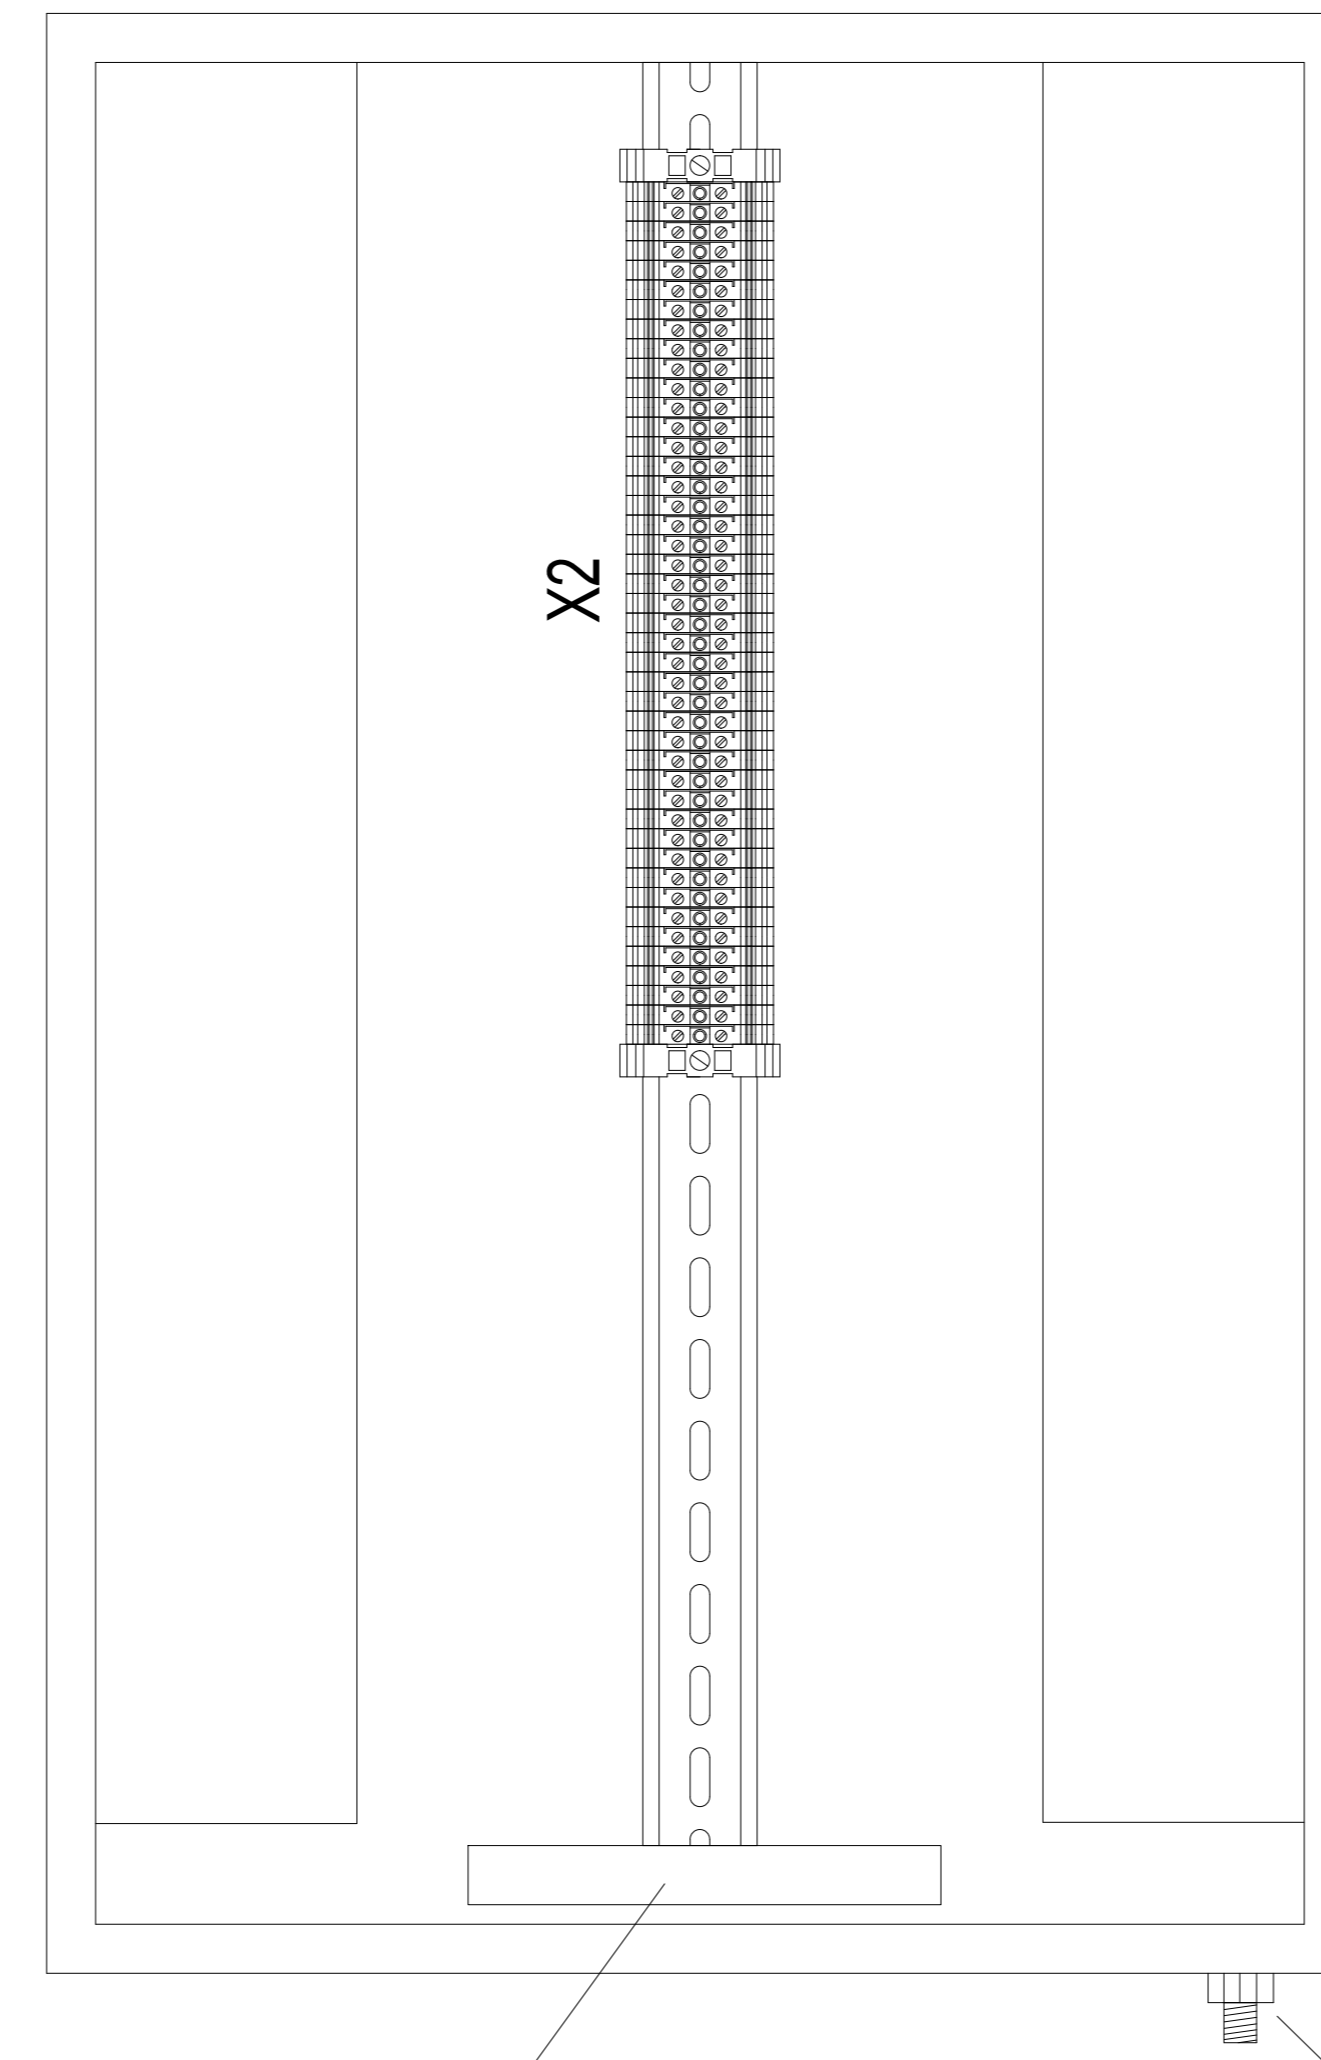

ISE Bar


EARTHING BOSS M10

SIDE (OUTSIDE) VIEW

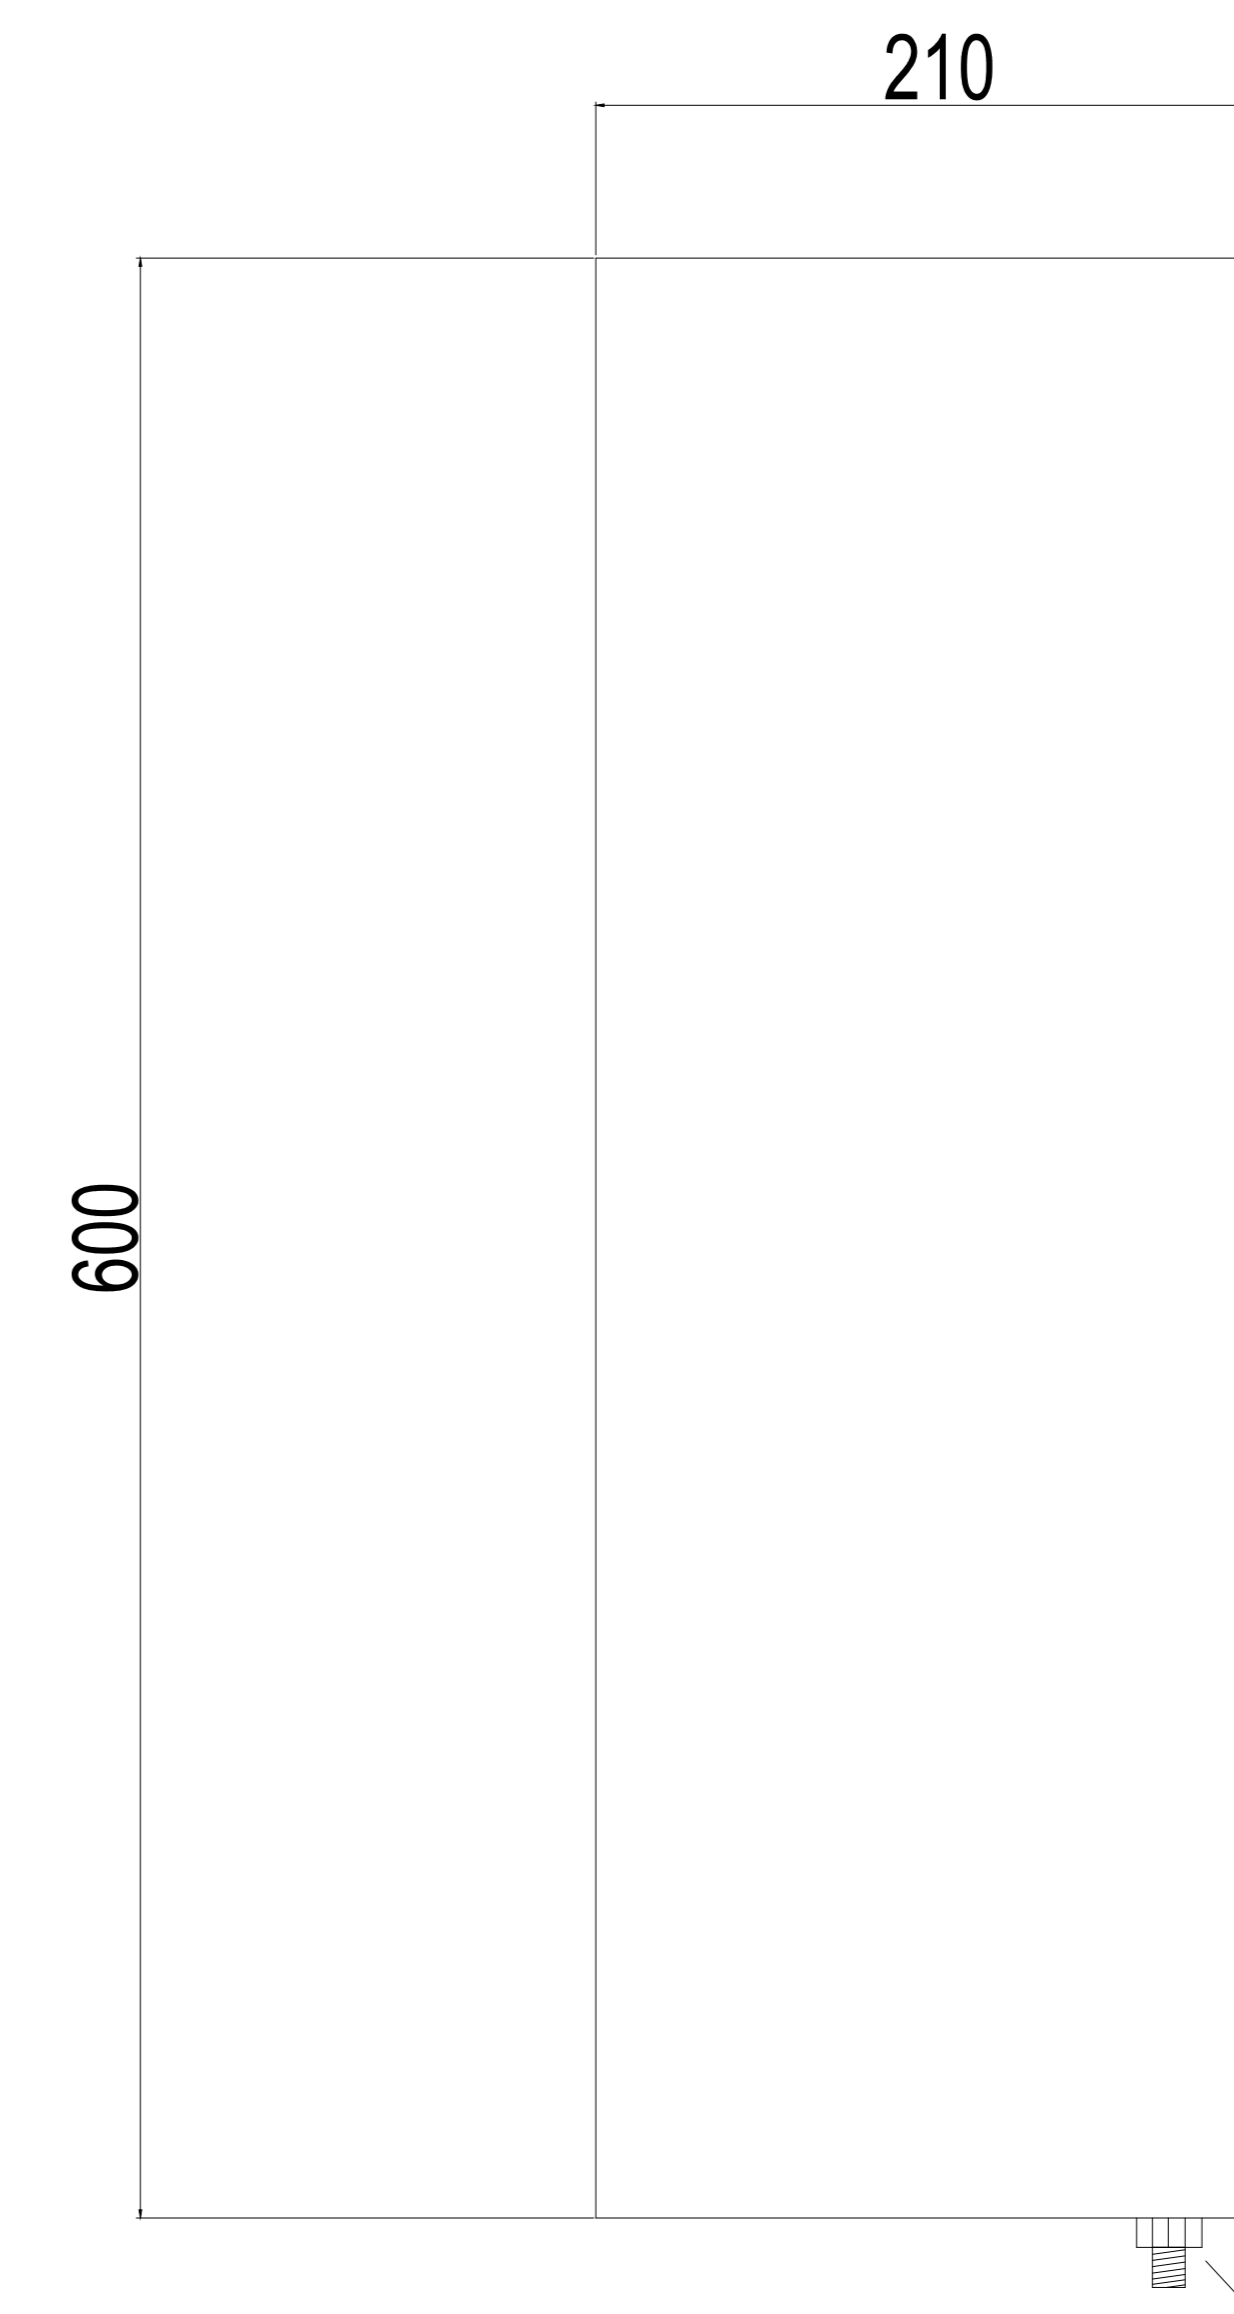

EARTHING BOSS M10

BOTTOM VIEW

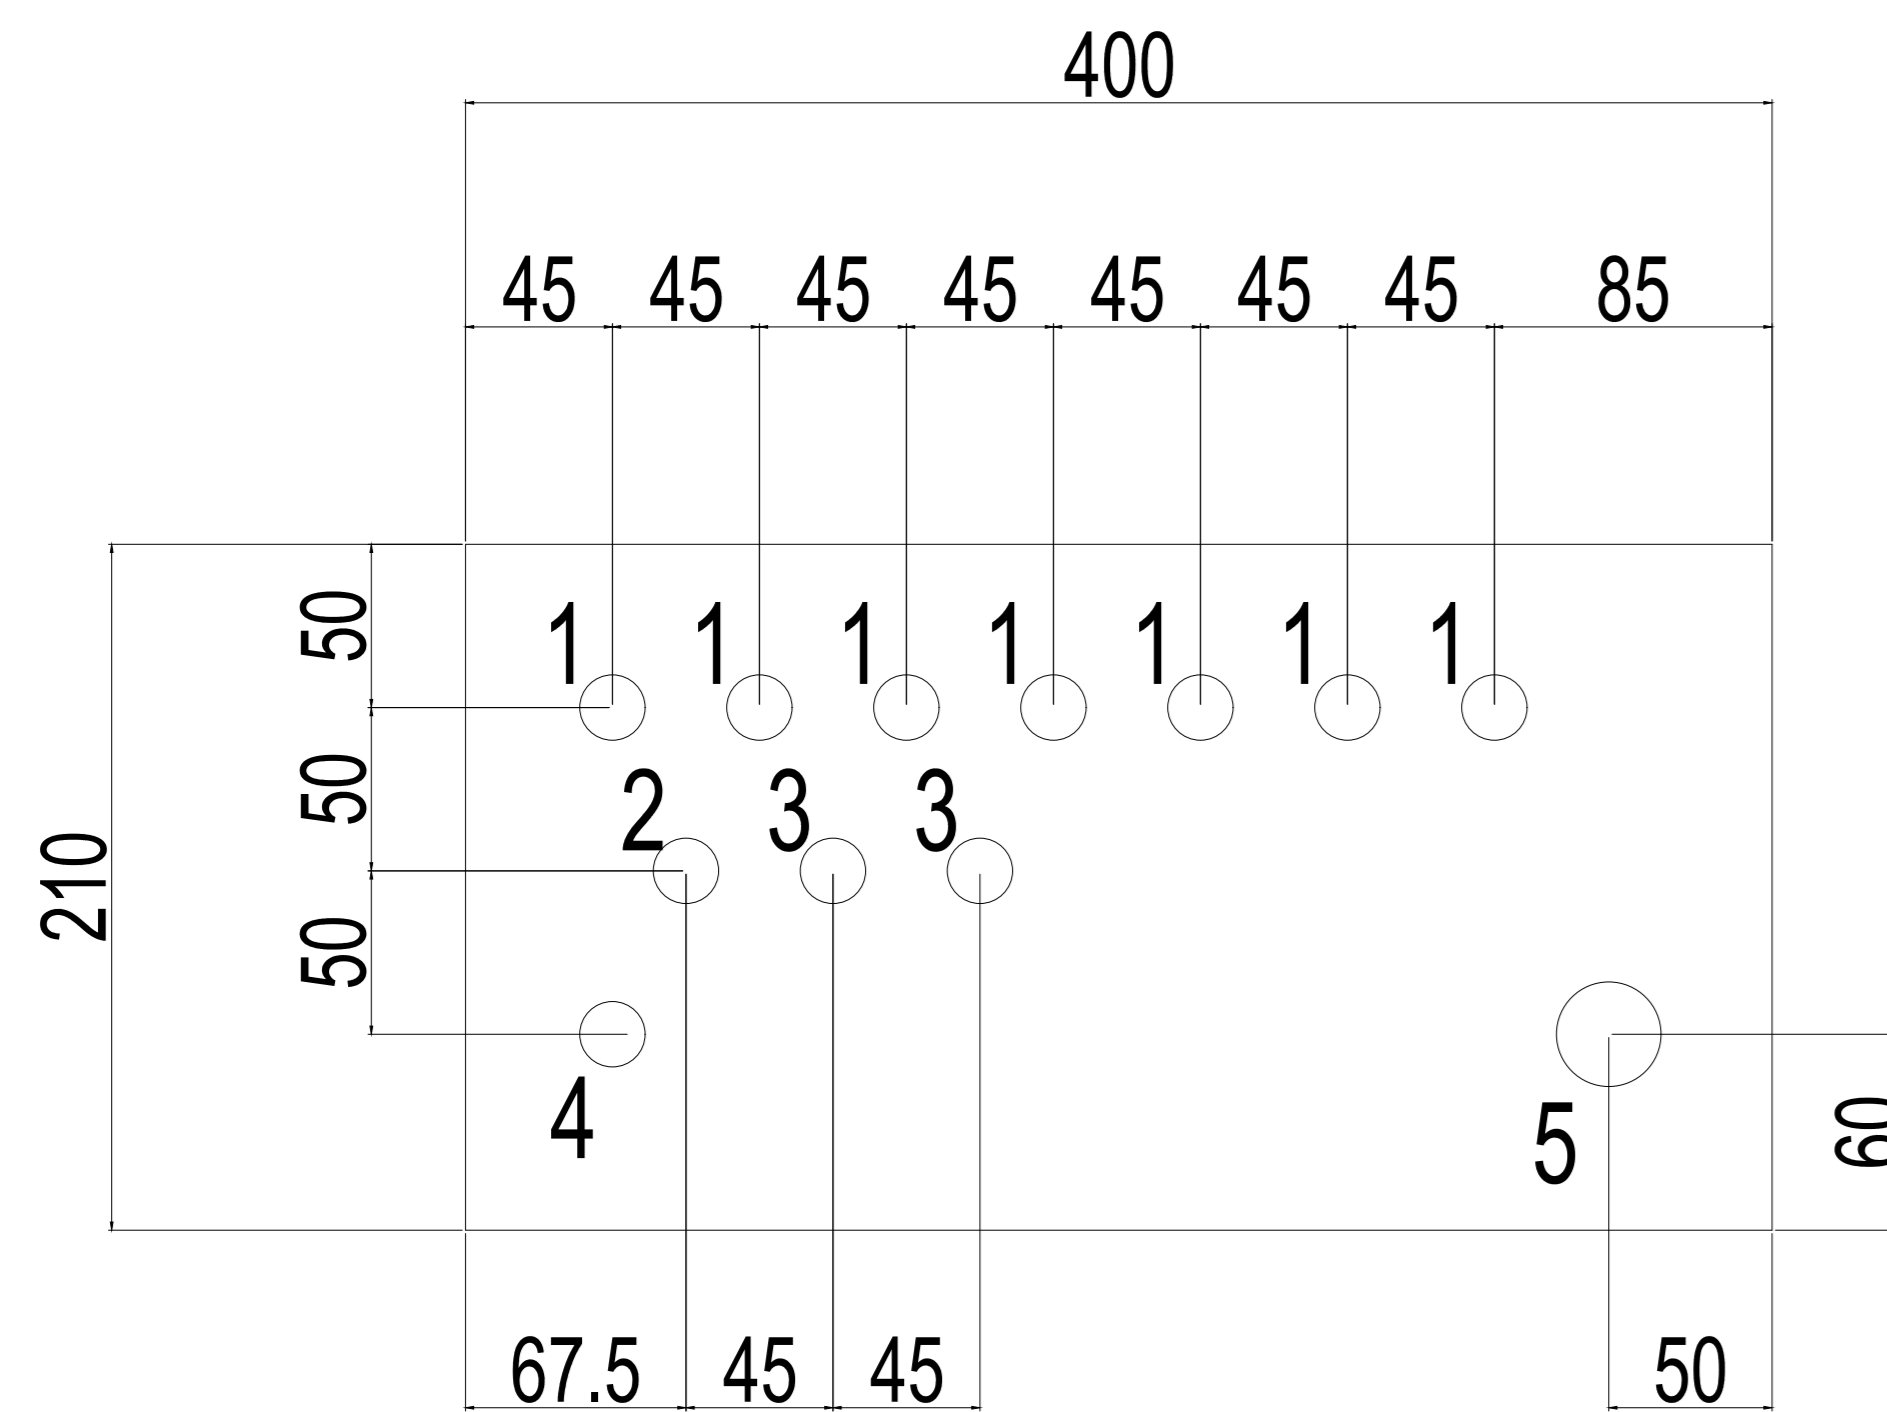


- 1 = Transmitter cable - M20
- 2 = PCV cable - M20
- 3 = Spare plug - M20
- 4 = Breather / Drain - M20
- 5 = Transmitter/PCV multipair cable - M32

GLAND ENTRY DETAILS


- M20: 1x (Breather)
- M20: 10x
- M32: 1x

Terminal strip: X2
Make: Weidmuller
Qty: 44

Nameplate for junction box, ABS
Black letter on white background

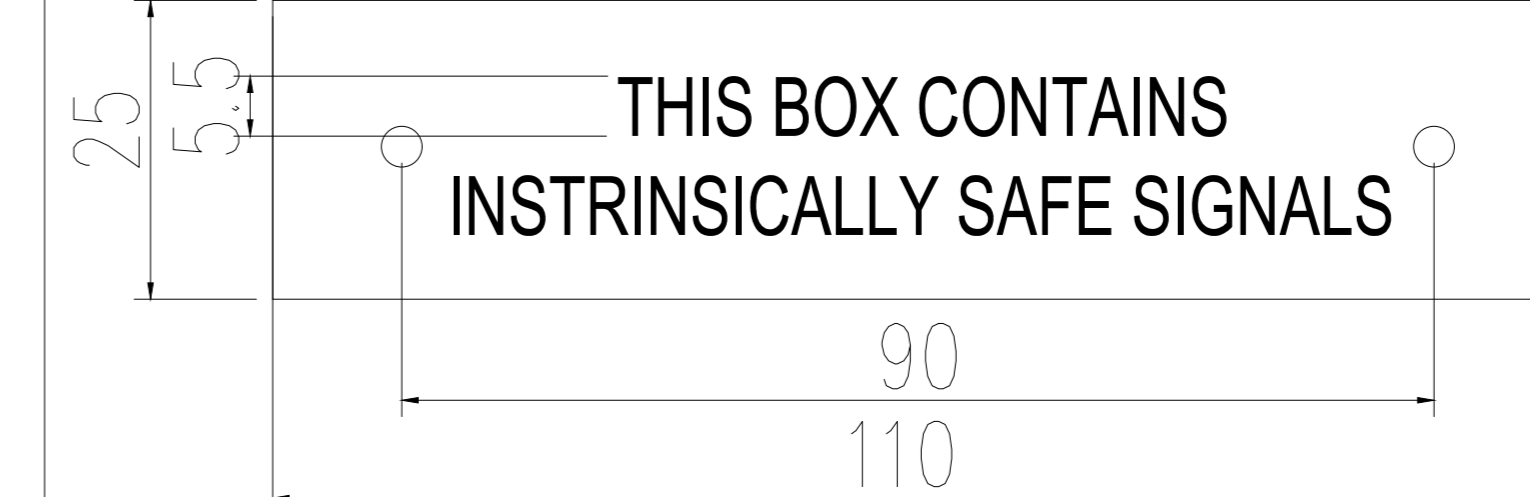

NAMEPLATE, 3:1, SS316 (typical)

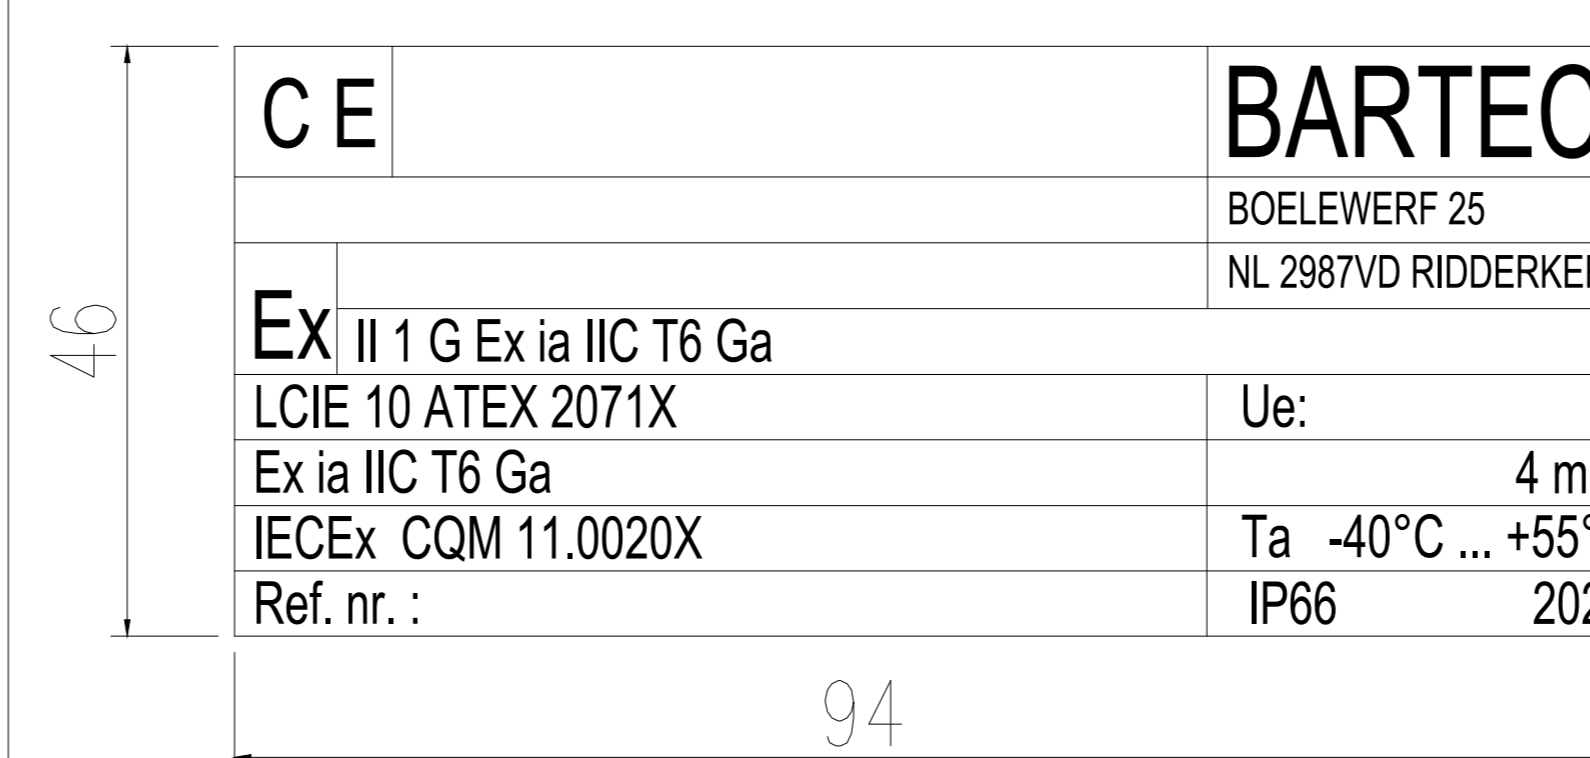

TAG.NO, 3:1, ABS
Black letters on white background



GENERAL NOTES

1. Panel material: SS316
2. Ingress protection: IP-65
3. Panel dimensions: 400x600x210 mm
4. Area classification: Eex 'i' (RAL 5015) Blue
5. All spare holes are plugged with certified plugs

REFERENCE DRAWINGS	DWG.No.
WIRING DIAGRAM	BU-20-VD-303-IN-DIG-009.3

REV.	DATE	PURPOSE OF ISSUE (P.O.I.)	PREP.	CHKD.	APPR.	AC.
05	26/09/22	For approval	RT	RB	RB	I
04	04/08/22	For approval	HT	BK	RB	I
03	15/06/22	For approval	HT	BK	RB	I
02	14/12/21	For approval	HT	RB	RB	I
01	19/10/21	For approval	HT	RB	RB	I
00	24/11/20	For approval	HT	RB	RB	I

OWNER:	MC:	CONTRACTOR:

PROJECT: BUSHEHR PETROCHEMICAL COMPANY MEG PLANT

DRAWING TITLE: 17811-07B

UCP/LCP/JB GENERAL ARRANGEMENT DRAWING & TERMINAL DETAILS FOR EMERGENCY INSTRUMENT AIR COMPRESSOR

CONTRACT NO.	SCALE	SIZE	CLASS	PHASE		
52-98/445	XX	A0	1	P		
DOCUMENT NO.	PROJECT AREA	PHASE MRO No.	DIS.	DOC. SEQ.	SHEET NO.	REV. NO.
BU-20-VD-303-IN-DWG-009.3					4 OF 6	05

THIS DRAWING IS THE PROPERTY OF AIRPACK. IT IS TO BE USED ONLY FOR THE PROJECT AND NOT BE REPRODUCED OR COPIED IN ANY FORM OR BY ANY MEANS WITHOUT THE WRITTEN CONSENT OF AIRPACK.

Nr	Description	Tagnumber	Make	Qty	Modelnumbers
1.	Operational lamp (green)	3H4	Schneider	1	XB4BVB3
2.	Running lamp (green)	3H6	Schneider	1	XB4BVB3
3.	Common alarm lamp (amber)	3H8	Schneider	1	XB4BVB5
4.	Common trip lamp (red)	3H10	Schneider	1	XB4BVB4
5.	Start pushbutton (green)	2S4	Schneider	1	XB4BA31
6.	Stop pushbutton (red)	2S6	Schneider	1	XB4BA42
7.	Lamp test pushbutton (black)	2S8	Schneider	1	XB4BA21
8.	Selector switch (local/off/remote)	2S10	Schneider	1	-
9.	ESD button	4S3	Schneider	1	-




GENERAL NOTES

1. Tag numbers correspond with electrical diagram
2. All the parts that are on the list in the panel layout will be included in the IOM.

REFERENCE DRAWINGS	DWG.No.
WIRING DIAGRAM	BU-20-VD-303-IN-DIG-0093

Nr	Description	Tagnumber	Make	Qty	Modelnumbers
X5	Terminal strip	X5...,	Weidmuller	26	WDU4
X9	Terminal strip	X9...,	Weidmuller	8	WDU4

REV.	DATE	PURPOSE OF ISSUE (P.O.I.)	PREP.	CHKD.	APPR.	AC.
05	26/09/22	For approval	RT	RB	RB	I
04	04/08/22	For approval	BK	RB	RB	I
03	15/06/22	For approval	BK	RB	RB	I
02	14/12/21	For approval	HT	RB	RB	I
01	19/10/21	For approval	HT	RB	RB	I
00	24/11/20	For approval	HT	RB	RB	I

OWNER:  MC:  CONTRACTOR: 

PROJECT:
DRAWING TITLE: **17811-07B**
UCP/LOP/IB GENERAL ARRANGEMENT DRAWING & TERMINAL DETAILS FOR EMERGENCY INSTRUMENT AIR COMPRESSOR

CONTRACT NO.	SCALE	SIZE	CLASS	PHASE					
52-98/445	XX	A0	1	P					
DOCUMENT NO.	PROJECT	AREA	PHASE	MRO No.	DIS.	DOC.	SEQ.	SHEET	REV. NO.
OWNER DOC. NO.: BU-20-VD-303-IN-DWG-0089								5 OF 6	05

THIS DRAWING IS THE PROPERTY OF NATIONAL PETROCHEMICAL COMPANY. IT IS TO BE USED ONLY FOR THE PROJECT AND NOT BE REPRODUCED OR COPIED IN ANY FORM OR BY ANY MEANS WITHOUT THE PRIOR CONSENT OF NATIONAL PETROCHEMICAL COMPANY.

